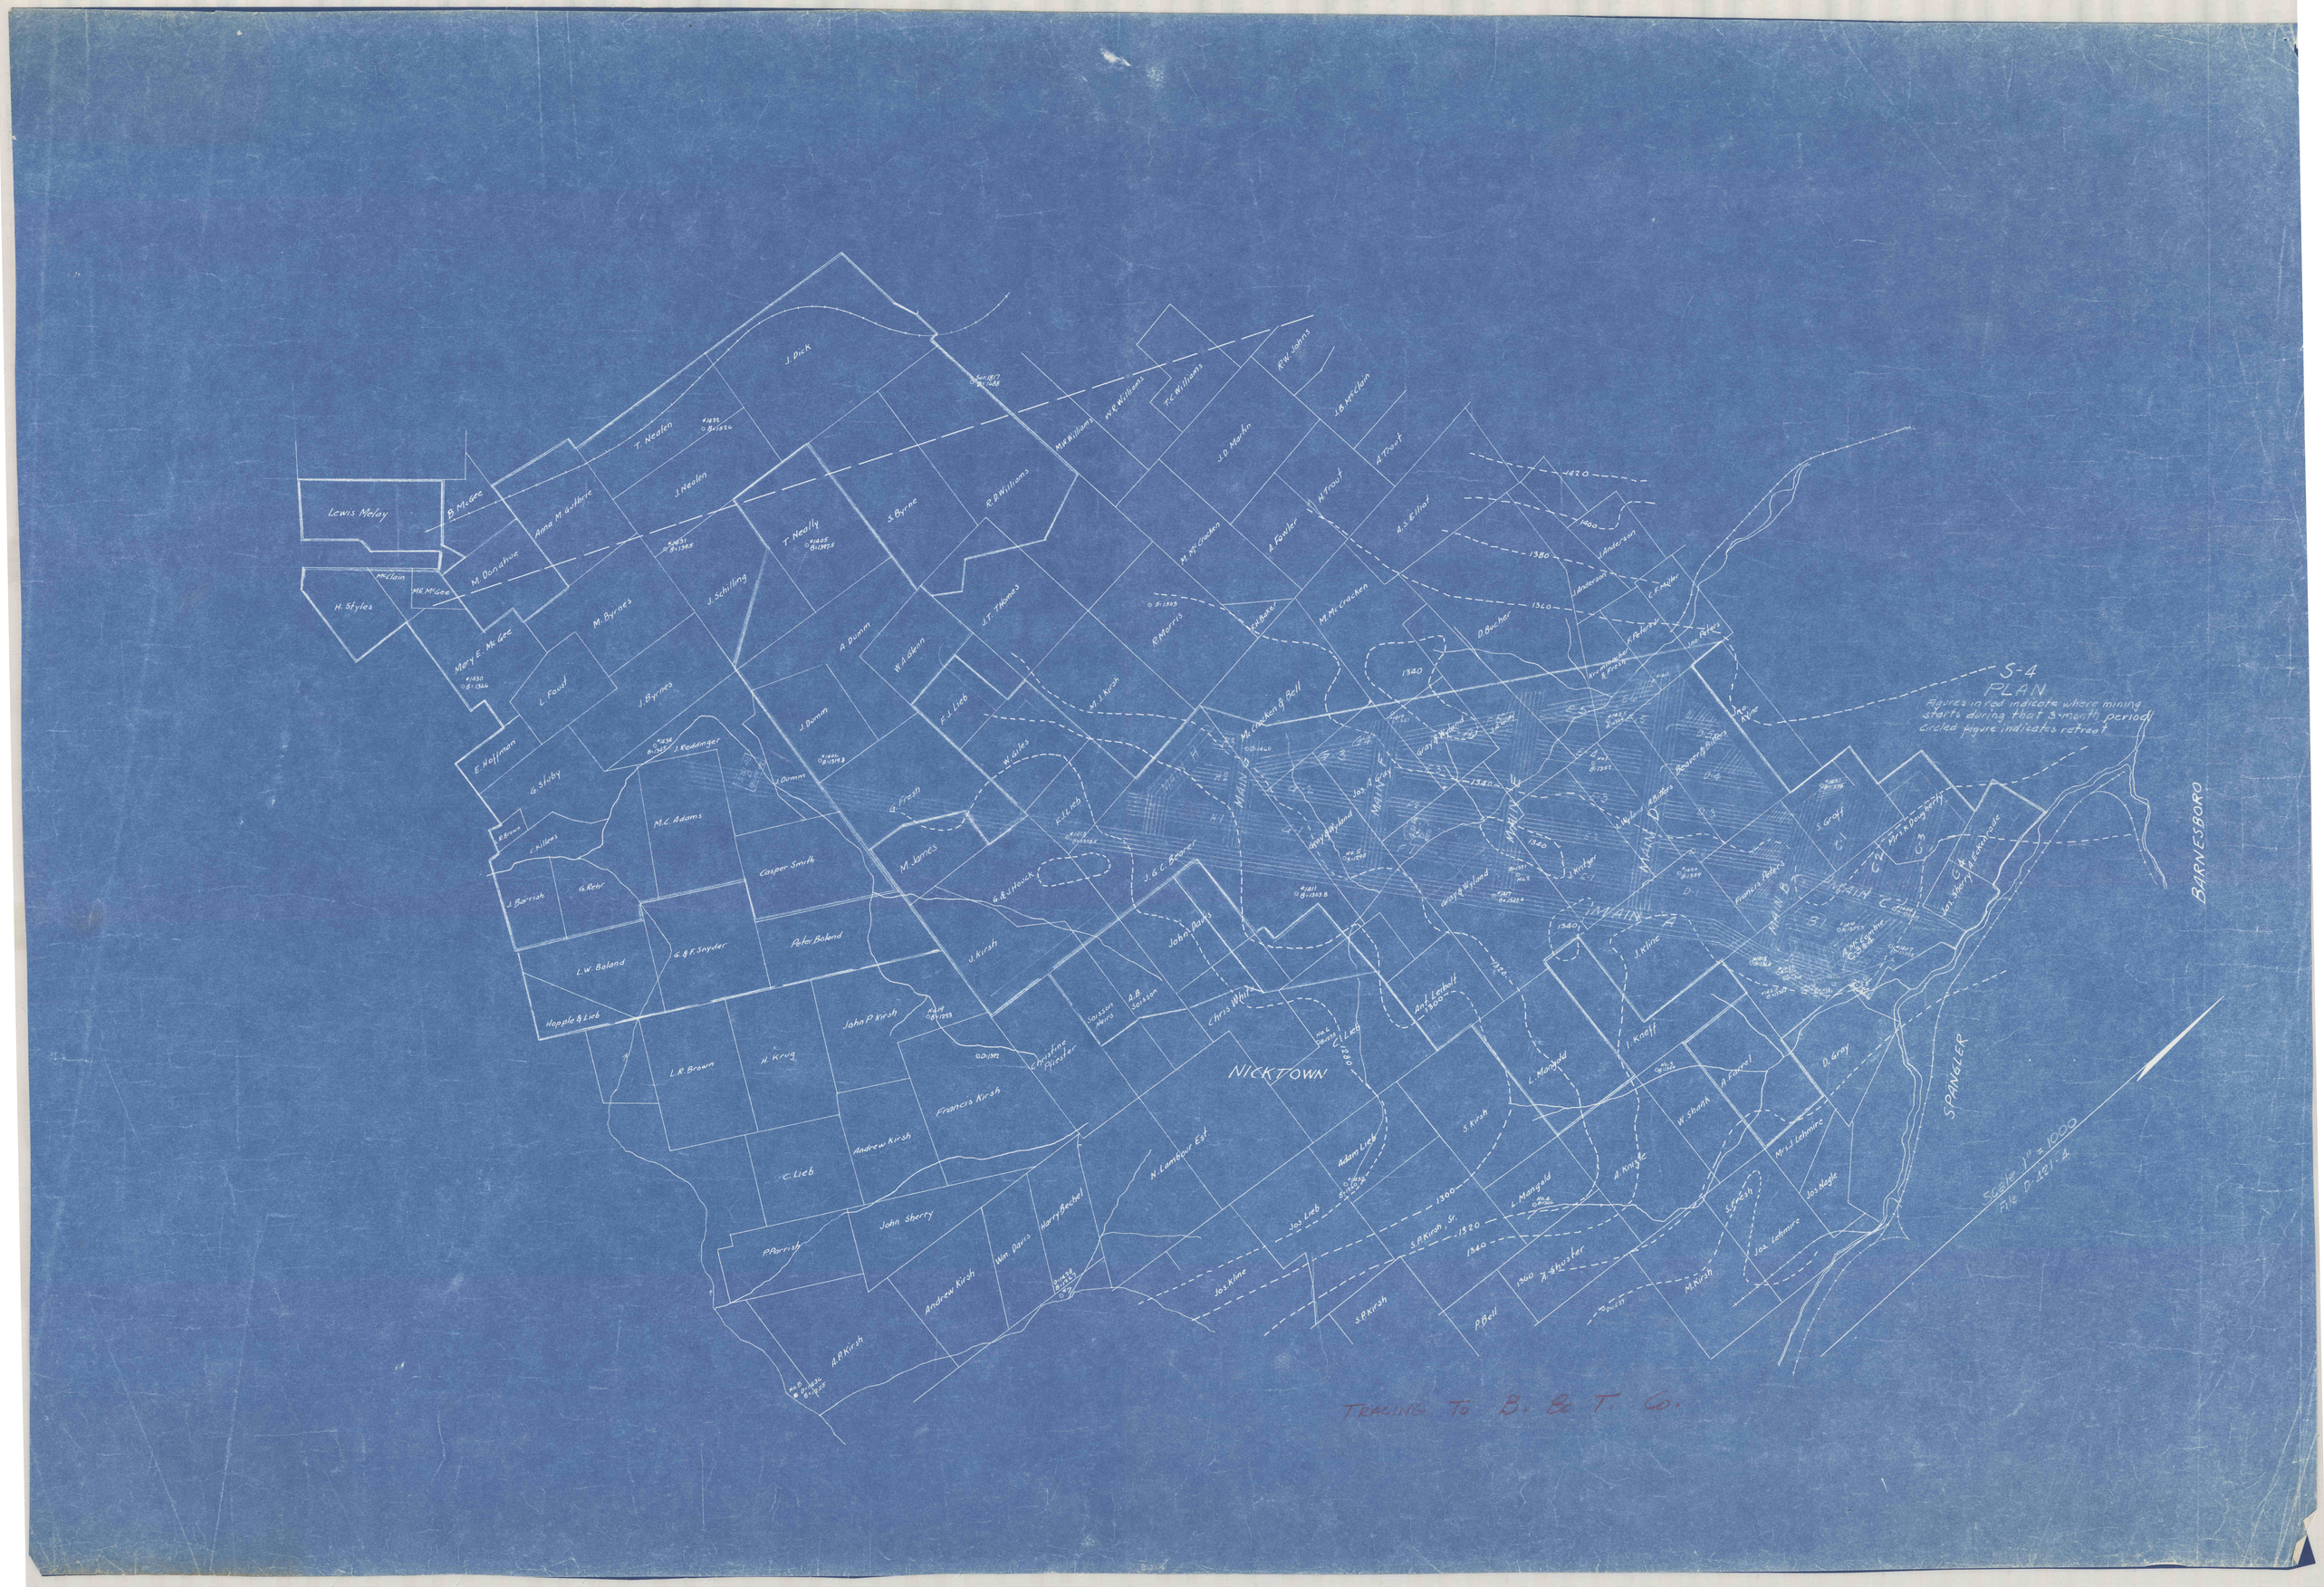
S-4
PLAN
Figures in red indicate where mining starts during that 3-month period
Circled figure indicates retreat
NICKTOWN
BARNESBORO
SPANGLER
Lewis Melay
H. Styles
M. Donahue
Mary E. McGee
E. Hoffman
G. Stuby
L. Foust
M. Byrnes
J. Byrnes
J. Schilling
T. Nealen
J. Nealen
J. Dick
T. Neally
S. Byrne
R. D. Williams
A. Dumm
W. A. Glenn
J. T. Thomas
F. J. Lieb
W. Giles
J. Dumm
M. C. Adams
Casper Smith
M. James
G. Fresh
J. Kirsh
John Davis
Peter Boland
L. W. Boland
G. & F. Snyder
Hopple & Lieb
L. R. Brown
H. Krug
John P. Kirsh
Francis Kirsh
Andrew Kirsh
C. Lieb
John Sherry
P. Parrish
Andrew Kirsh
Wm. Davis
Harry Bechel
A. P. Kirsh
N. Lambour Est.
Adam Lieb
Jos. Lieb
Jos. Kline
S. P. Kirsh
S. P. Kirsh, Sr.
P. Bell
A. Shuster
M. Kirsh
Jos. Lehmire
Jos. Nagle
Mrs. J. Lehmire
A. Knigle
W. Shank
A. Farrel
D. Gray
I. Kneff
J. Kline
L. Mangold
S. Kirsh
Ant. Leibolt
Chris White
Soisson Heirs
A. B. Soisson
Christine Pfiester
J. G. C. Beaver
G. & J. Houck
M. J. Kirsh
R. Morris
M. McCracken
A. Fowler
H. Trout
A. S. Elliot
J. D. Martin
T. C. Williams
R. W. Johns
J. B. McClain
A. Trout
M. W. Williams
W. R. Williams
D. Bucher
J. Anderson
C. F. Miller
Jno. Peters
Jno. Kline
Gray & Wyland
Beaver & Bitters
Francis Peters
S. Groff
Mrs. K. Dougherty
Jos. Sherry
Jos. Eckenrode
MAIN A
MAIN B
MAIN C
MAIN D
MAIN E
MAIN F
MAIN G
MAIN H
1420
1400
1380
1360
1340
1320
1300
1280
Scale 1" = 1000
File D-421-A
TRACING TO B. & T. Co.