

WILLIAM DOBSON


JACOB DOBSON

C. MARTZ

J. ENTERLINE

JOHN MAURER EST.

STAHLMAN EST.

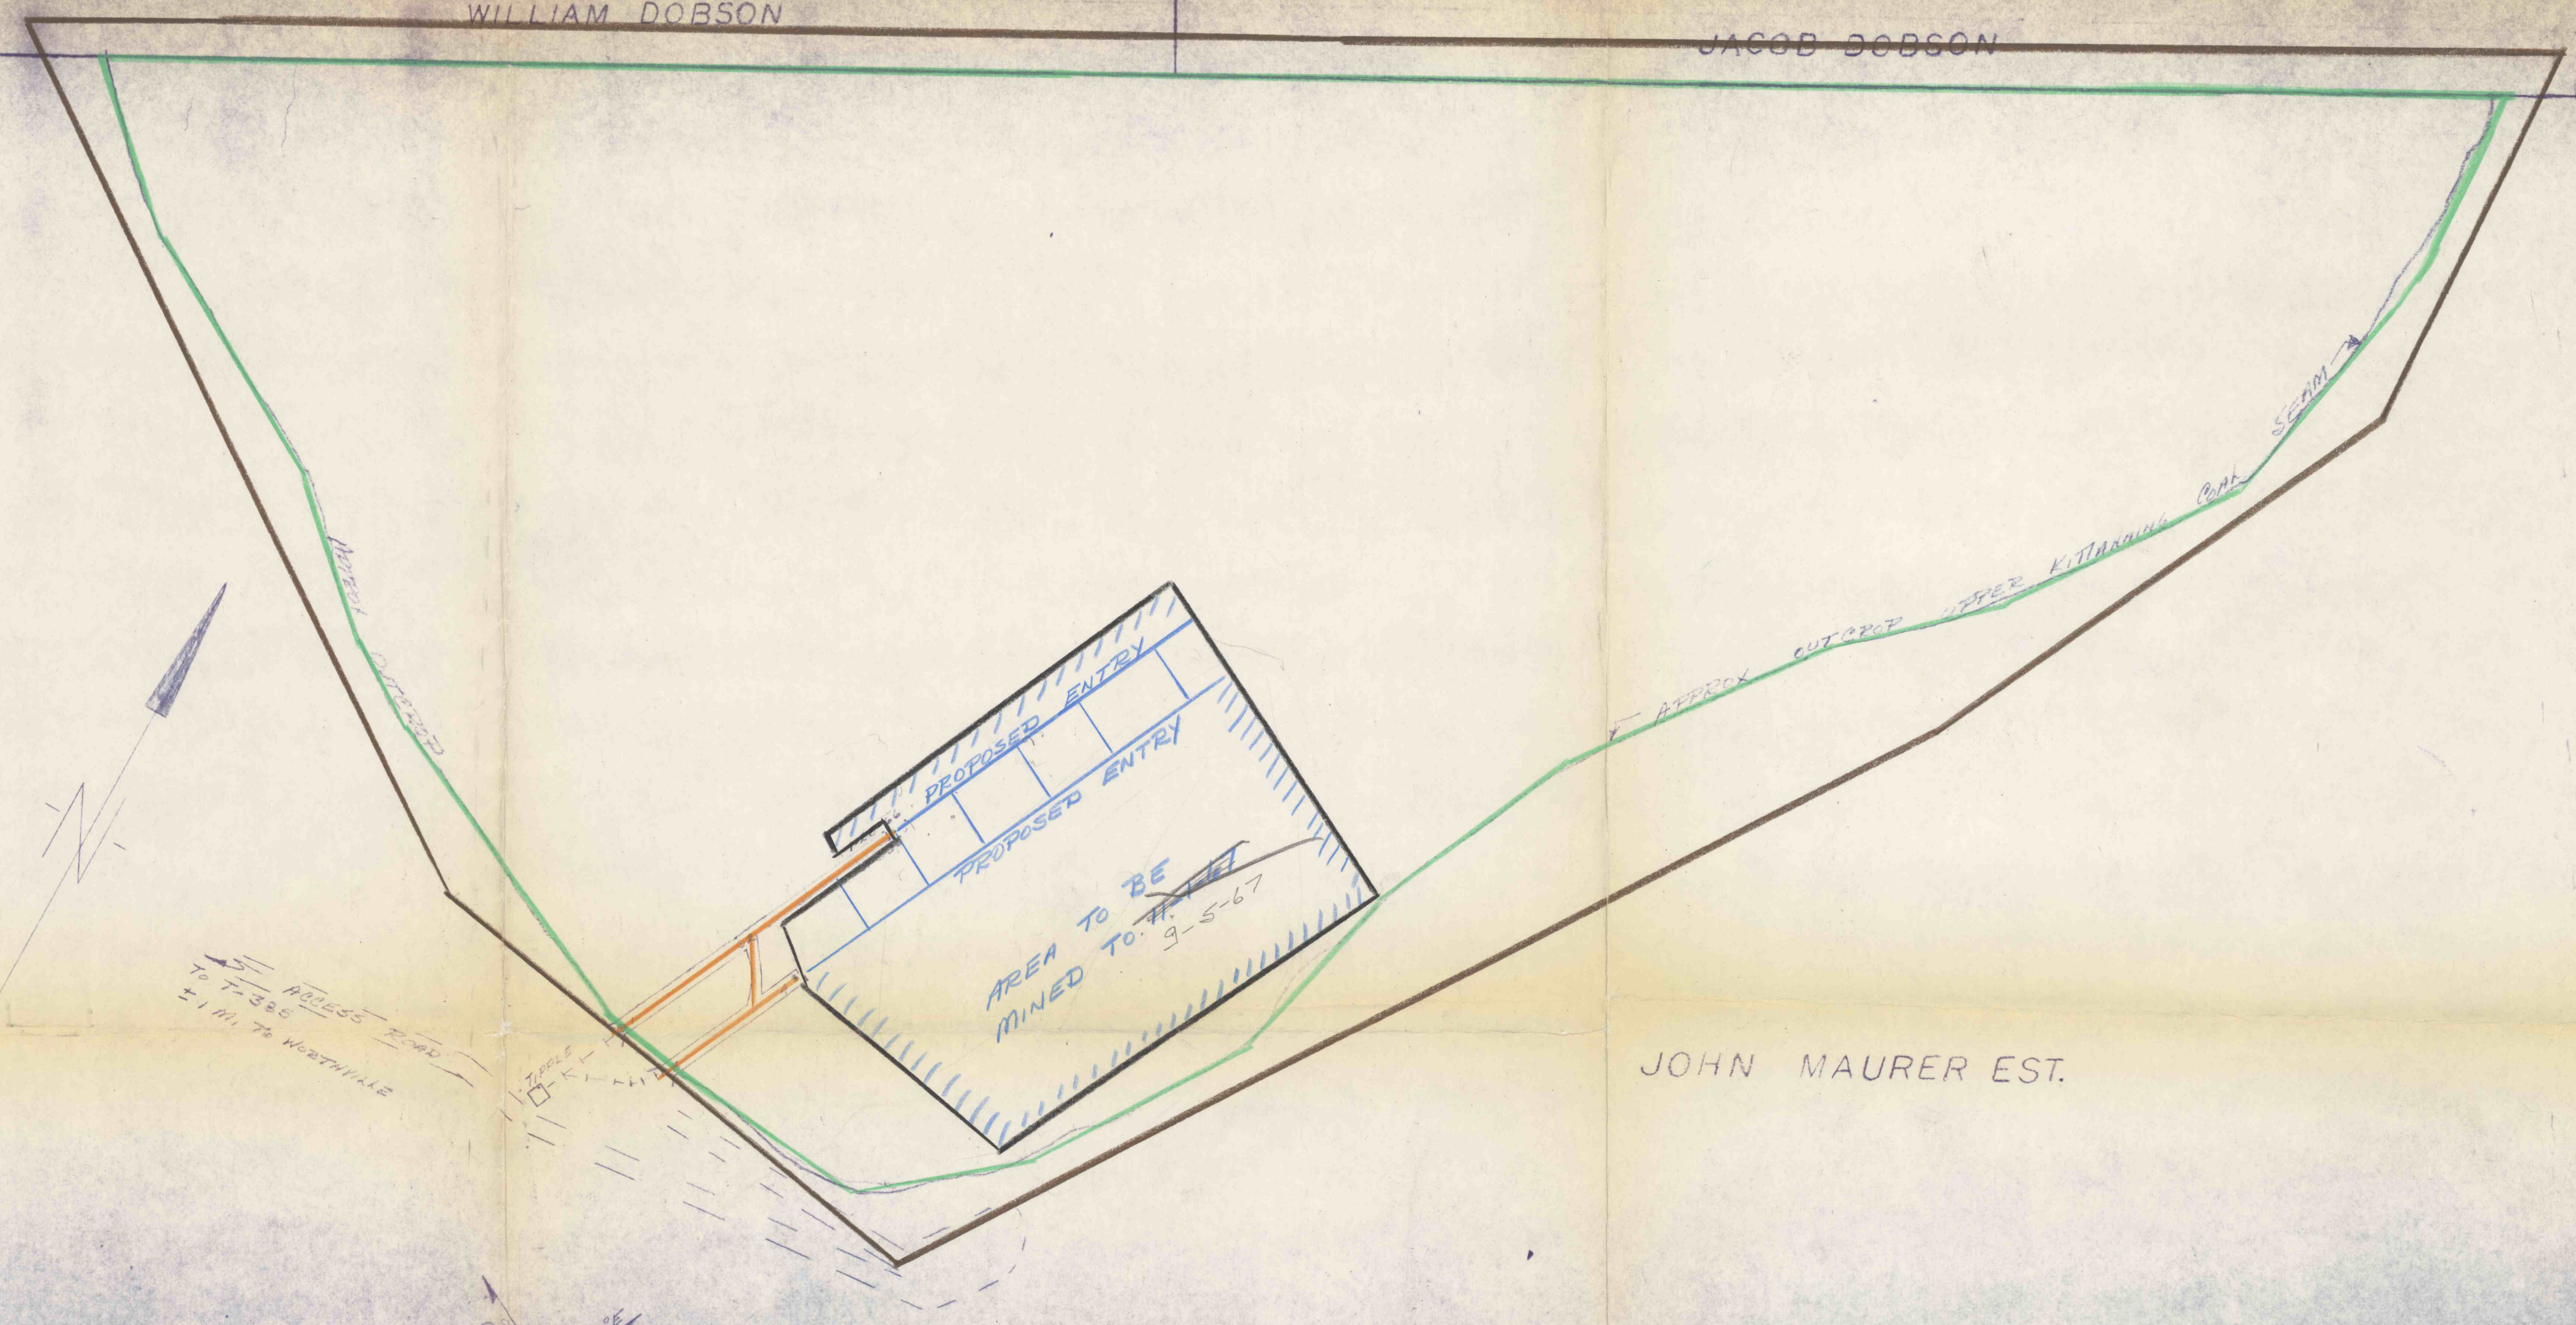

LEGEND  
 ——— LIMITS OF MINE  
 ——— LIMITS OF PERMIT  
 ——— ENTRIES  
 [Hatched Box] AREA TO BE MINED TO 11-1-67  
 9-5-67

MINE MAP  
 BECKMAN NO. 12 MINE  
 OLIVER TWP. JEFFERSON CO.  
 1-30-67  
 1"=100'

*J. M. Douglas*

#194  
 6-7-99  
 C.L.