


A

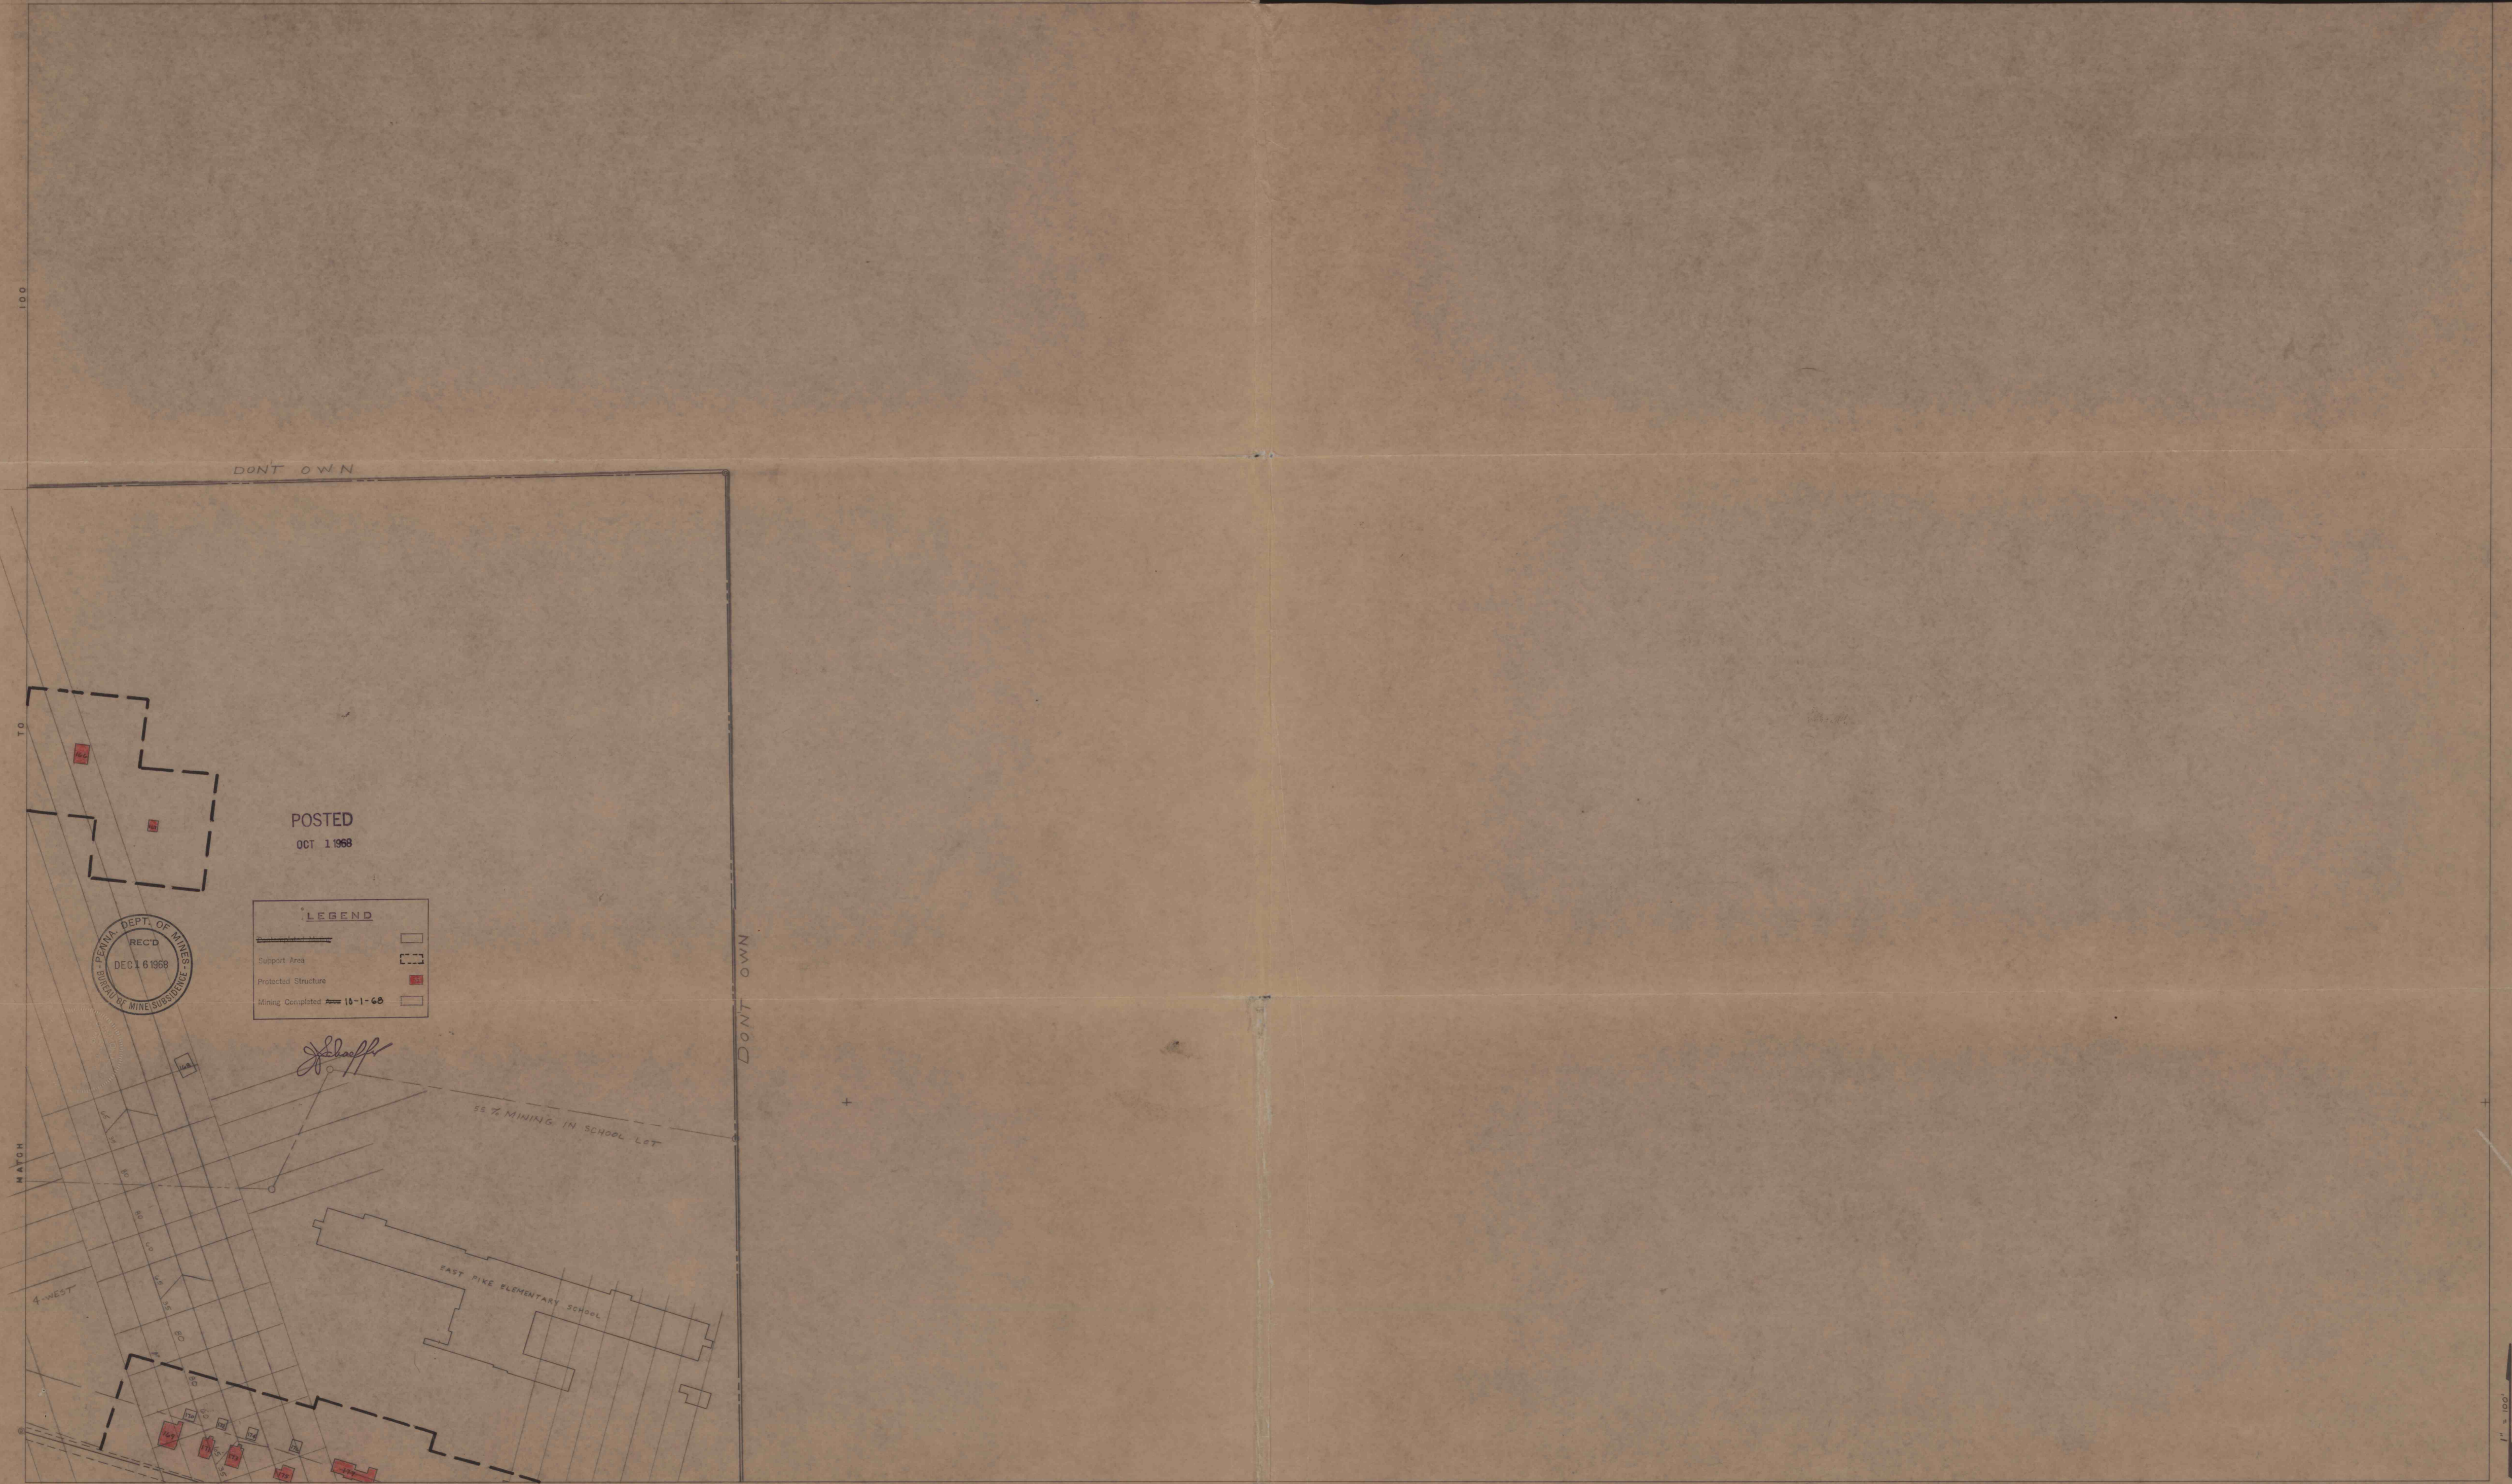

100

TO

MATCH

4-WEST

A

DONT OWN

POSTED  
OCT 1 1968

LEGEND

	Support Area
	Protected Structure
	Mining Completed 10-1-68



*Schaff*

EAST PIKE ELEMENTARY SCHOOL

25% MINING IN SCHOOL LOT

DONT OWN

MATCH

110

LUCERNE MINE - R. & P. COAL CO.  
WHITE TWP. - INDIANA COUNTY

1" = 100'