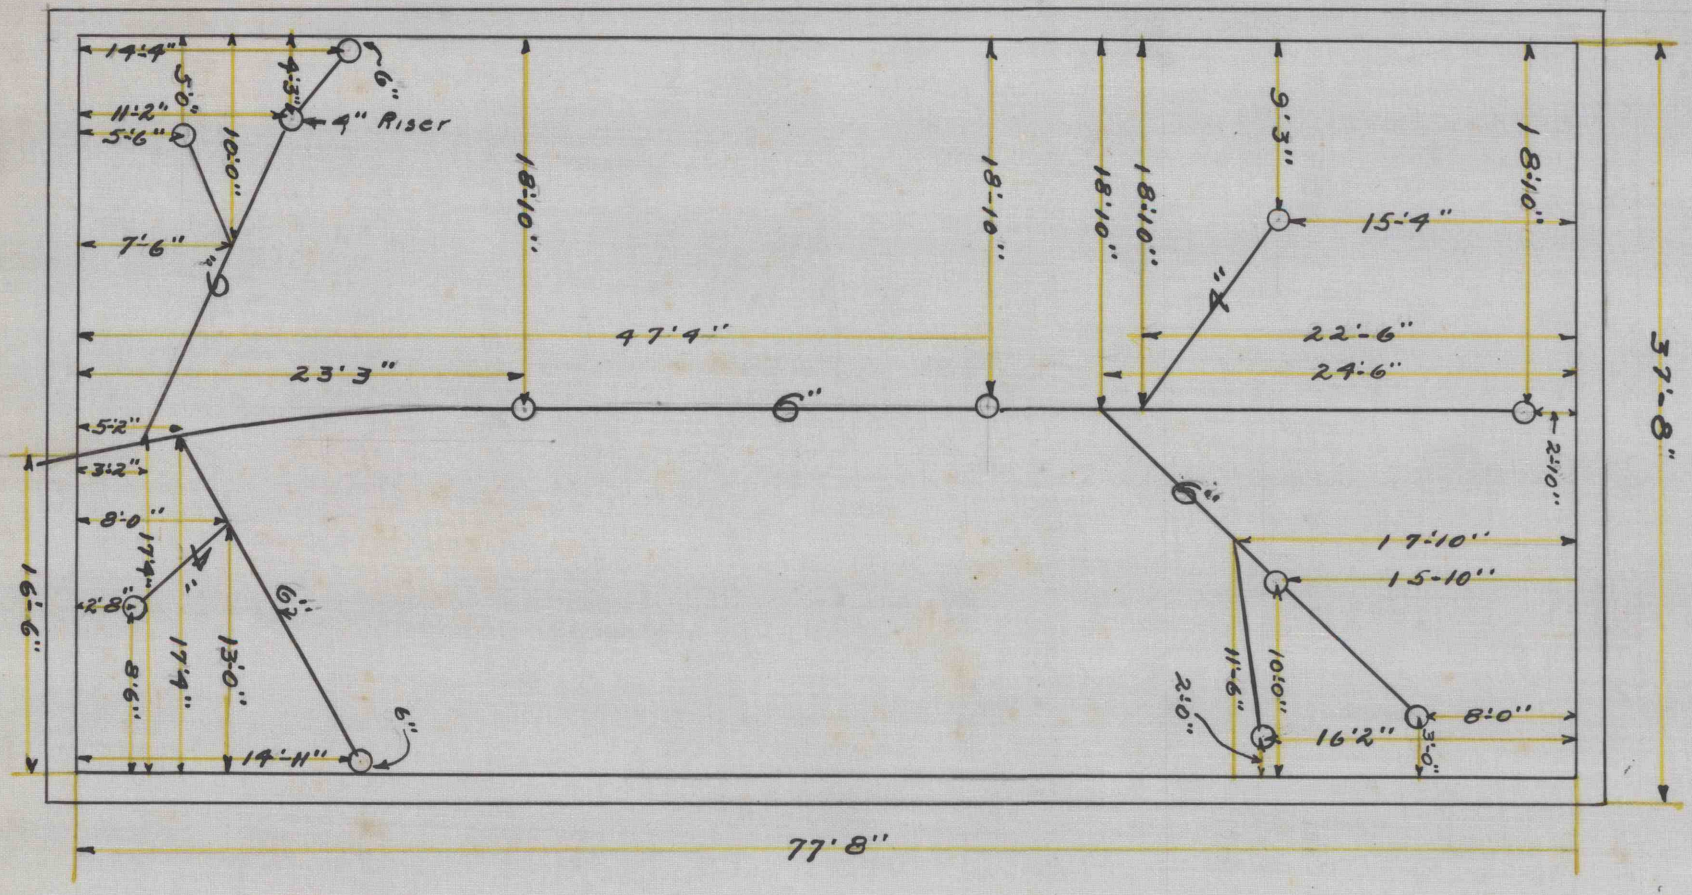

WESTMORELAND MINING CO.

Sewer Locations in Bath House

Scale 1" = 10' Mar. 24, 1921 Albert Smith C.E.

Blairsville Pa.

4012

West ~~2958~~ -4-1