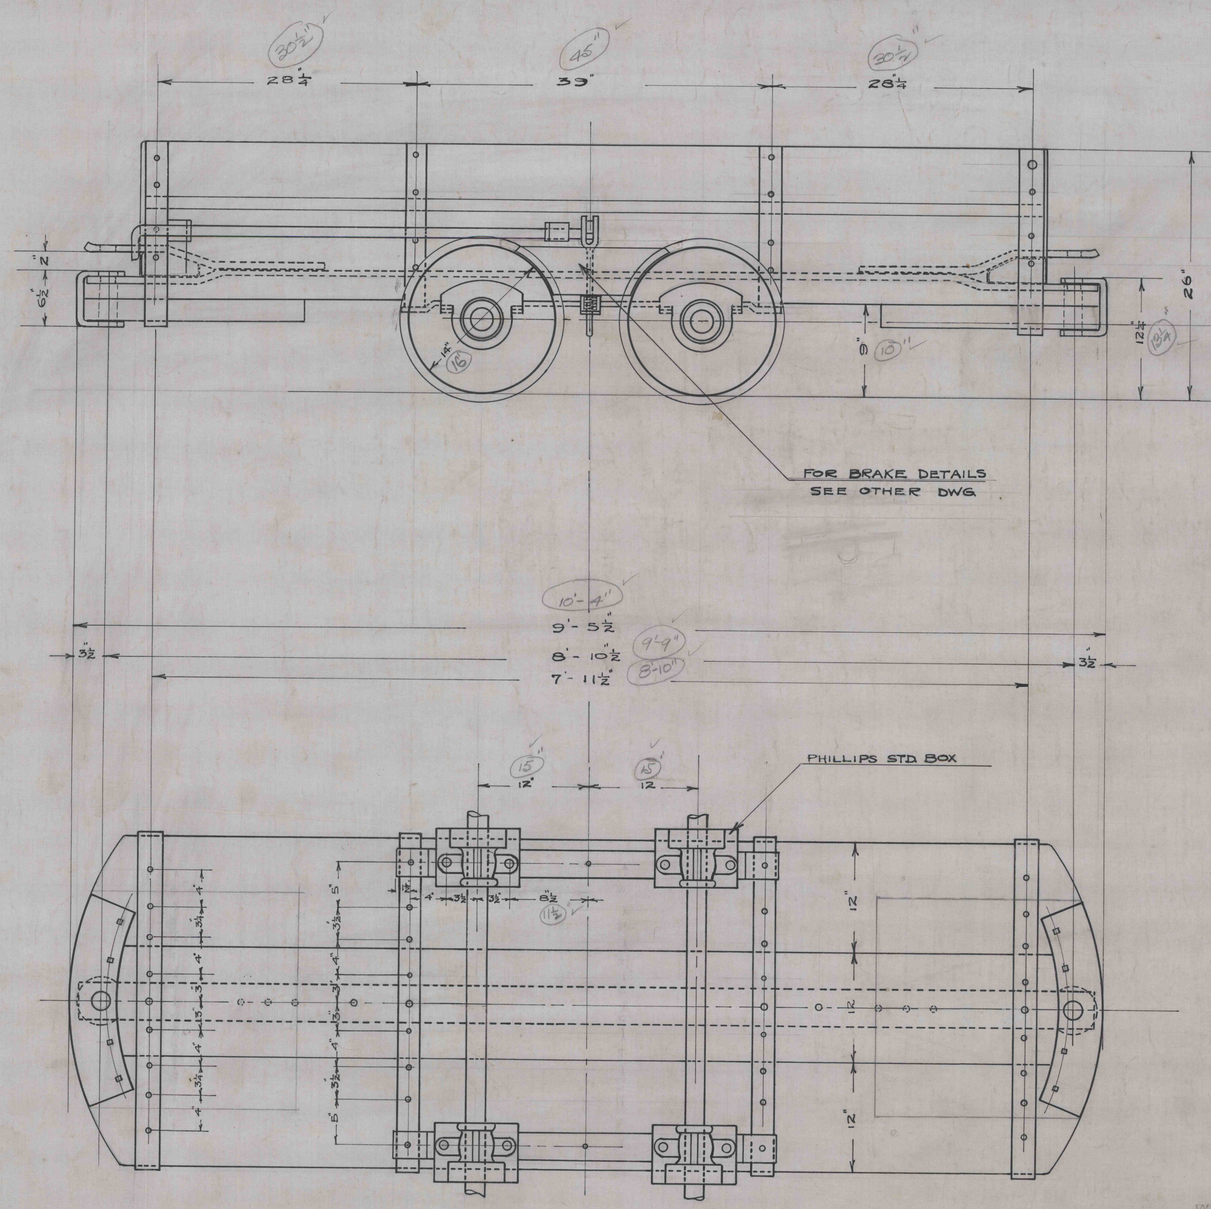

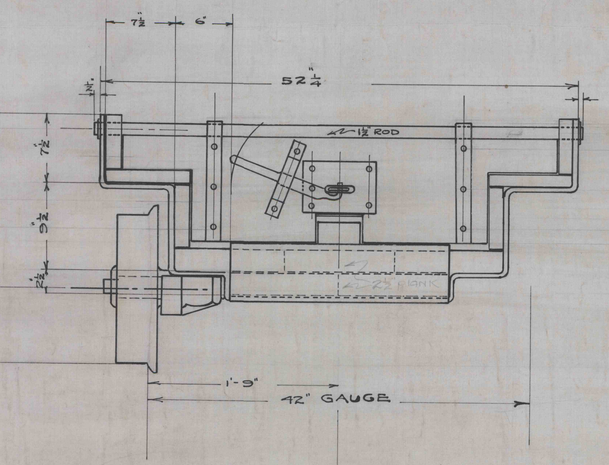

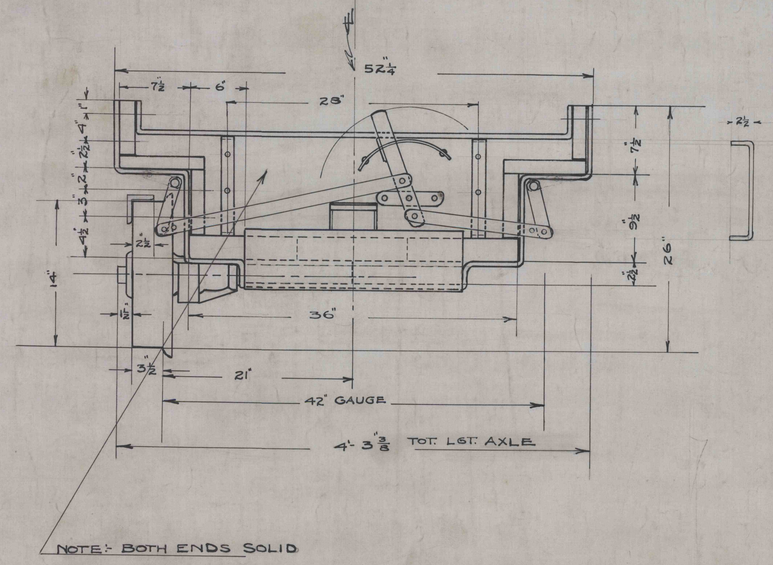

NOTE:- BOTH ENDS SOLID

BRAKE WILL BE CLEAR L GRIP
WT:- EMPTY CAR 2050#
" LOADED " 4780#
WILL USE SAME TYPE COUPLING
AS LA RAYNE COAL CO.

MINE CAR PLAN FOR NO. 17 MINE BARNES & TUCKER CO

BARNESBORO, PA.

SCALE 1½"=1'-0" JUNE 18, '23.

B&T ENG'R DEP'T - BARNESBORO, PA.

C.P.B.

D-A-8

4209
Q15