


Changes to Dimensions
Shown

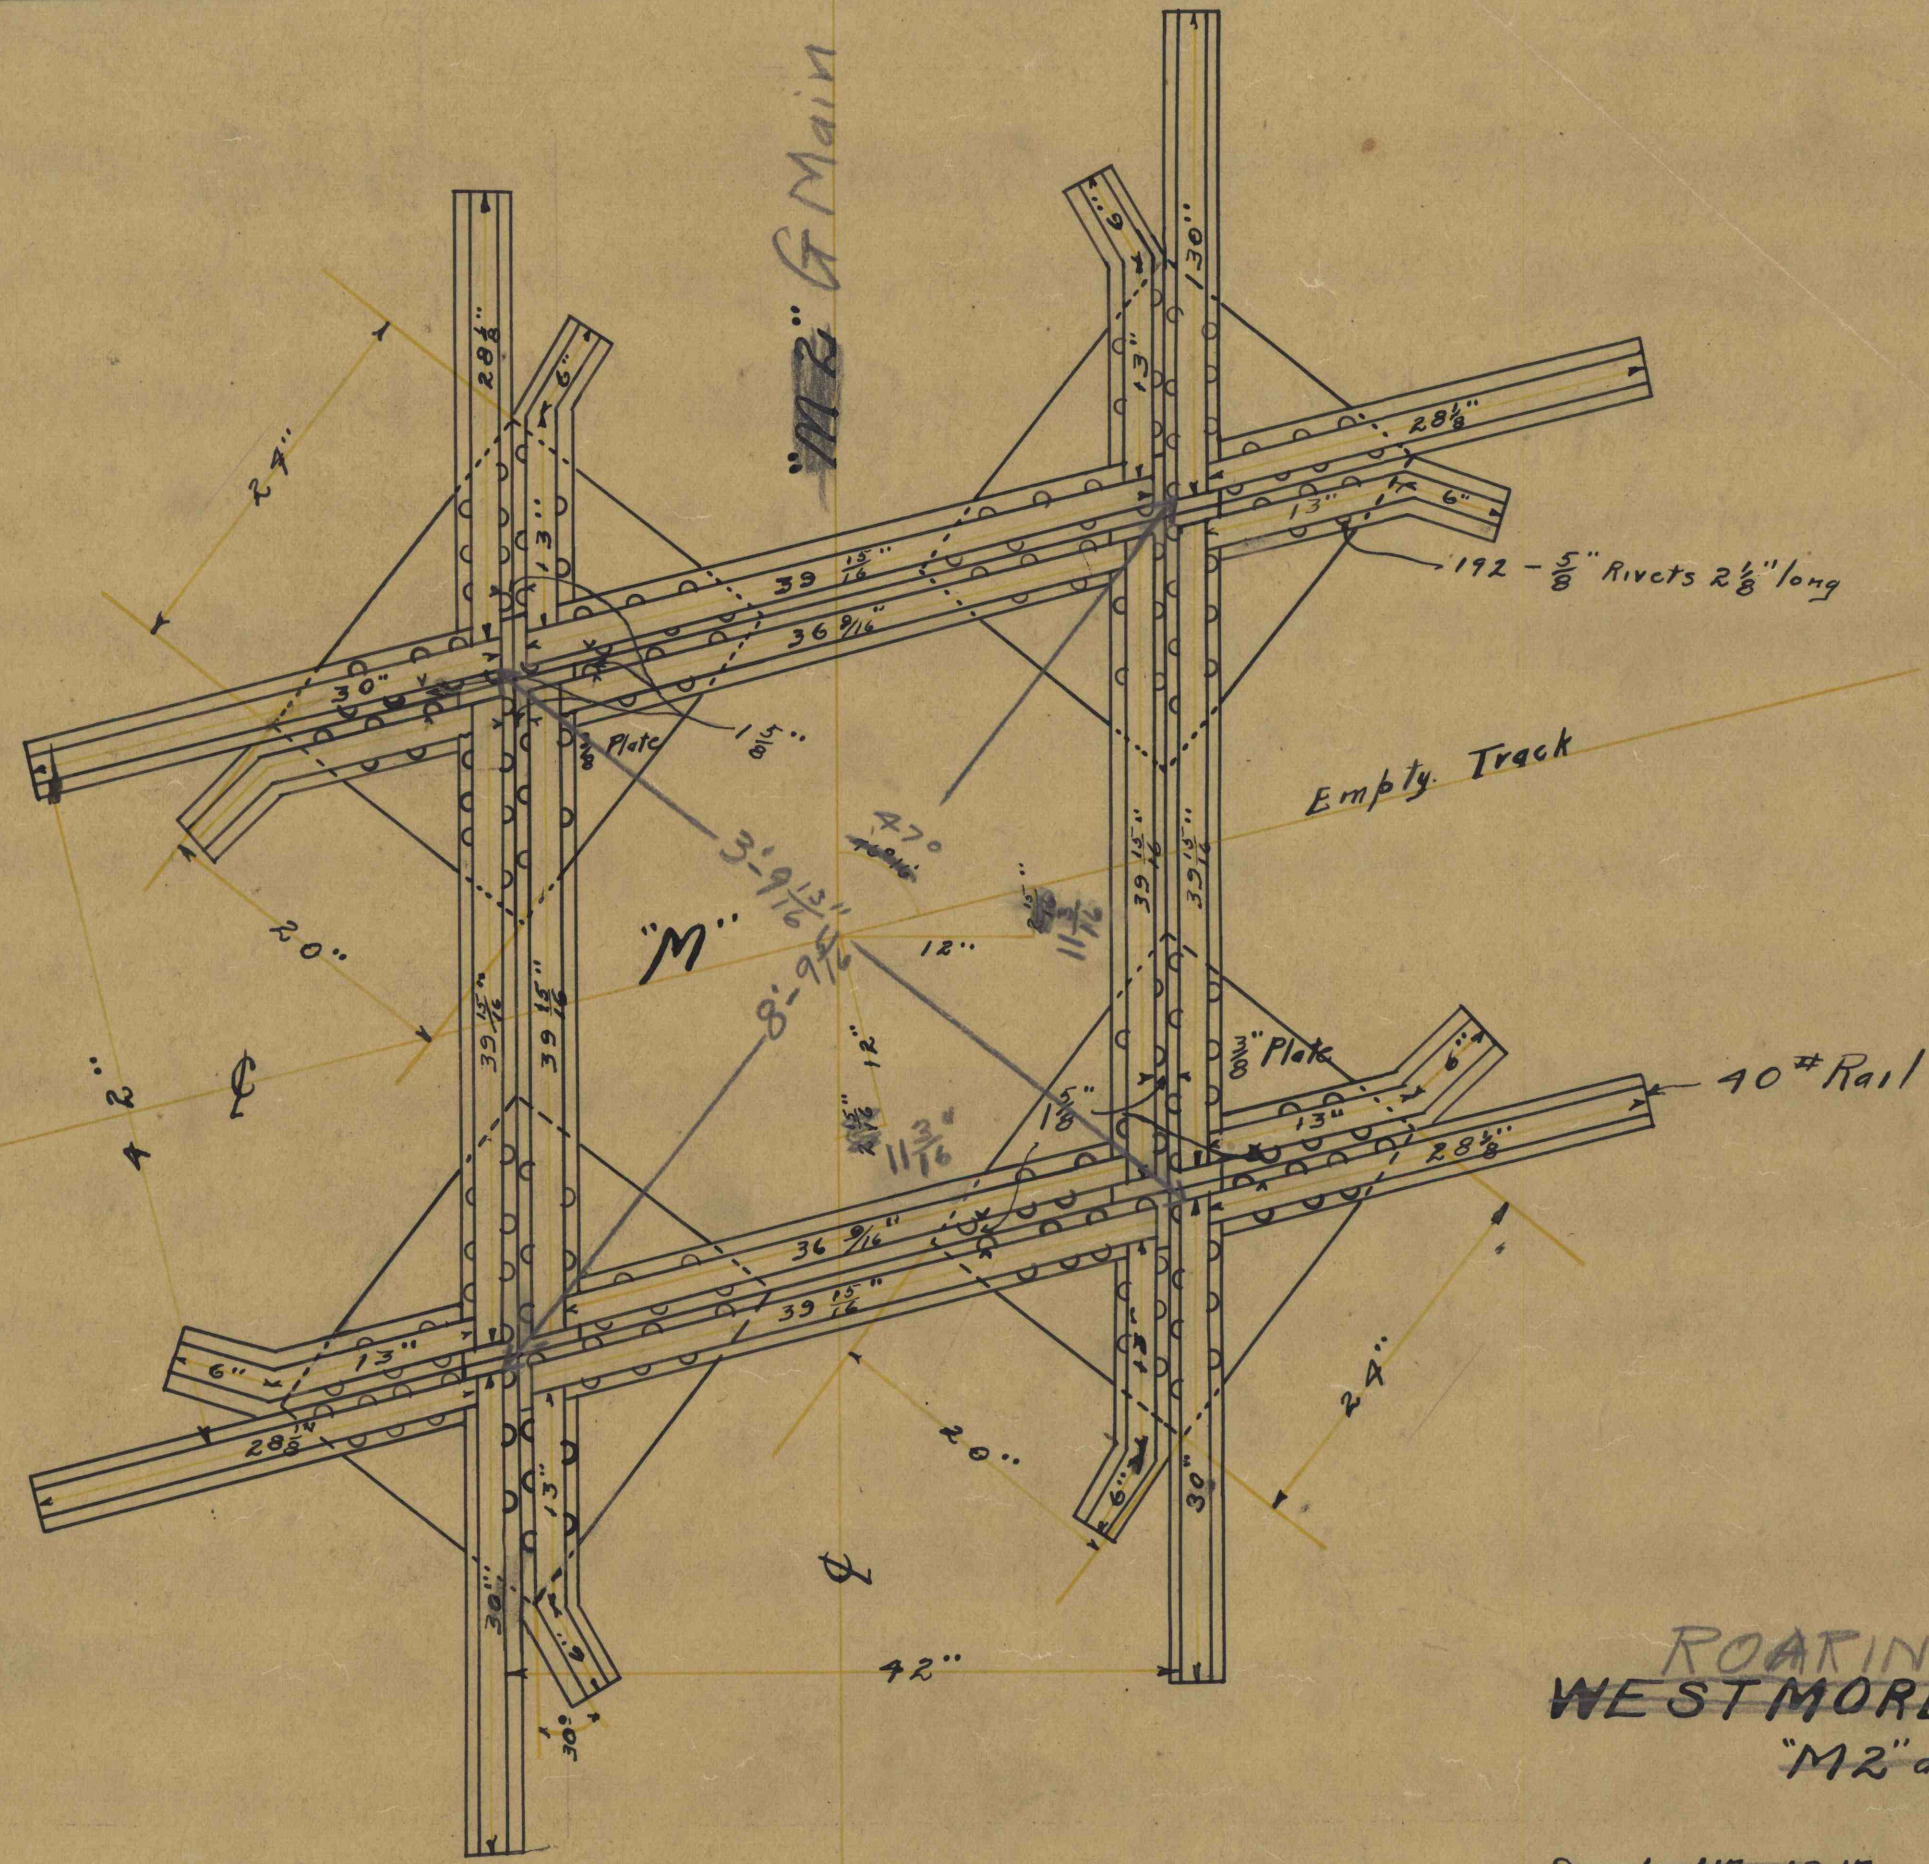

ROARING RUN OPERATION
 WESTMORELAND MINING CO
 "M2" and "M" Empty Track

Crossing
 Scale 1" = 12" 7/25/22
 9/3/29
 Albert Smith C.E.
 Blairsville Pa.
 R.R. 5207
 Plate 7/175 - 5-3