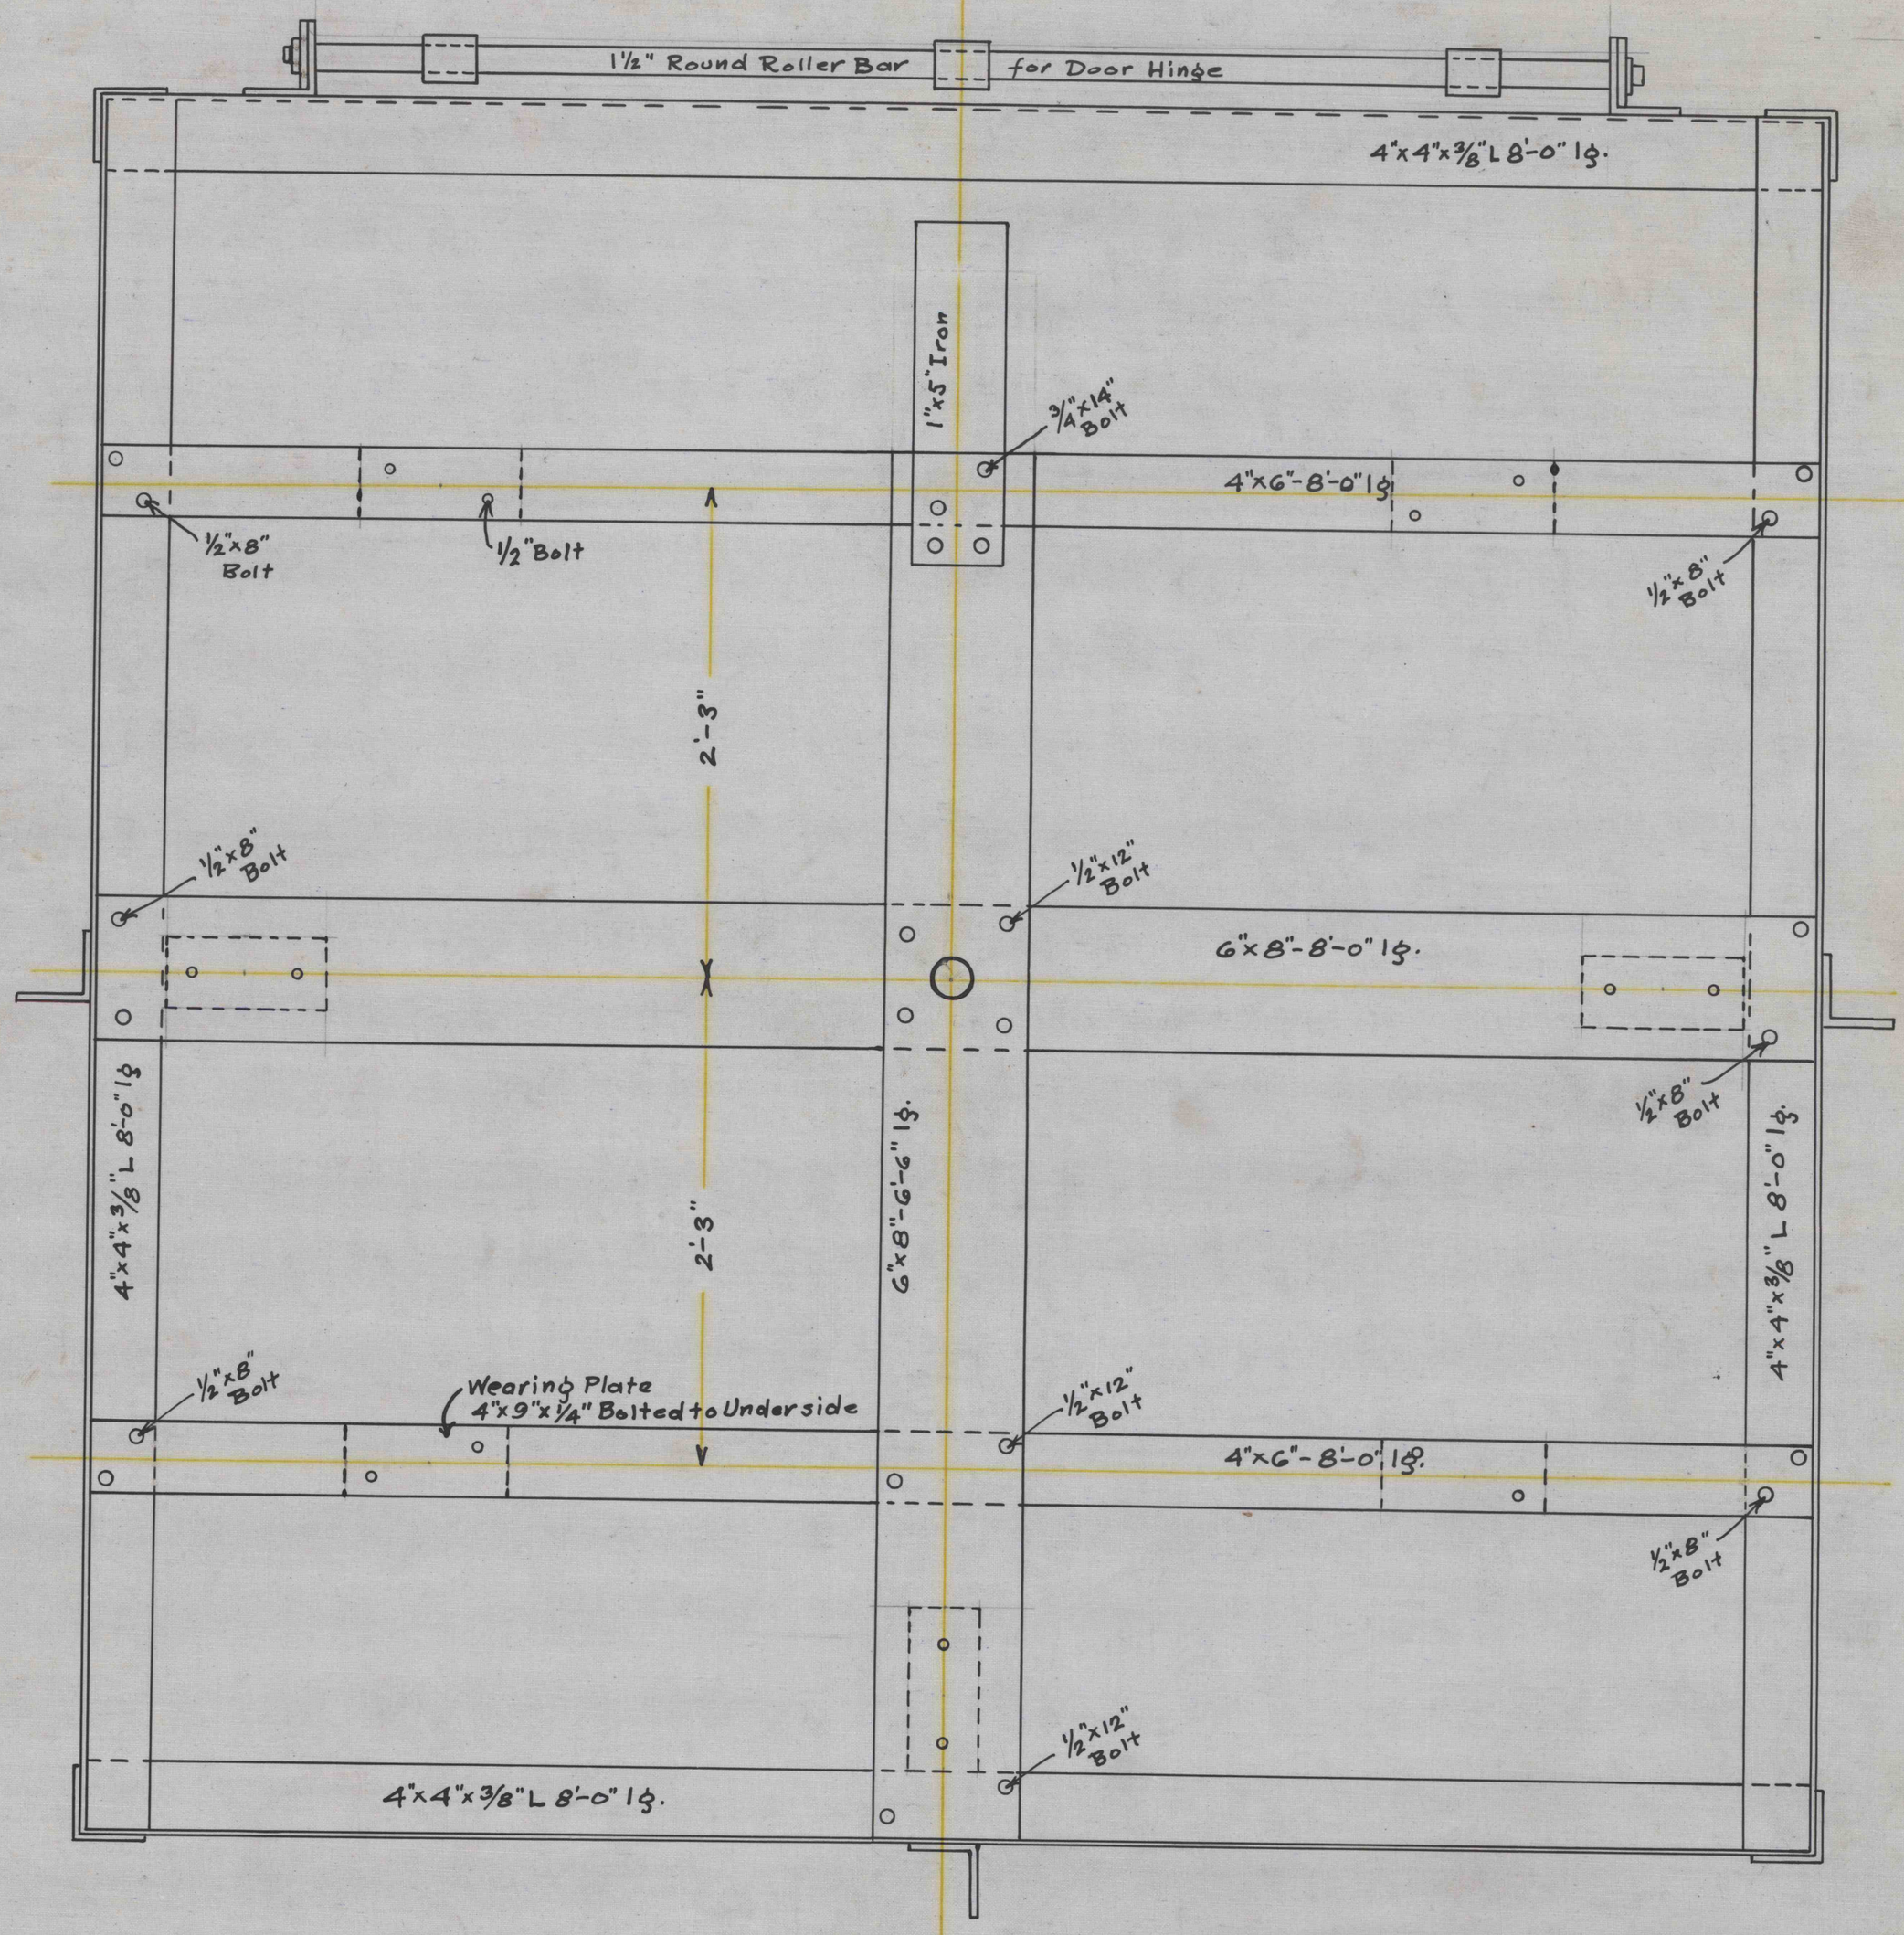

BOTTOM OF CAR

KISKIMINITAS COAL CO.
BRUSHVALLEY OPERATION
GOB CAR
SCALE: 1½"=1' JAN. 23, 1923
ALBERT SMITH, ENGR.
Revised Jan. 14, 1924.

5704/4
BV ~~3012-4-5-B~~