
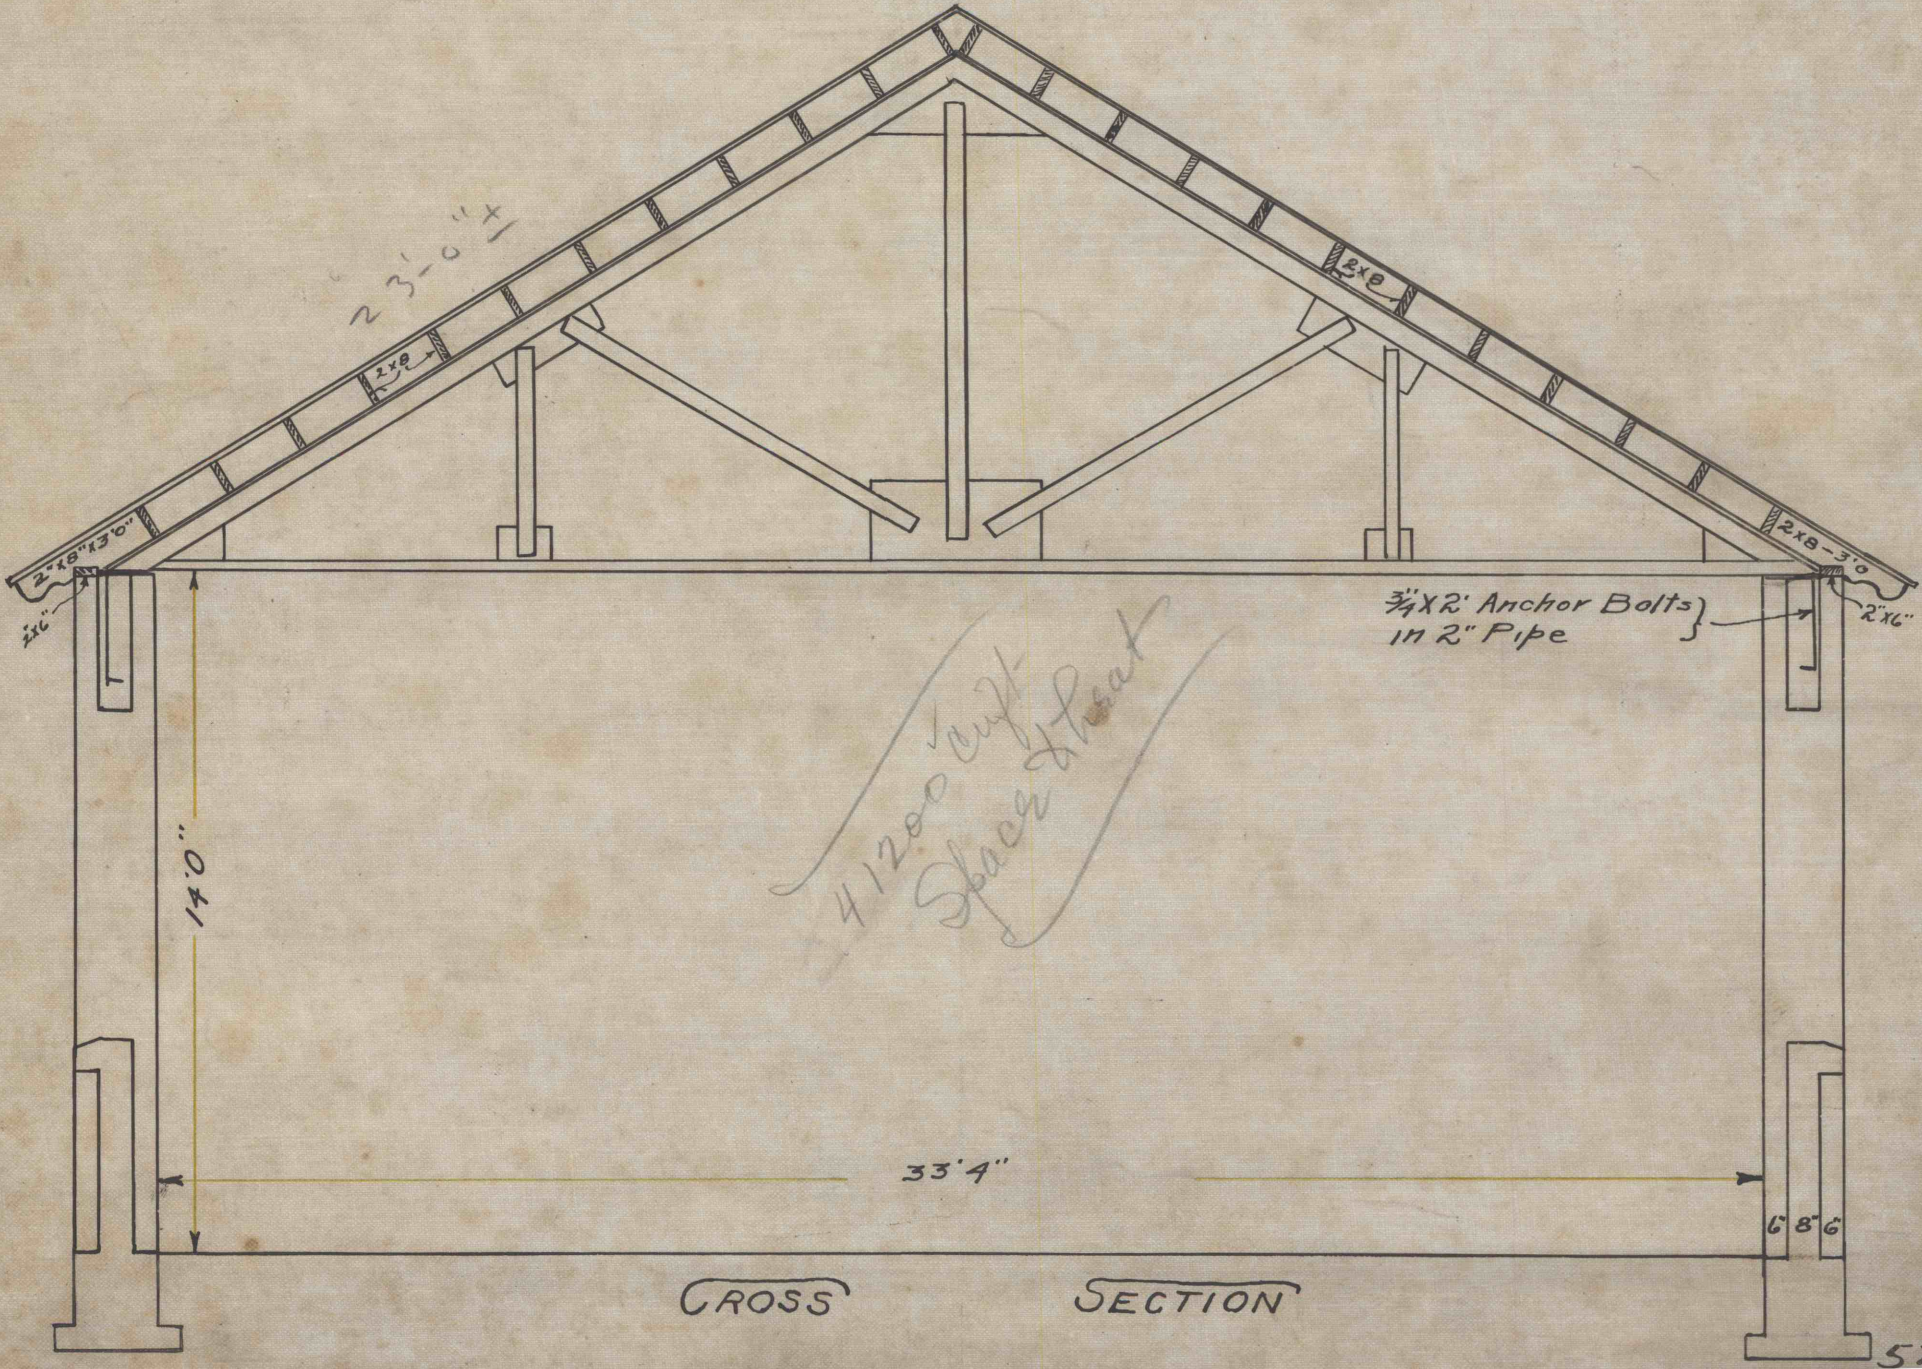


Approved	
<i>Albert Smith</i> Saltzburg Pa.	
GRAFF MINING CO	
BLAIRSVILLE PA	
BLACKSMITH &	
CAR SHOP	
Scale $\frac{1}{4}" = 1' FT$	9-29-19
Drawing	Plant
33-3	1&2

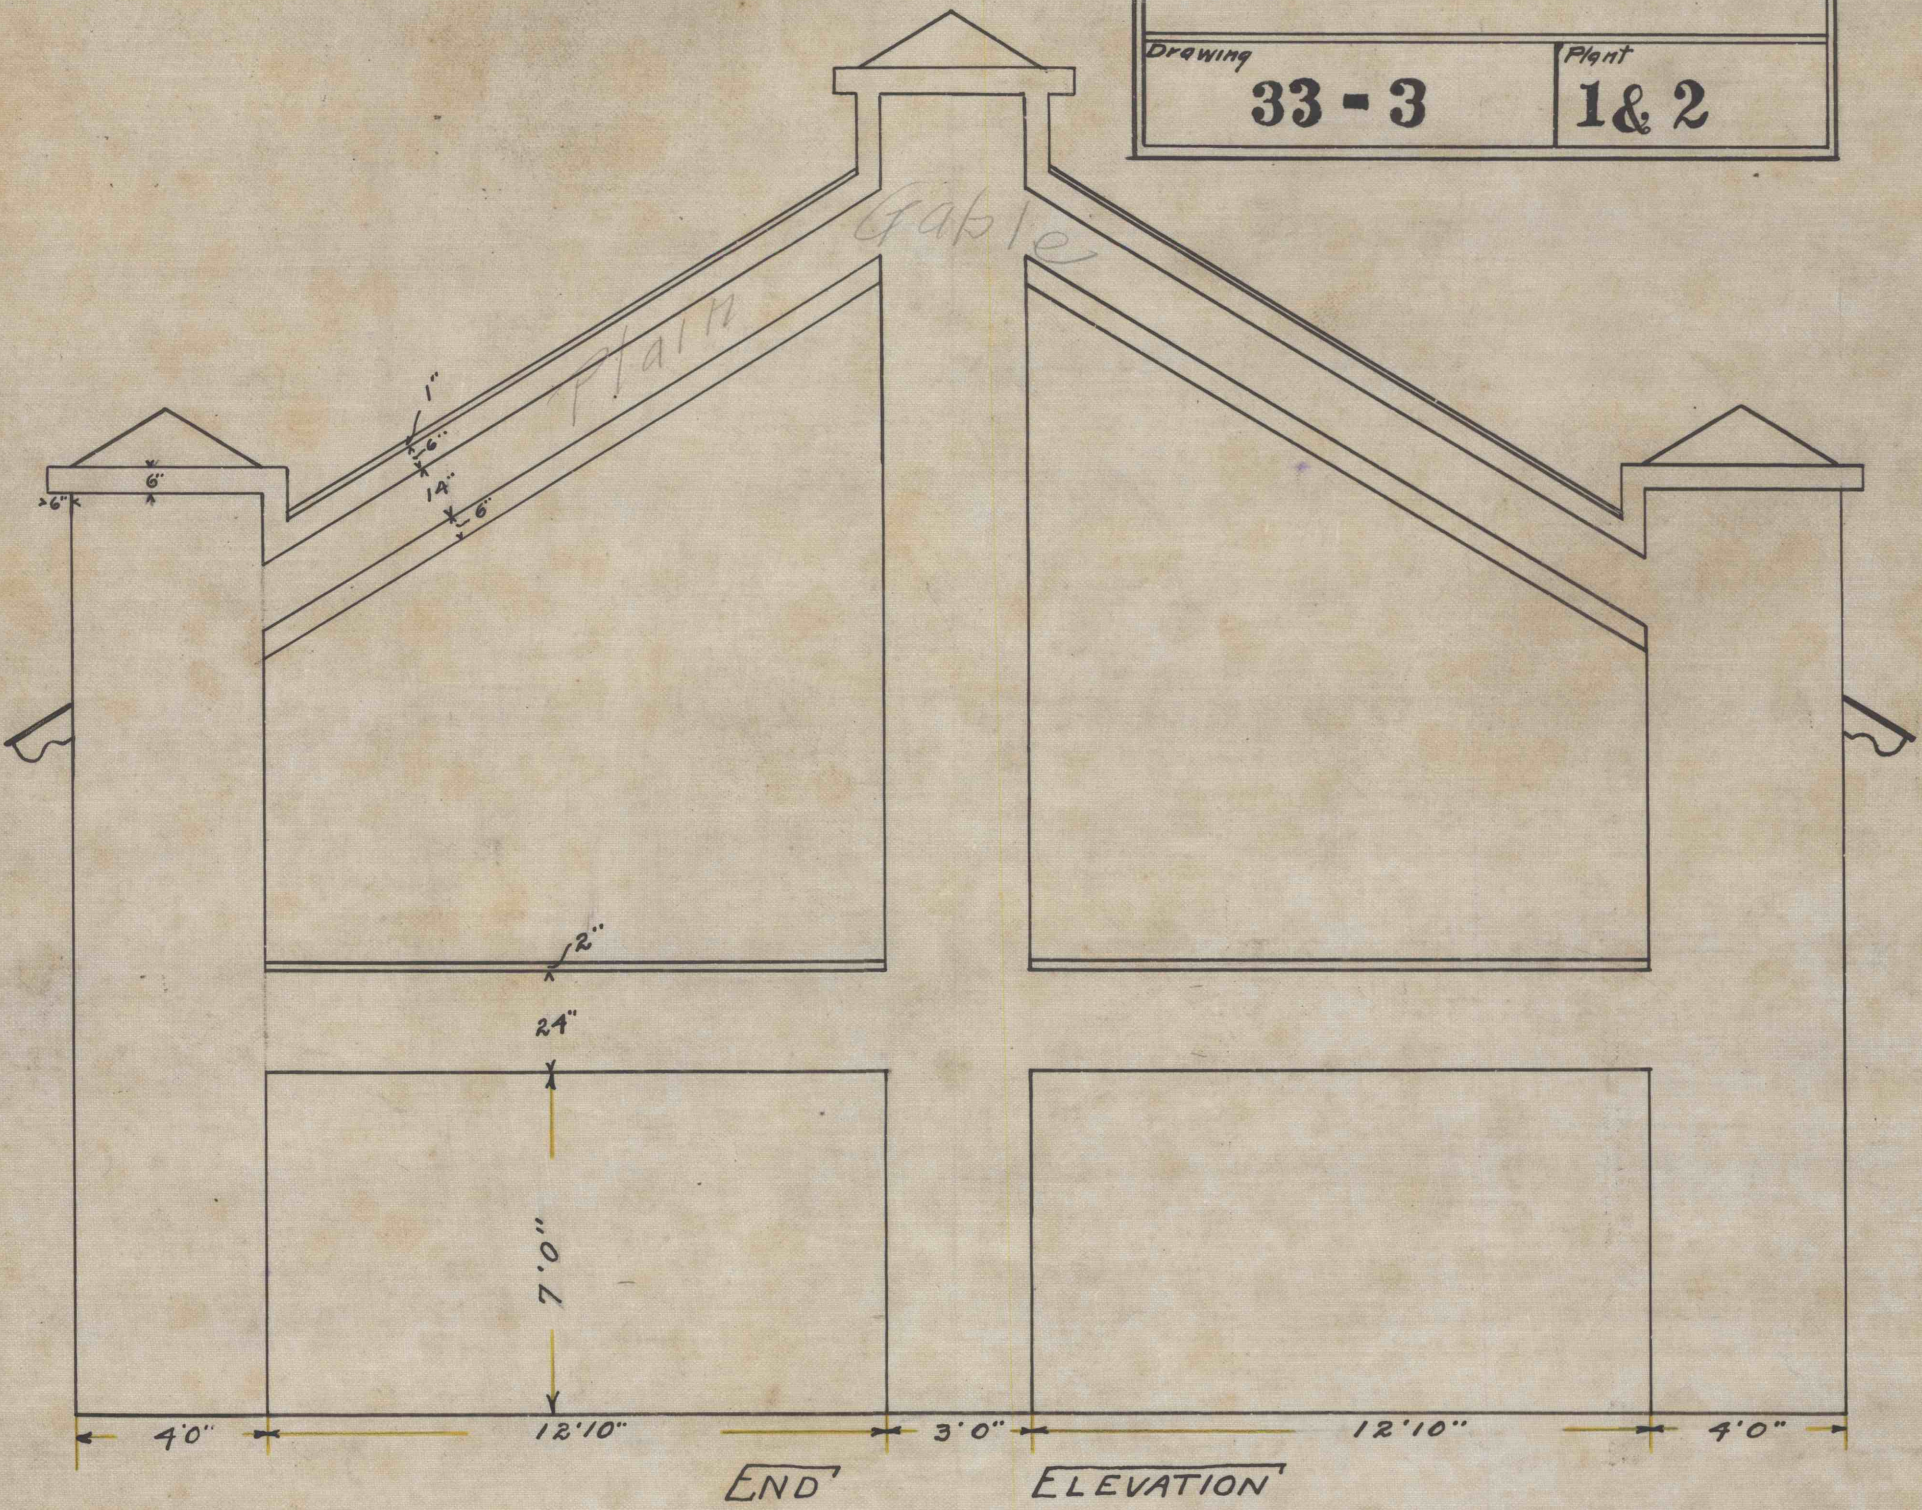

West 5222/1
-5-3

5222/1