


4602-4
R. R. 20194-4-7

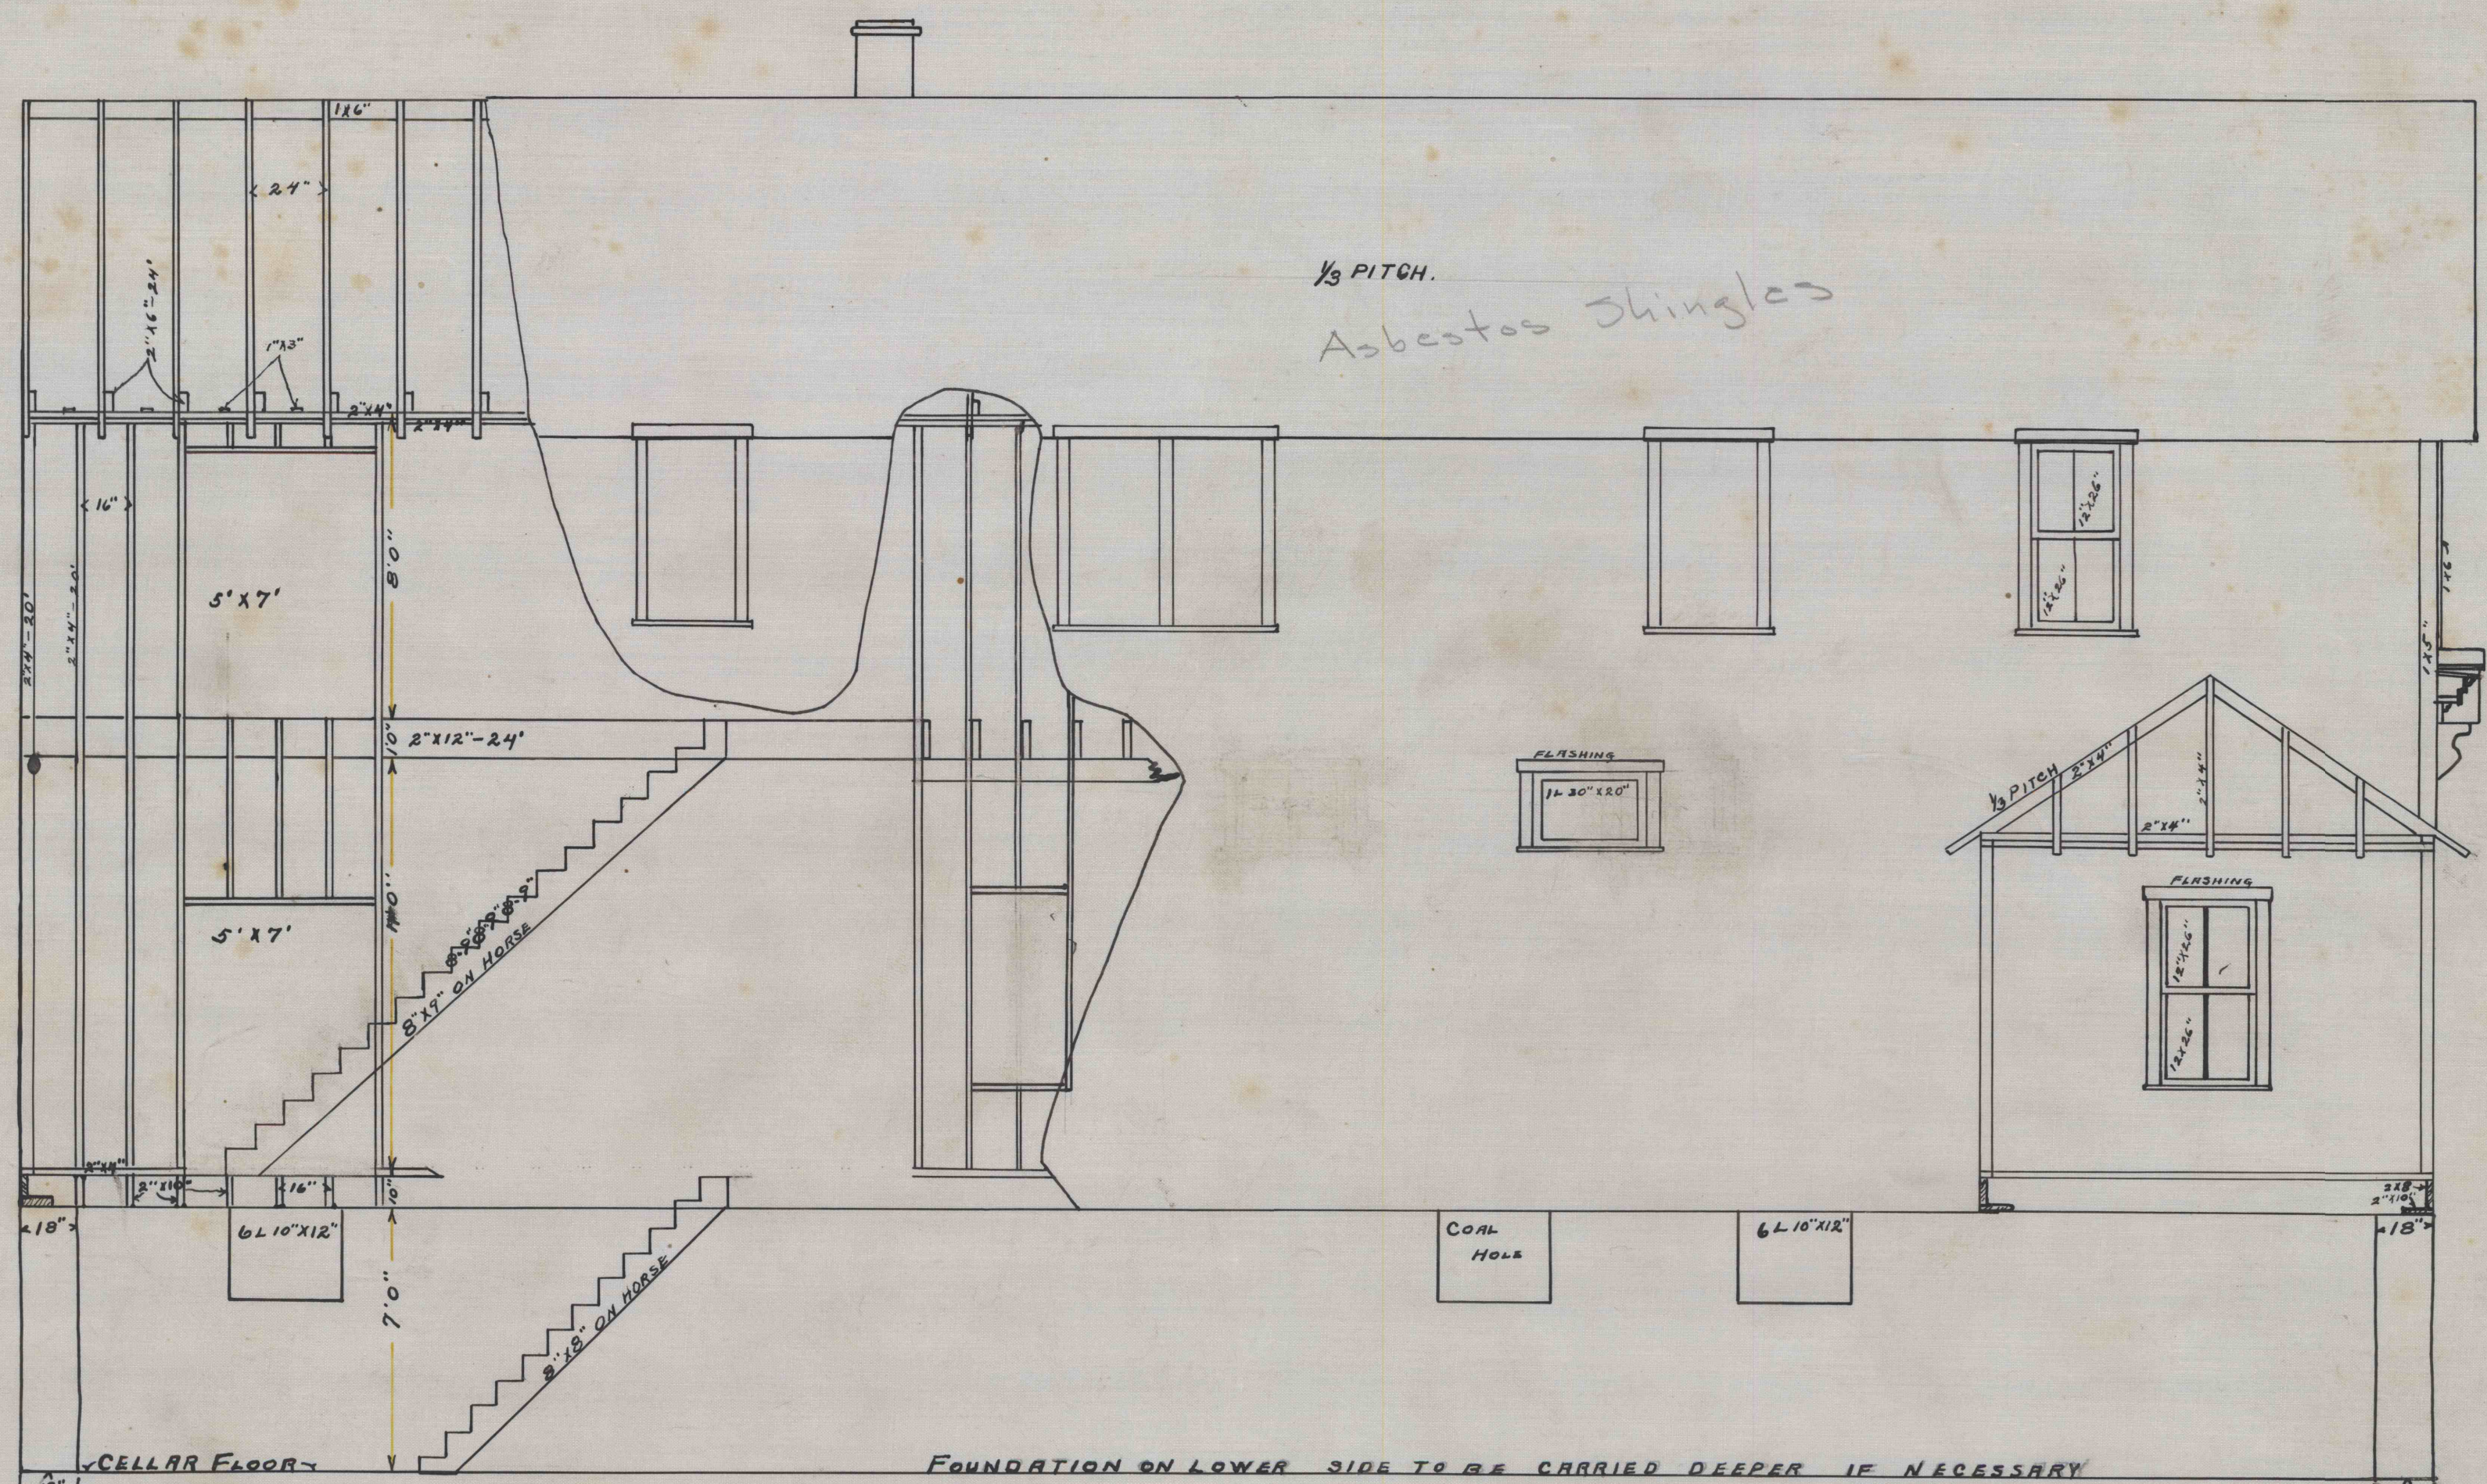

SIDE ELEVATION
SCALE 1/4" = 1'