


4602-5
R. R. 2819/6 - 4-7

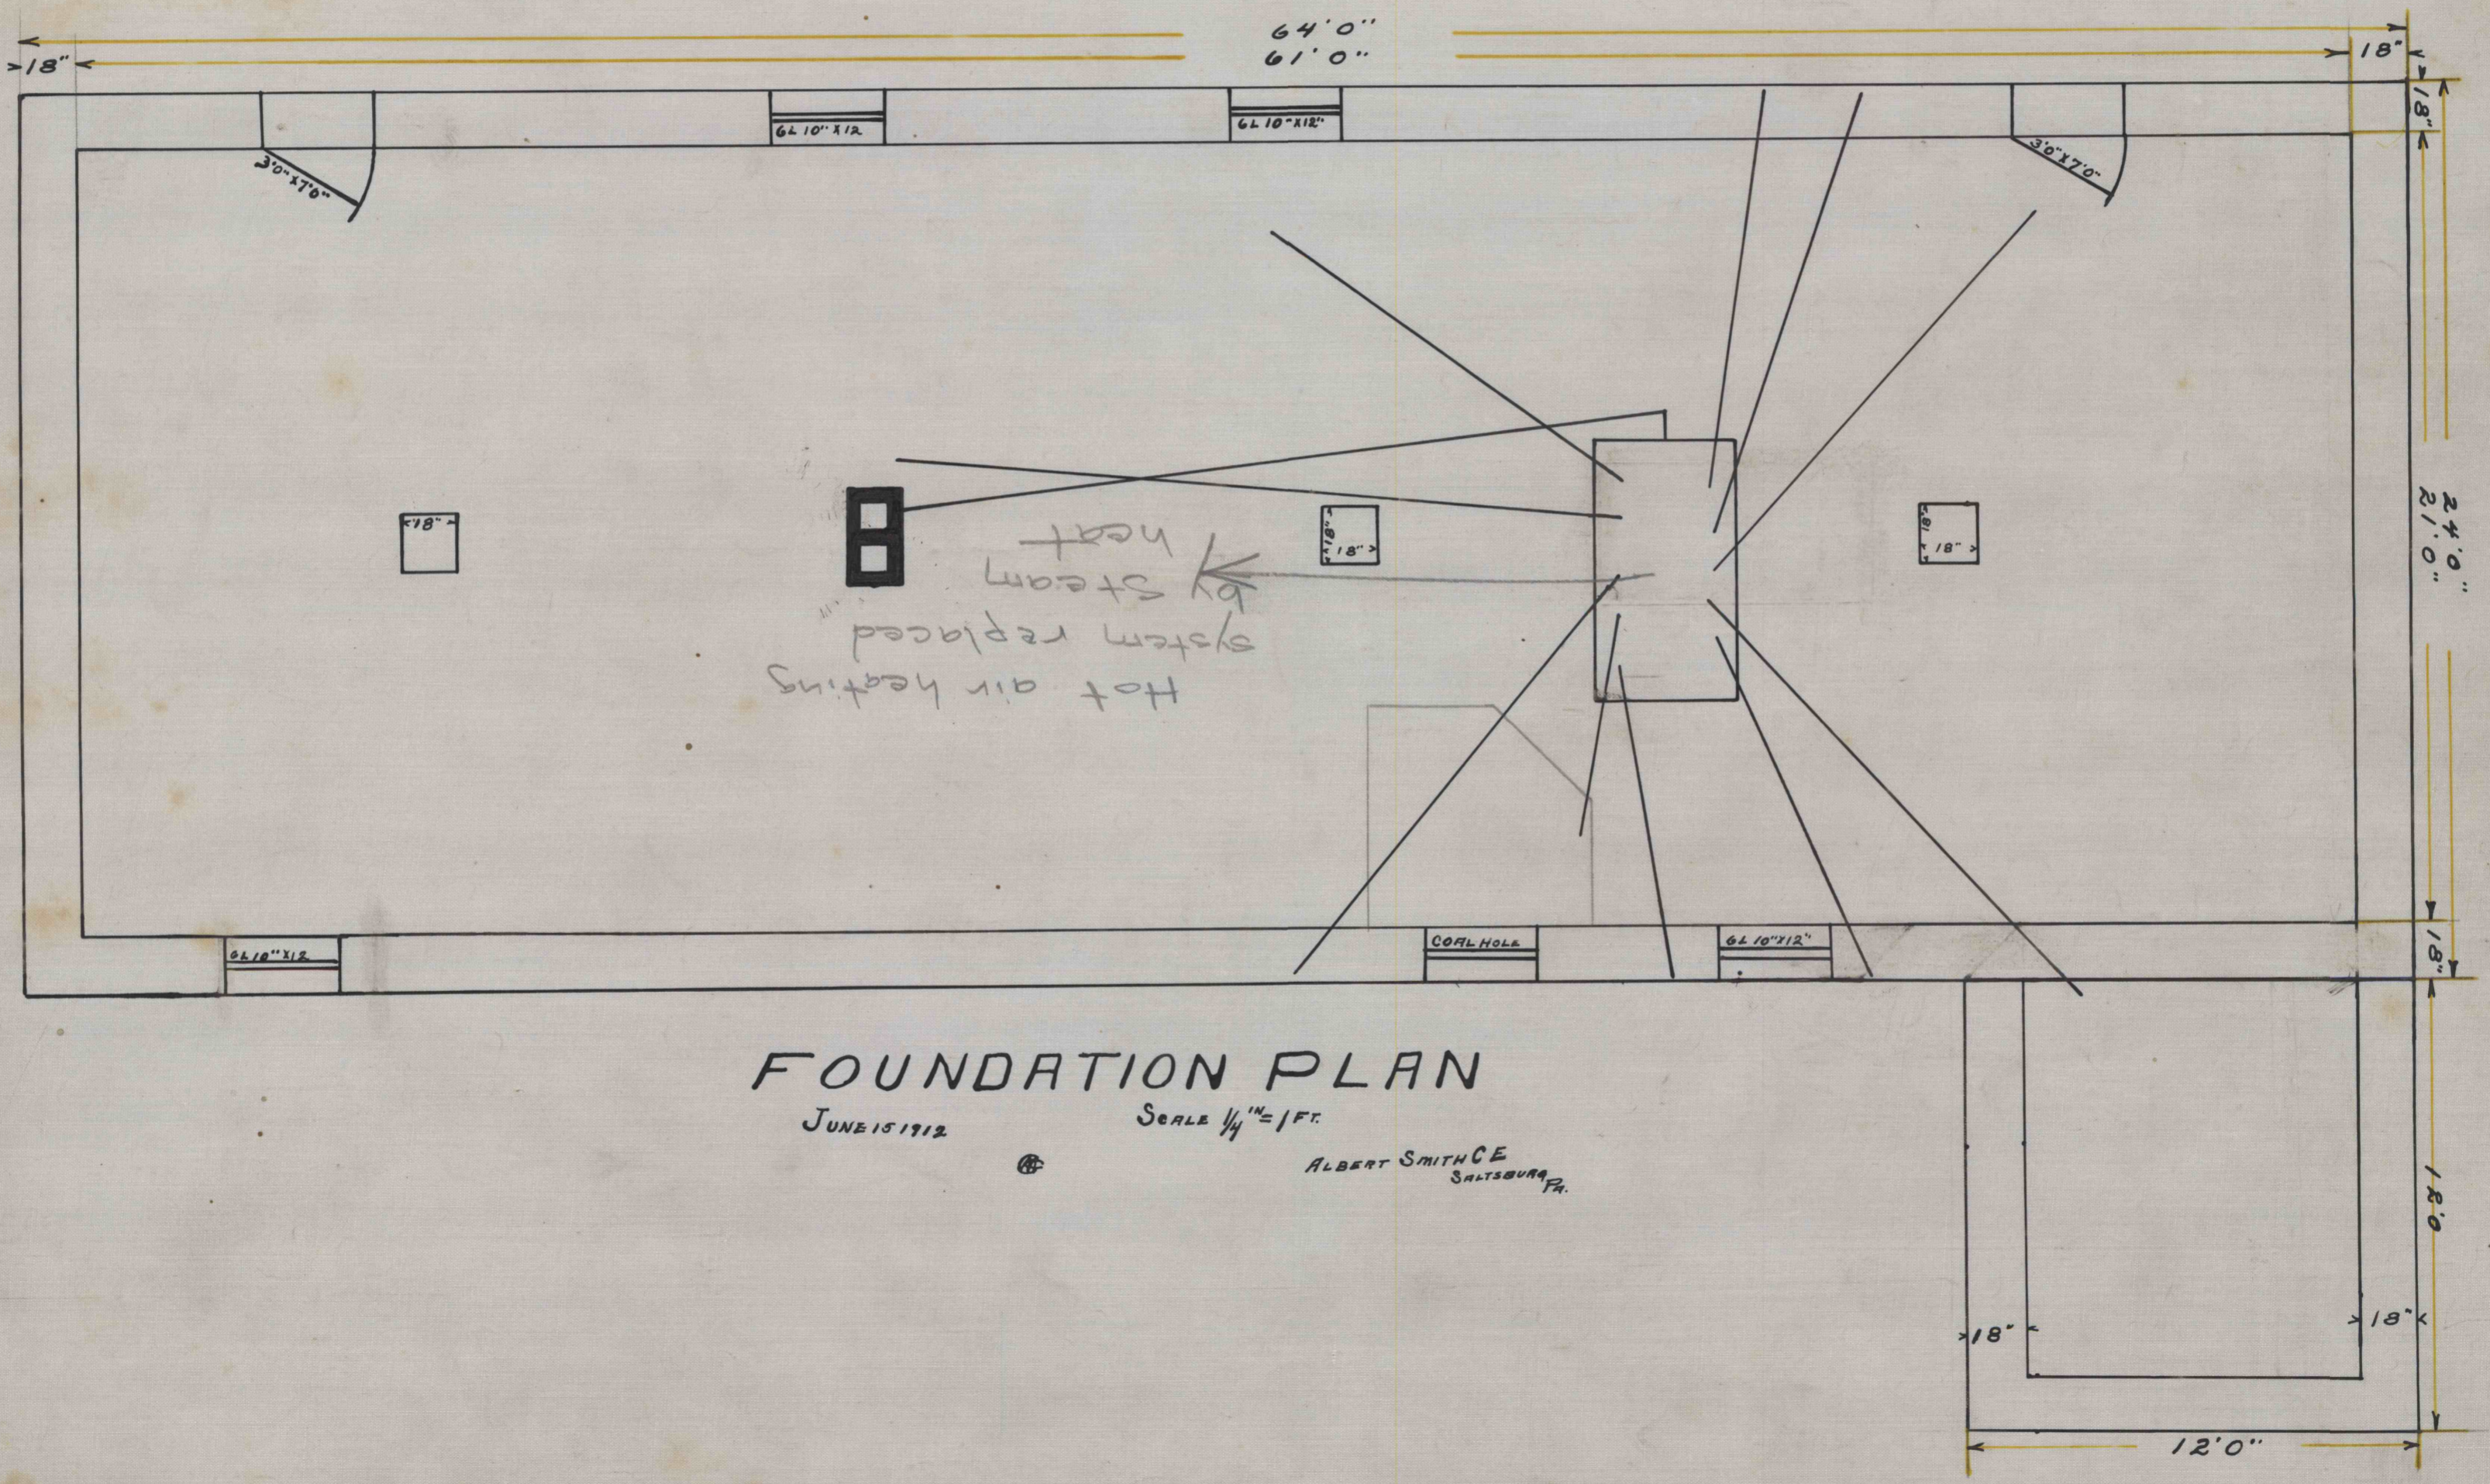

FOUNDATION PLAN

JUNE 15 1912

SCALE 1/4" = 1 FT.

ALBERT SMITH CE
SALTSBURG PA.

