

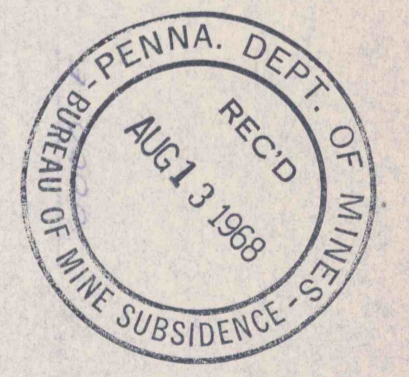
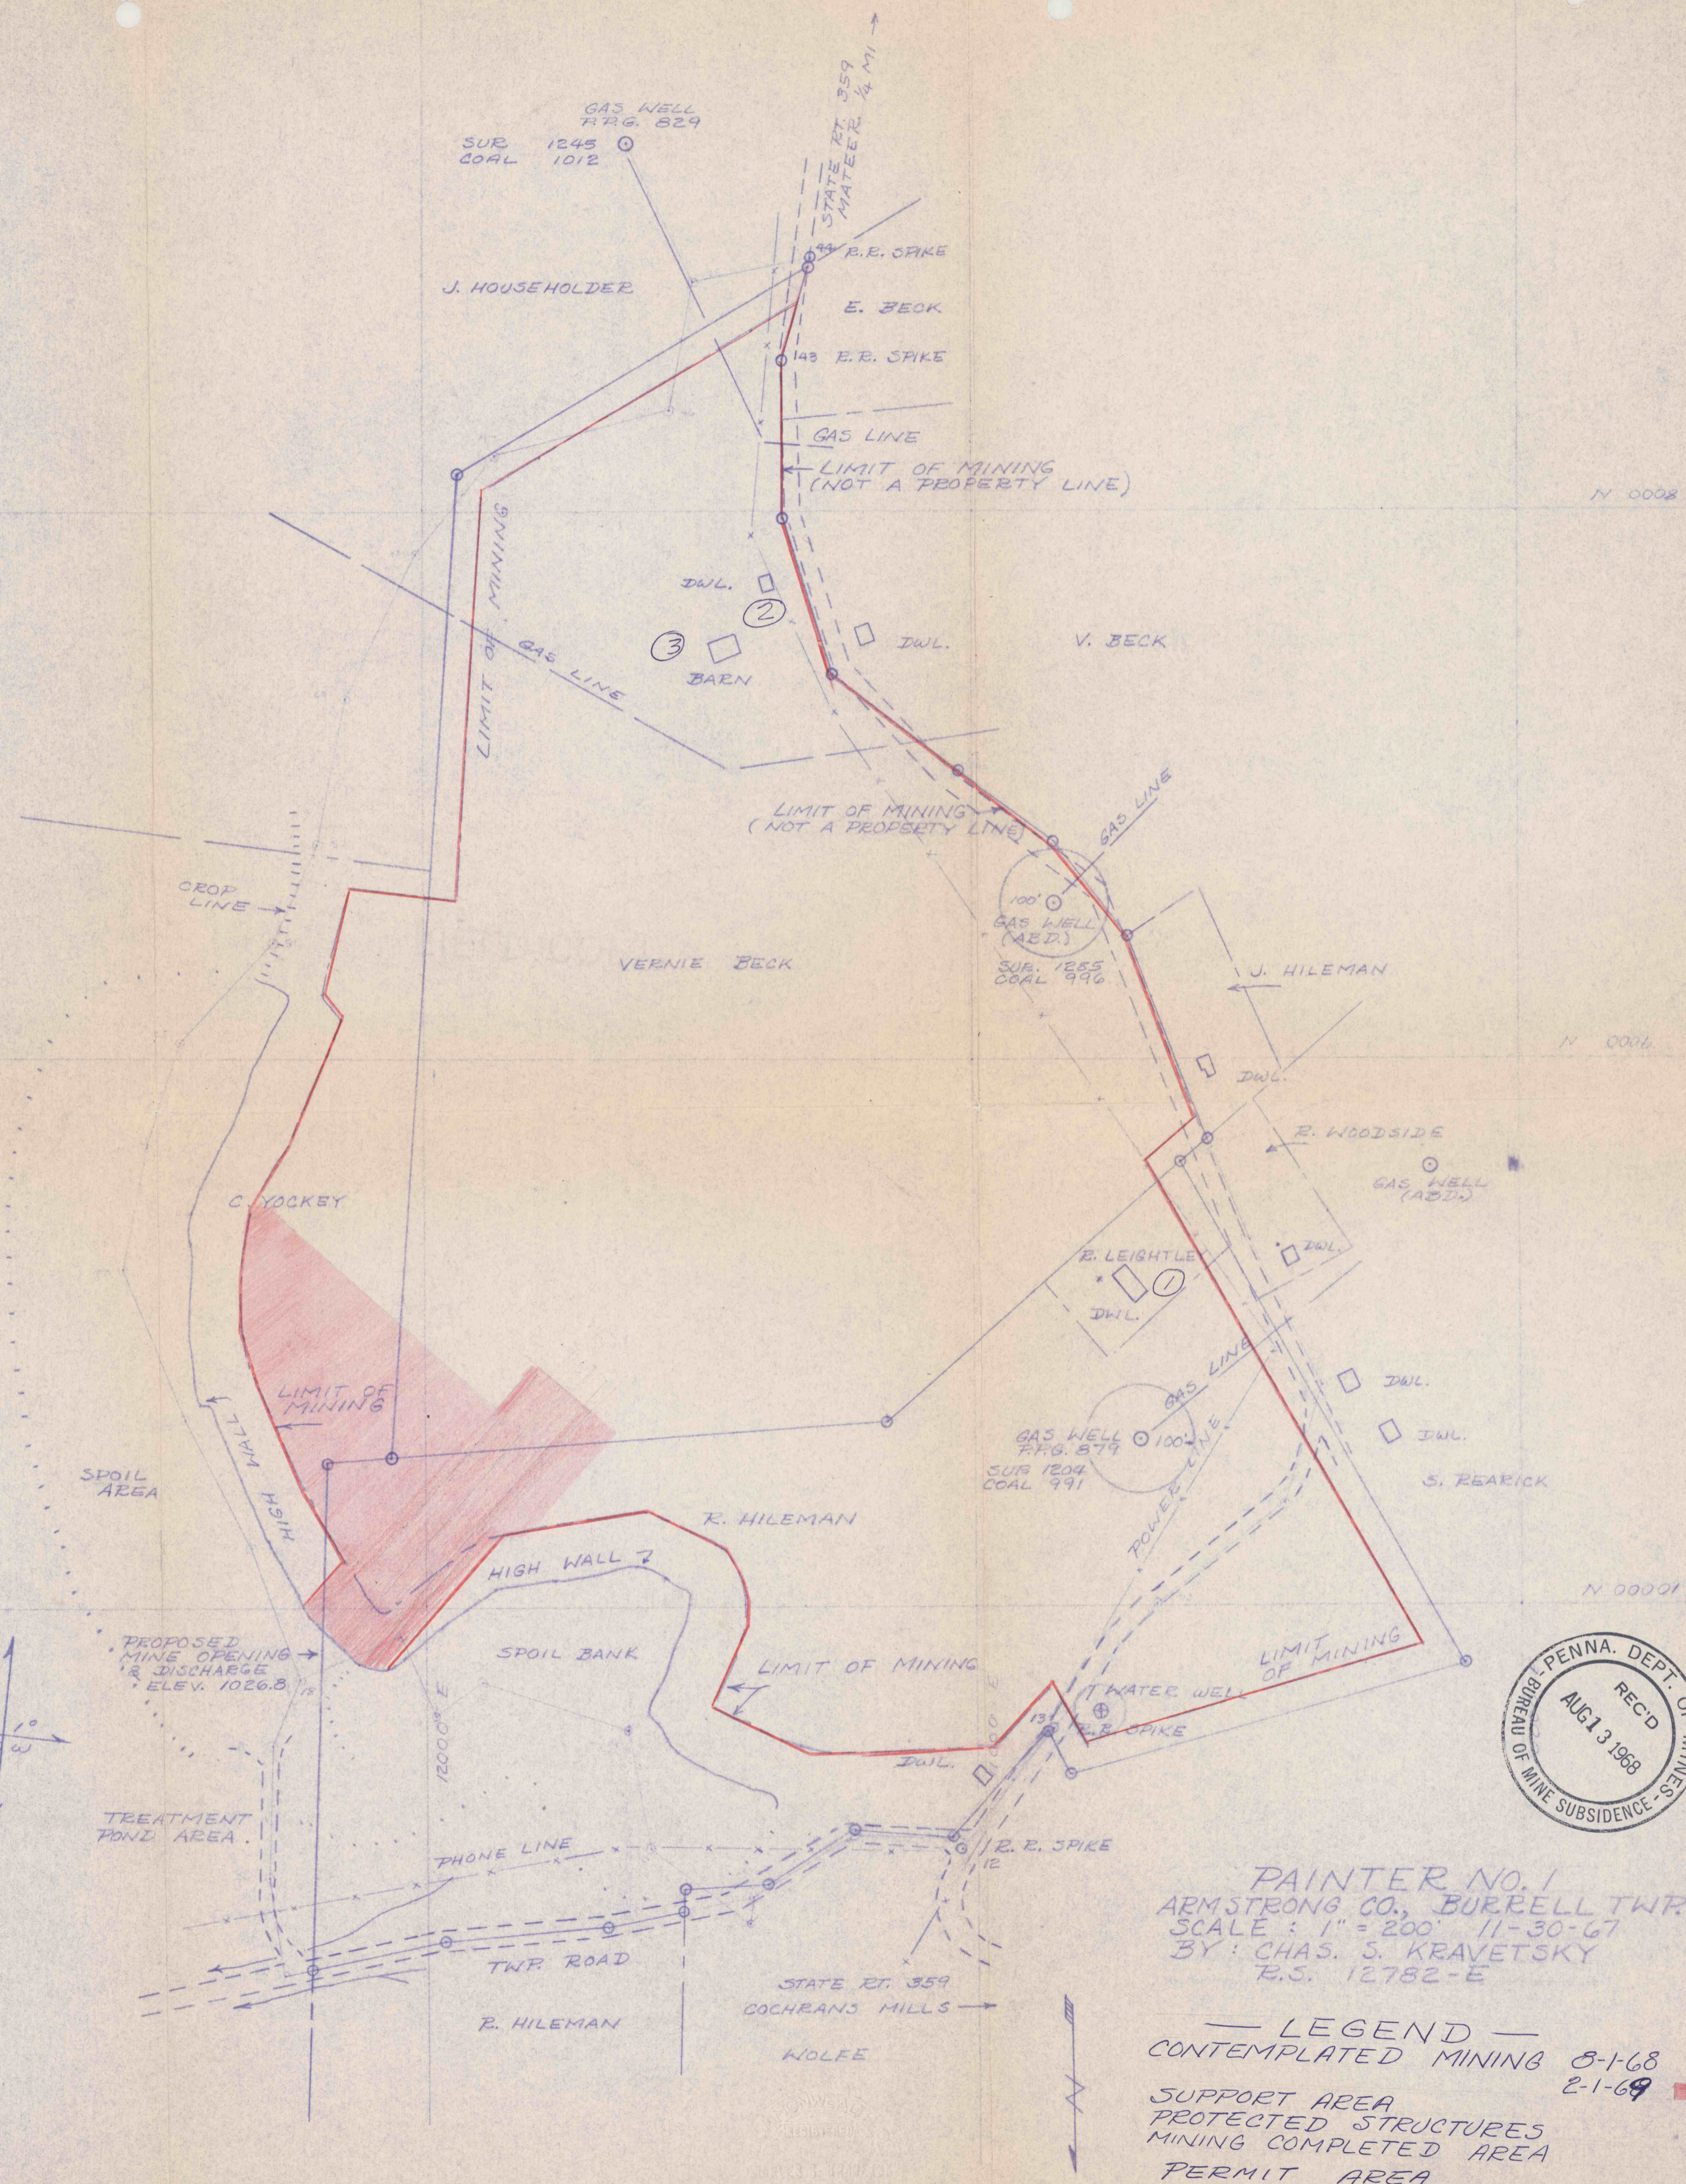


2020
12.28.99
C.C.

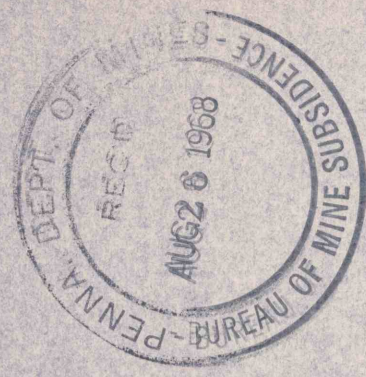

PAINTER NO. 1
ARMSTRONG CO., BURRELL TWP.
SCALE: 1" = 200' 11-30-67
BY: CHAS. S. KRAVETSKY
P.S. 12782-E

— LEGEND —
CONTEMPLATED MINING 8-1-68 TO 2-1-69
SUPPORT AREA
PROTECTED STRUCTURES
MINING COMPLETED AREA
PERMIT AREA

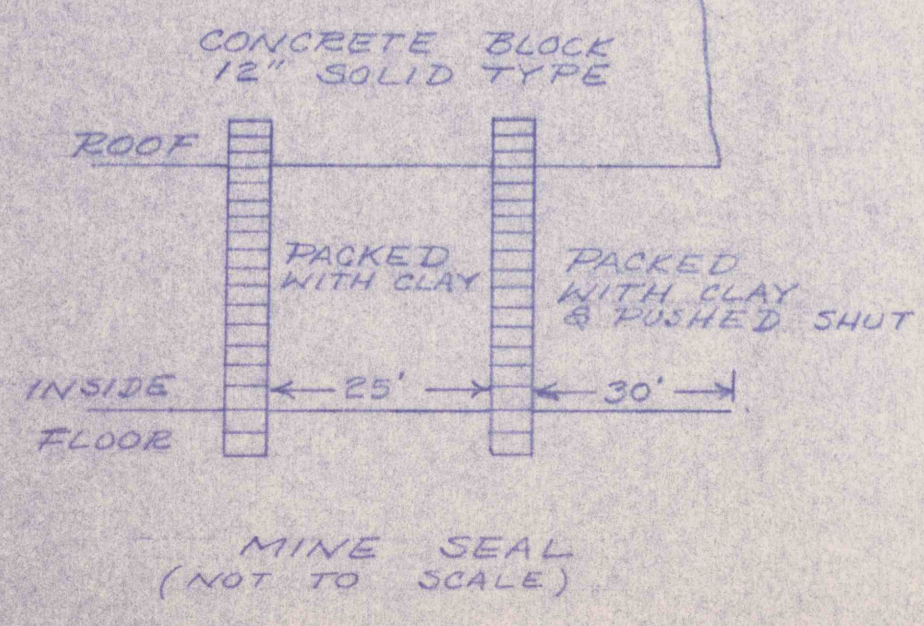

Charles S. Kravetsky