

**MAPLE CREEK MINING, INC.**  
**UMCO ENERGY, INC.**

**HIGH QUALITY MINE**  
**PITTSBURGH SEAM**


MSHA ID No. 36-08375  
 PA-DEP CMAP - 63921301

**FINAL MAP**

**OFFICES:**  
 981 ROUTE 917  
 BENTLEYVILLE, PA 15314


**PORTAL:**  
 1965 ROUTE 481  
 MONONGAHELA, PA 15063

**CARROLL TOWNSHIP &  
 FALLOWFIELD TOWNSHIP**  
 WASHINGTON COUNTY  
 COMMONWEALTH OF PENNSYLVANIA

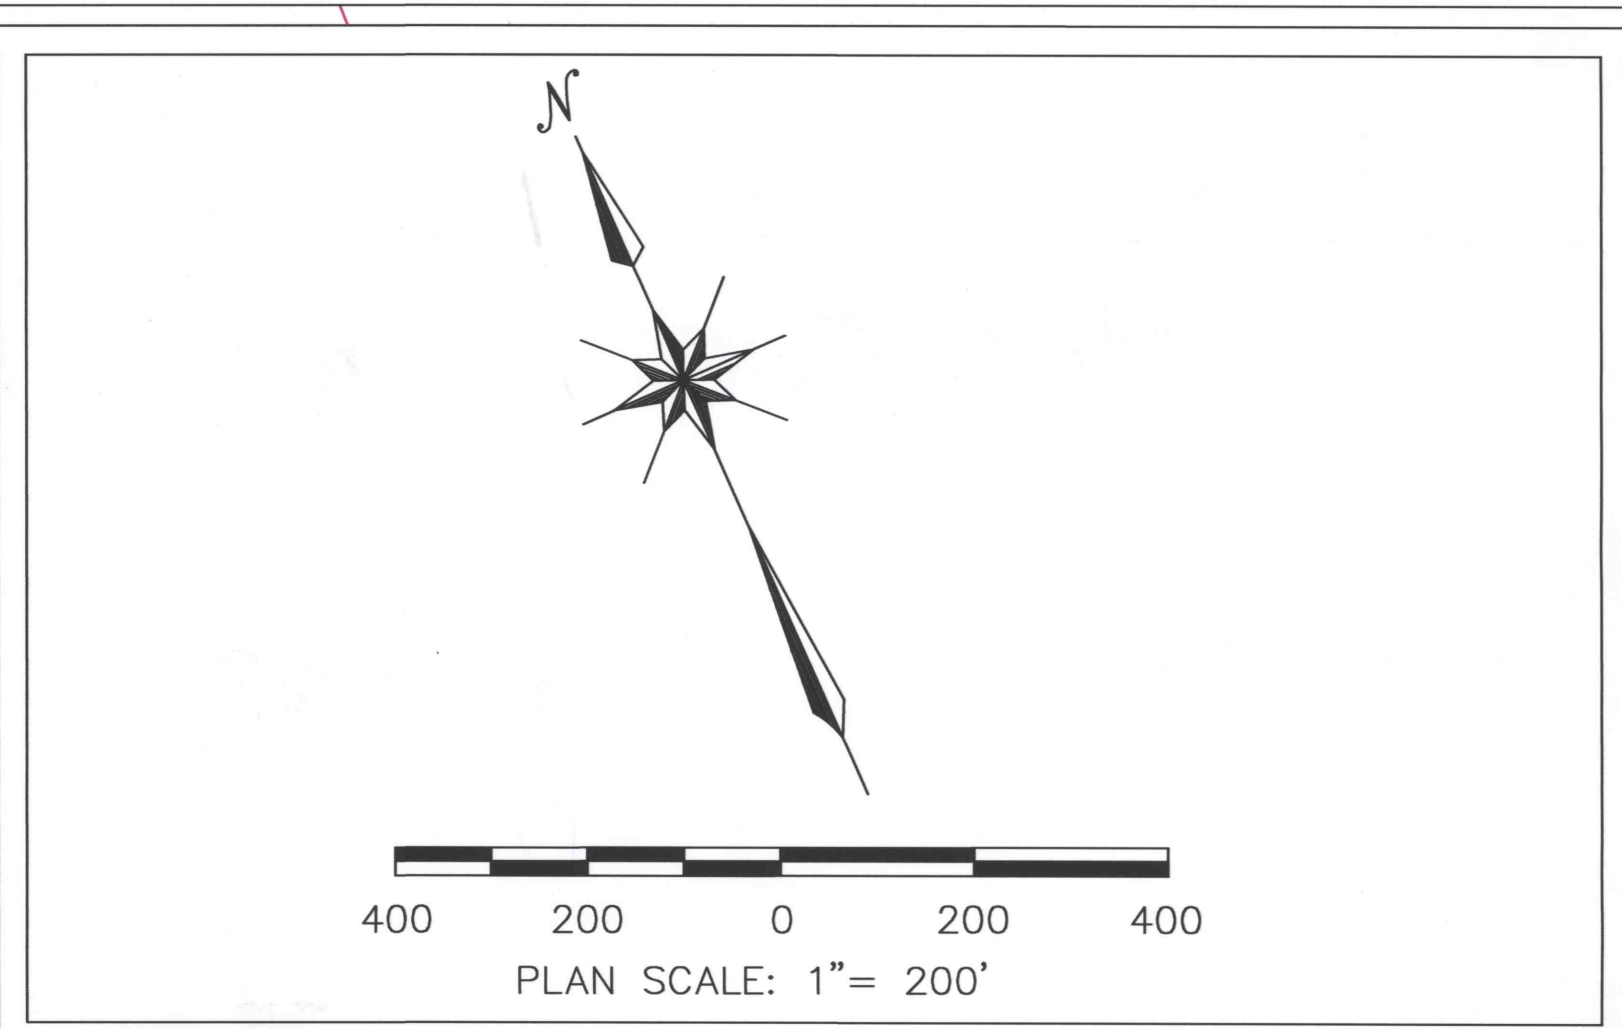

**LEGEND**

- GOB
- BASE LINE POINT
- SEAL
- LOCAL GRID
- STATE PLANE GRID
- PERMIT LINE

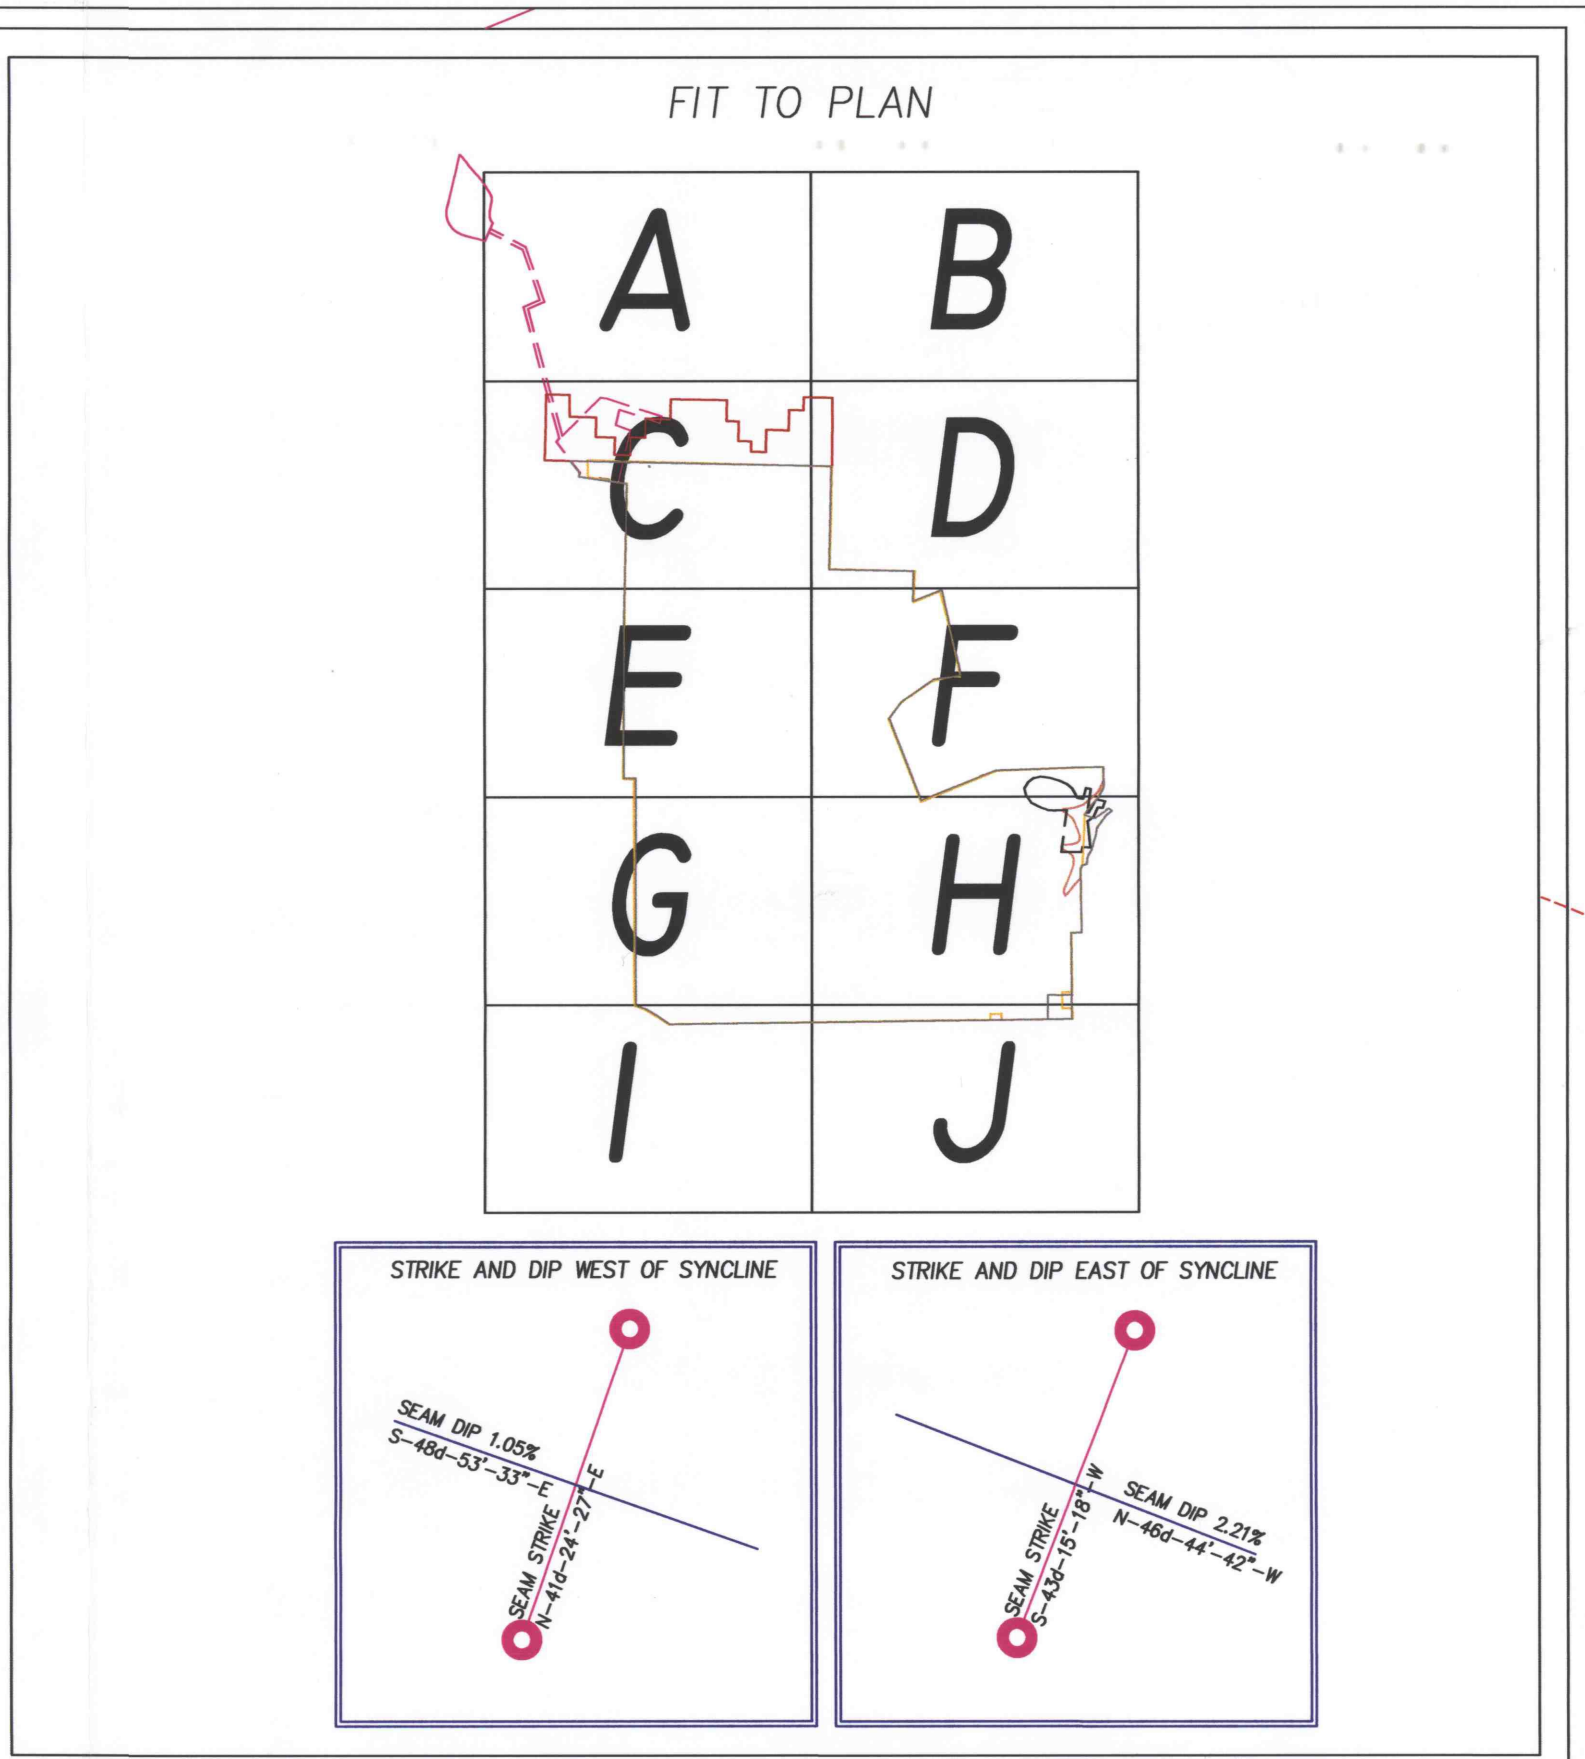

**NOTES:**

Date of last mining: February 24, 2005  
 No underground mining above or below High Quality Mine.  
 Closed loop survey (1 in 5,000 min.)

Base Monument Point No. 1  
 Local: N 91270.15 E -24256.11 Elev. 1,181.45 MSL  
 State Plane: N 308,674.18 E 1,382,639.02 "(NAD27)"

Base Monument Point No. 2  
 Local: N 91382.9 E -23748.3 Elev. 1,168.82 MSL  
 State Plane: N 308,785.94 E 1,383,153.79 "(NAD27)"

**CORPORATE OFFICERS'S STATEMENT**

This is the final map of UMCO Energy, Inc's, High Quality Mine. Mining as well as final mapping was completed on February 24, 2005. Coal was mined by both continuous and longwall mining methods. Mine sealing was completed on June 29, 2005. Based upon our knowledge and belief, this map presents a complete and accurate representation of all excavations and is the "final map".

1/9/06  
 Michael B. Gardner Date  
 Secretary  
 UMCO Energy, Inc.

W. Harry Springer, P.E.  
 DATE: 01-09-06

FIT To - B