
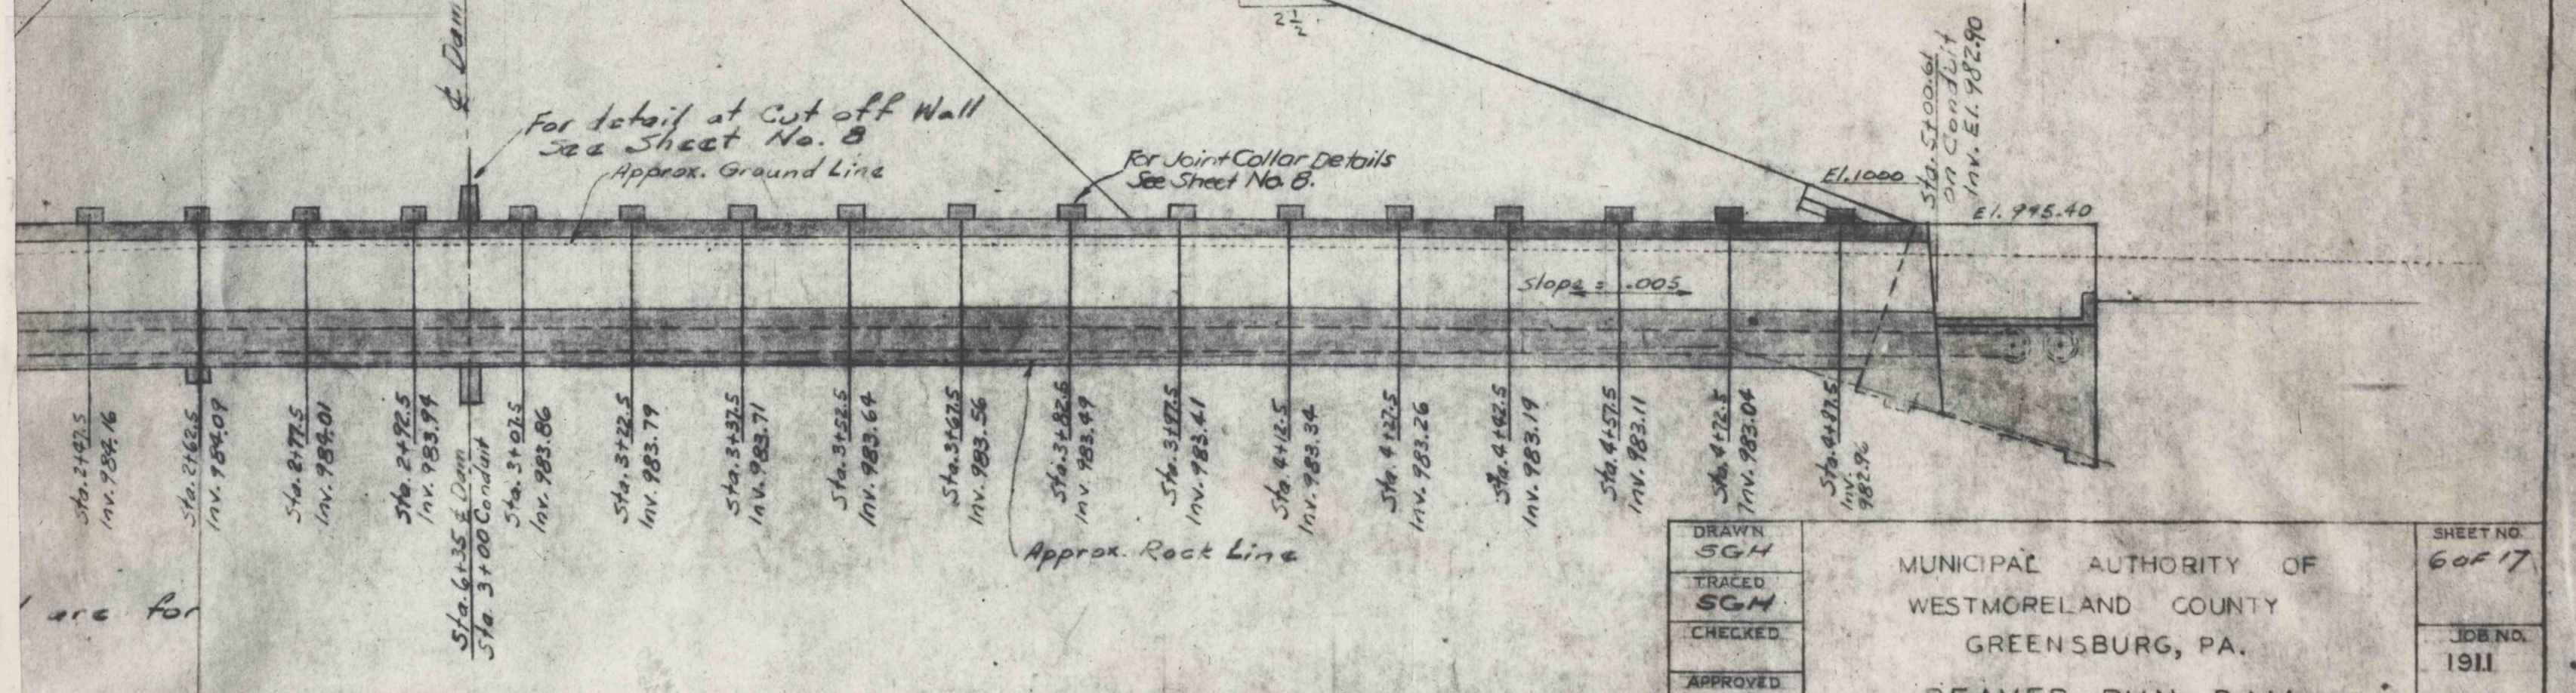
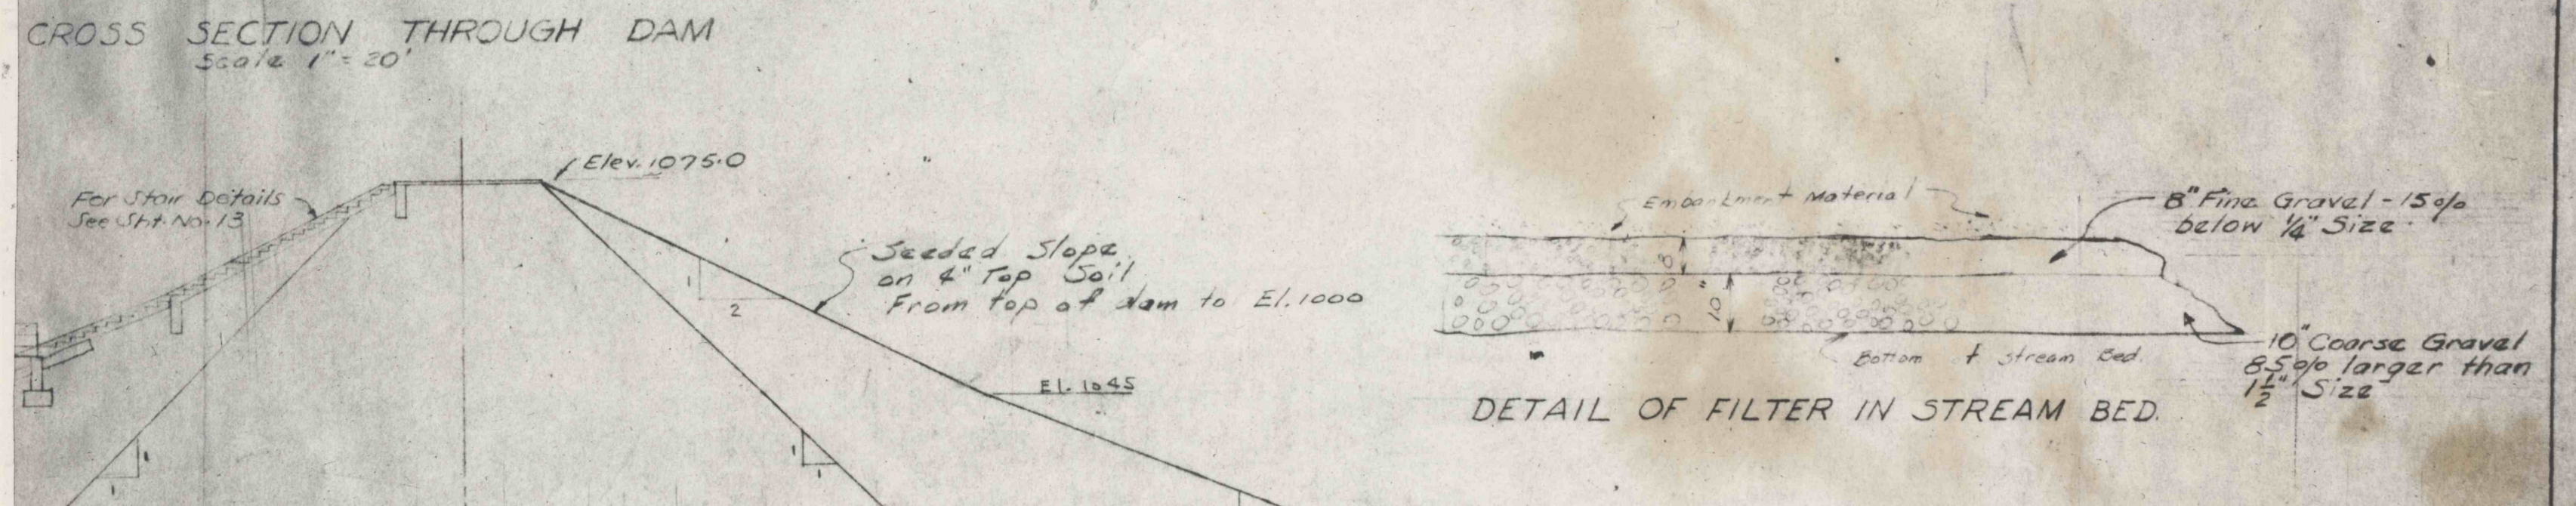
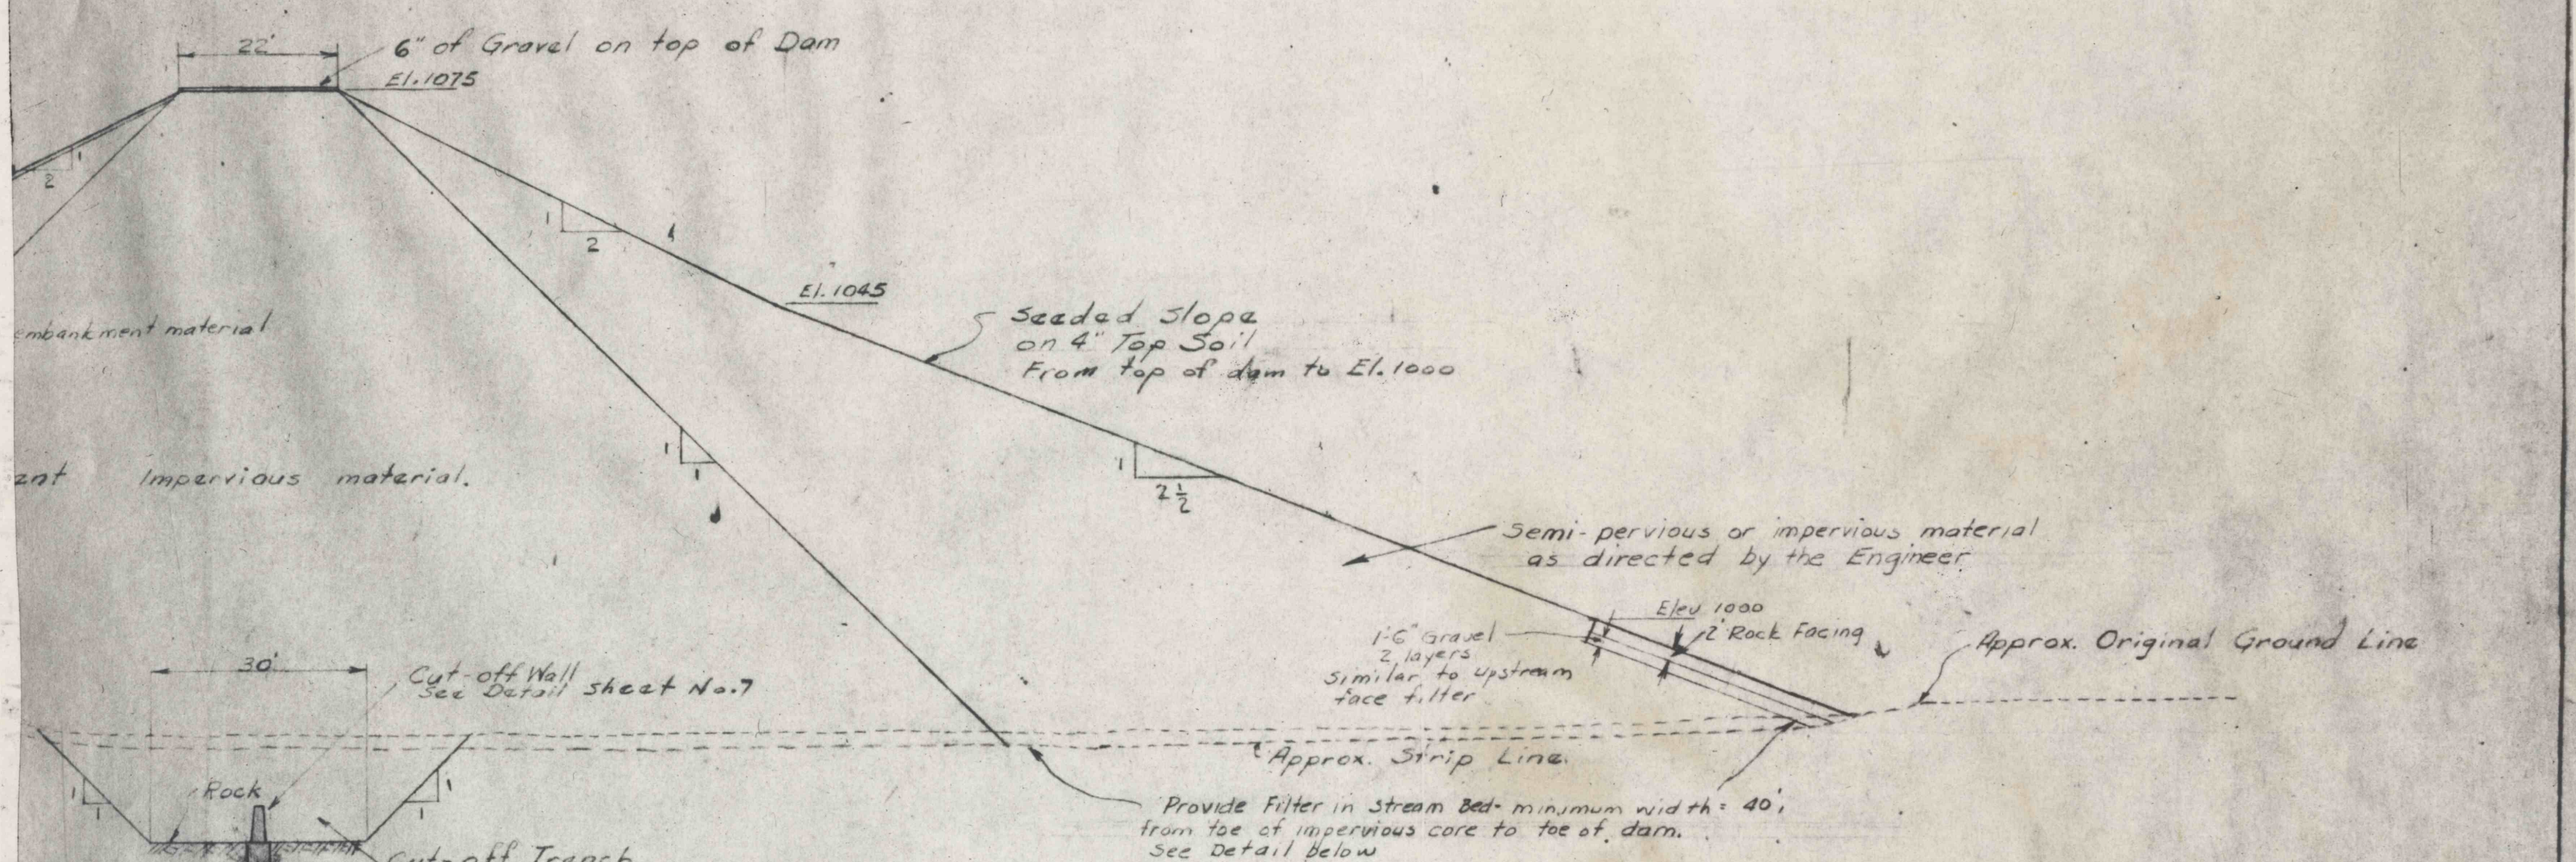


of project measurements

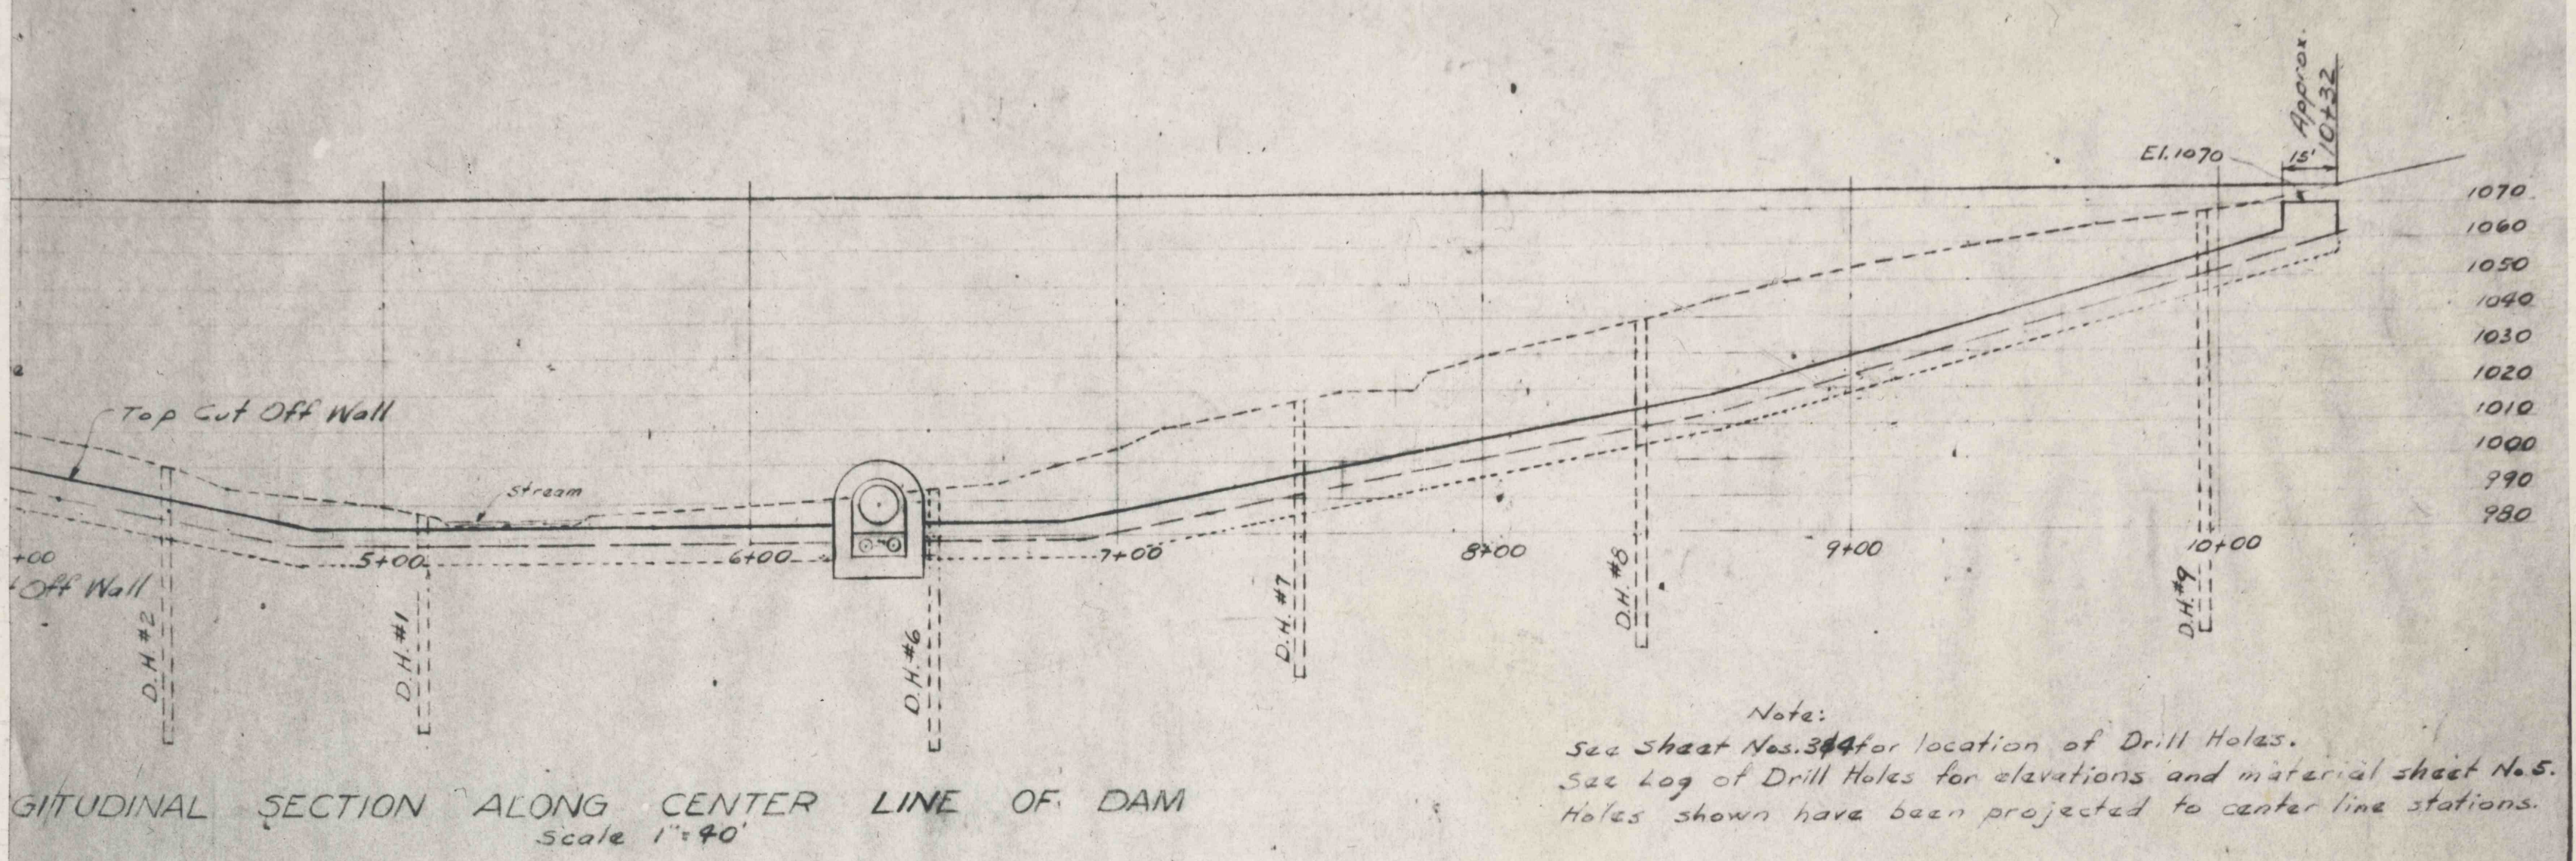

| | | | | | | | | | | | | | | | | |
|----------------------------|----------------------------|----------------------------|-----------------------------------|----------------------------|----------------------------|----------------------------|----------------------------|----------------------------|----------------------------|----------------------------|----------------------------|----------------------------|----------------------------|----------------------------|----------------------------|----------------------------|

|----------------------------|----------------------------|----------------------------|-----------------------------------|----------------------------|----------------------------|----------------------------|----------------------------|----------------------------|----------------------------|----------------------------|----------------------------|----------------------------|----------------------------|----------------------------|----------------------------|----------------------------|

| | | |
|--------------------|--|-----------------------|
| DRAWN SGH | MUNICIPAL AUTHORITY OF WESTMORELAND COUNTY GREENSBURG, PA. BEAVER RUN DAM | SHEET NO. 60 of 17 |
| TRACED SGH | | IDB NO. 1911 |
| CHECKED | | |
| APPROVED J.D.C. | | |

MISCELLANEOUS SECTIONS THROUGH DAM

SCALE - AS SHOWN APRIL 1950
GANNETT FLEMING CORDRY & CARPENTER, INC.
ENGINEERS HARRISBURG, PA.



Drop Inlet Rock Top & Filter Revised - J.D.W. 5-15-51 CER.

C-100