



BULKHEAD SPECIFICATIONS

| BULKHEAD | ENTRY WIDTH ① | DISTANCE BETWEEN WALLS ② | REINFORCING BAR SPACING | |
|----------|------------------|-----------------------------|-------------------------|-------|
| | | | HORIZ. | VERT. |
| "A" | 10'± | 6" | 4" | 24" |
| "B" | 12'± | 4" | 6" | 24" |
| "C" | 12'± | 4" | 6" | 24" |
| "D" | 10'± | 4" | 8" | 24" |
| "E" | 10'± | 4" | 8" | 24" |
| "F" | 12'± | ZERO | NONE | |

Reinforcing Bars - $\frac{3}{8}$ " ϕ

Cement mix -

Footers 1:2:3 mix
Grout 1:2 mix

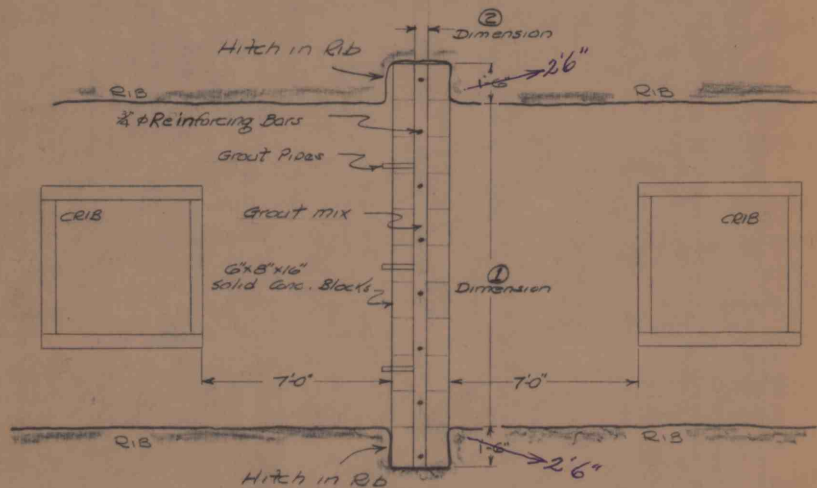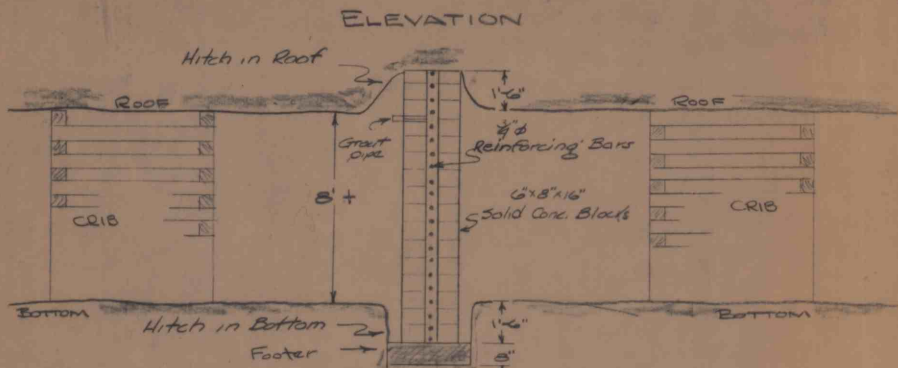

PLAN OF BULKHEAD

SCALE $\frac{1}{4}$ " = 1'-0"

| NO. RECD. | NO. RECD. | MARK | MATERIAL | DESCRIPTION | REMARKS | EST. WGT. |
|-------------------------|-----------|------|----------|-------------|---------|-----------|
| BILL OF MATERIAL | | | | | | |
| REFERENCE DRAWINGS: | | | | | | |
| REVISION | | | | | | |
| NO. | DATE | BY | | | | |
| 1 | | | | | | |
| 2 | | | | | | |
| | |
|-----------------------------------|-------------------------|
| REPUBLIC STEEL CORPORATION | |
| DISTRICT | |
| WORKS | BANNING NO. 3 MINE |
| DEPARTMENT | PROPOSED BULKHEAD |
| SCALE | $\frac{1}{4}$ " = 1'-0" |
| DRAWN | T.B.A. DATE 1-18-60 |
| CHECKED | DATE |
| CHECKED | DATE |
| CHECKED | DATE |
| APPROVED | DATE |

C-535

Eng. 659-500 6-50