


PLAN VIEW

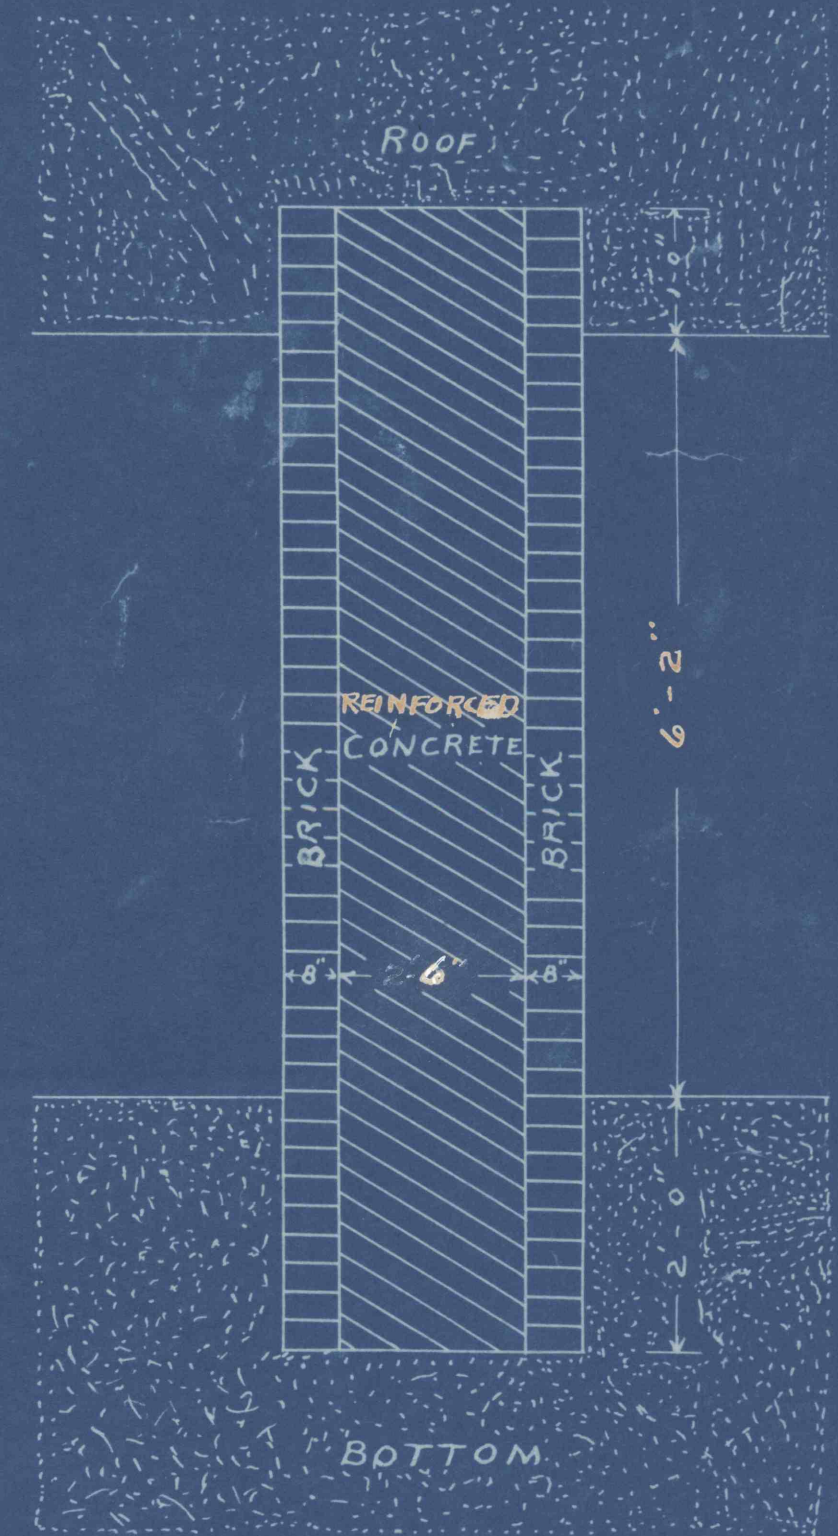

END VIEW

DAM PLAN NUMBER 2
 FOR
 VALLEY MINE
 AVONMORE COAL AND COKE CO.
 NOT TO SCALE JUNE 28 1951
 ENGINEERING DEPT HICKS COAL INT'S