


PLAN VIEW

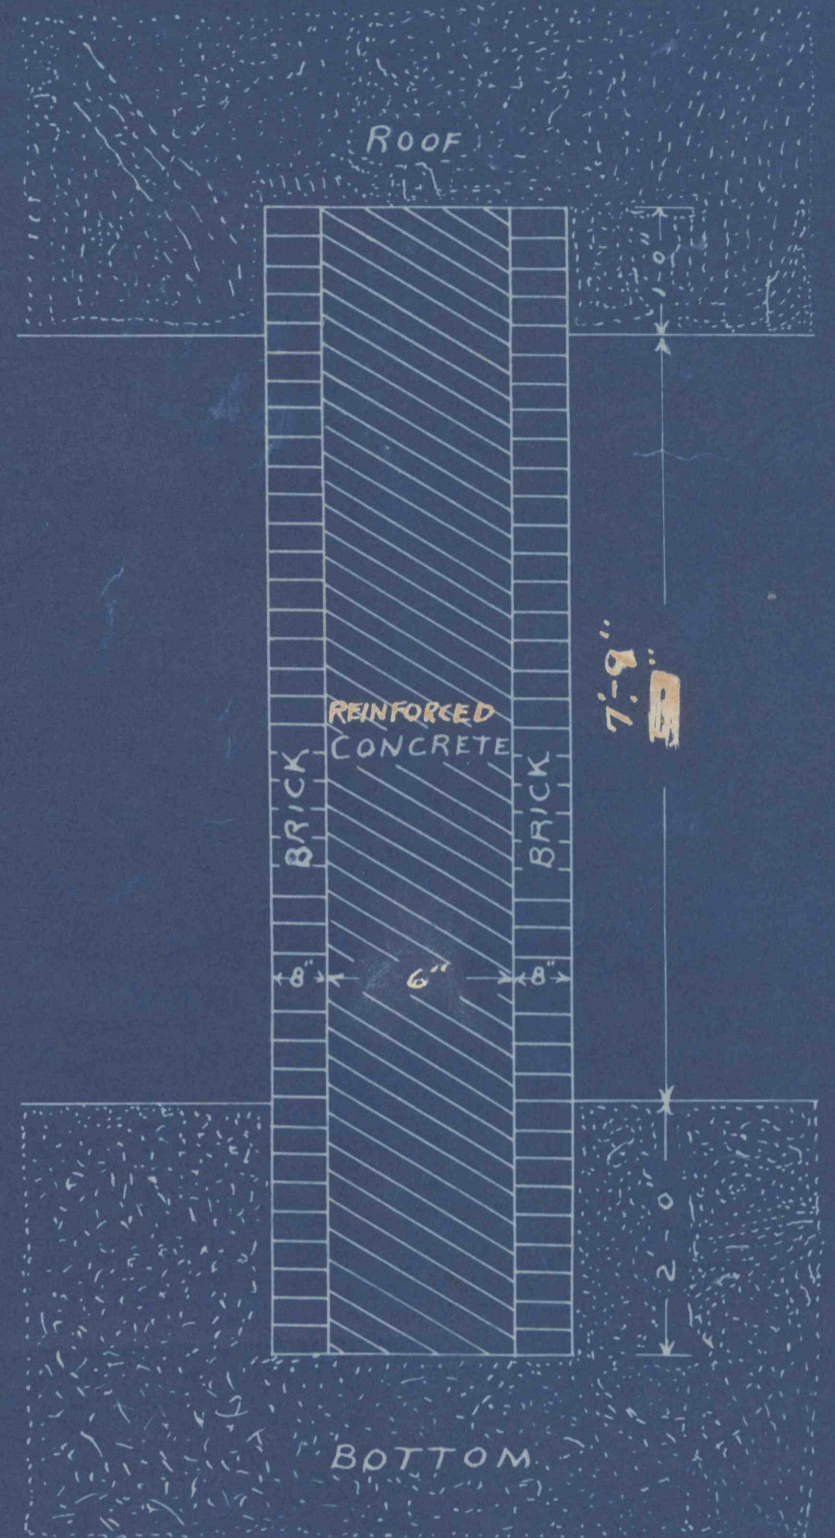

END VIEW

DAM PLAN NUMBER 1  
 FOR  
 VALLEY MINE  
 AVONMORE COAL AND COKE CO.  
 NOT TO SCALE      JUNE 28 1951  
 ENGINEERING DEPT HICKS COAL INT'S