
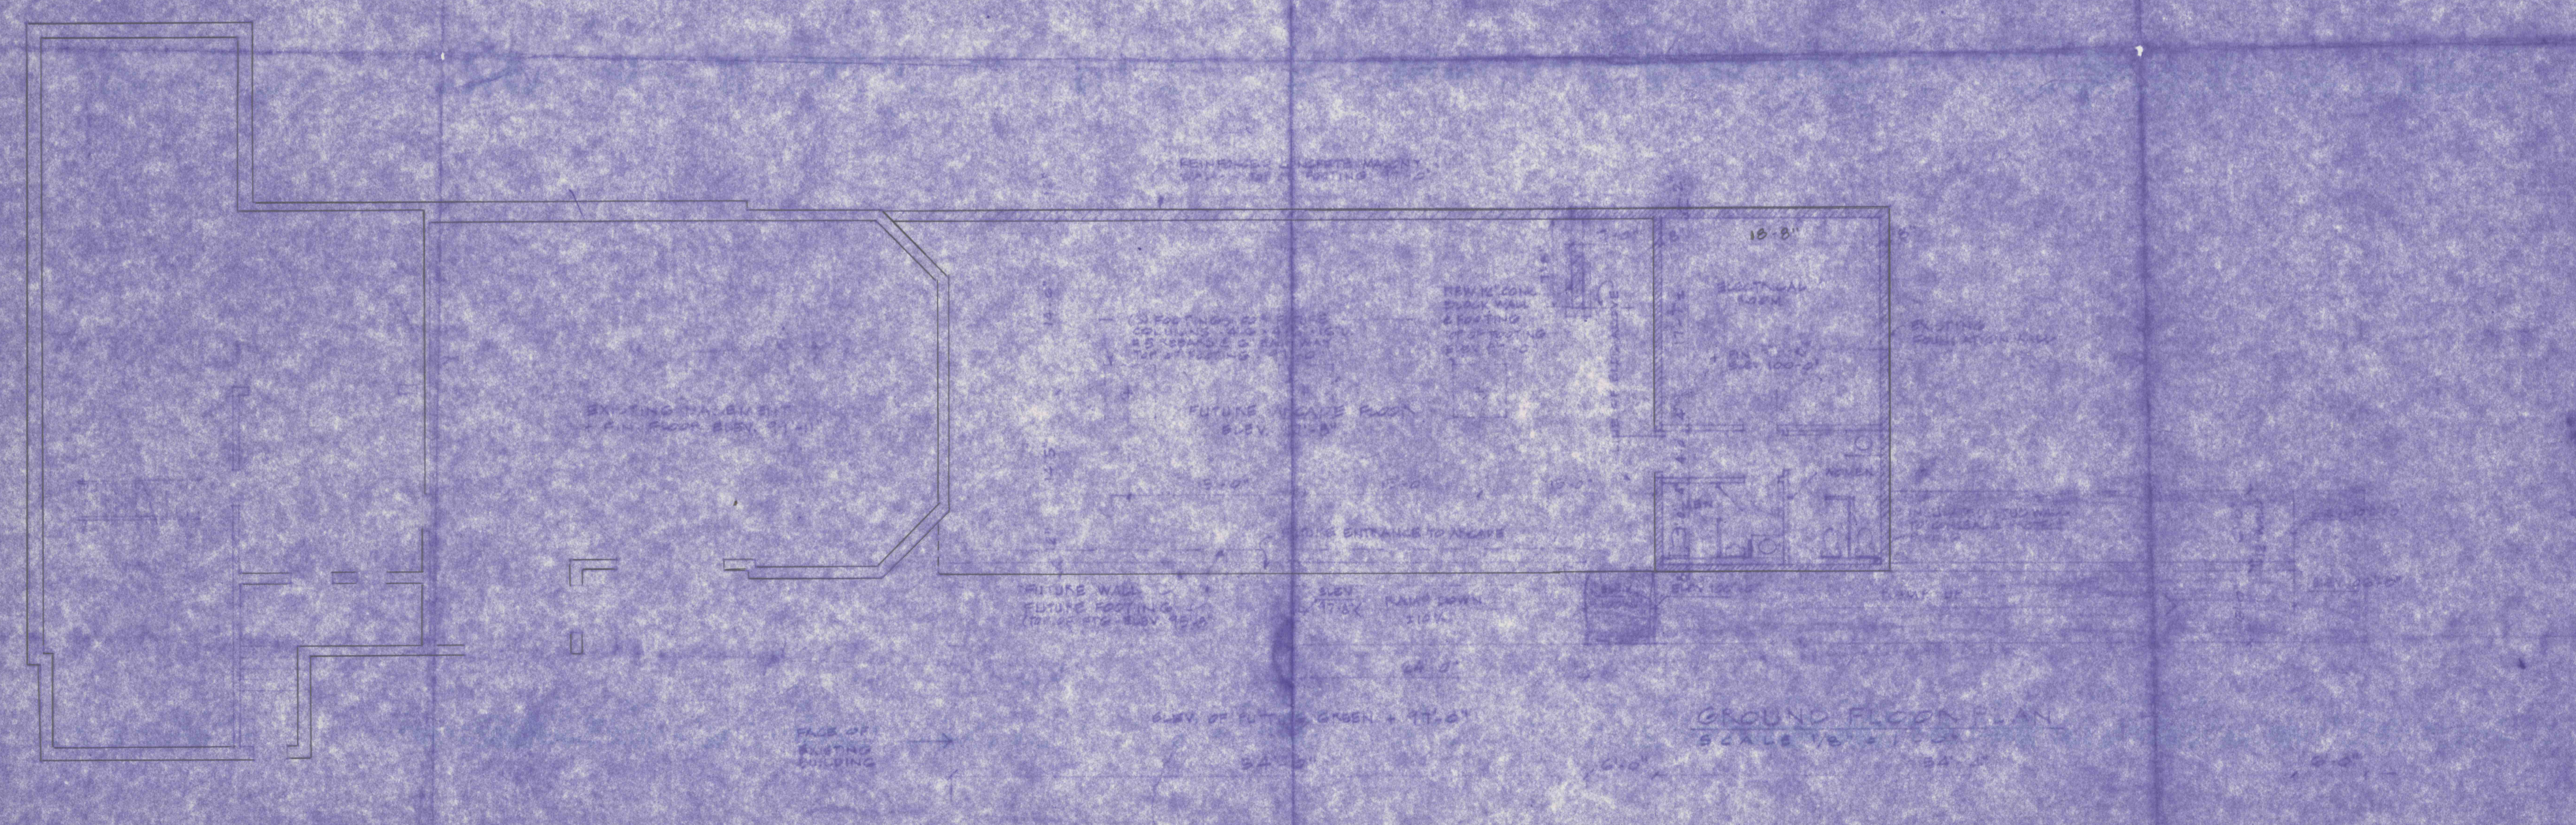


REVISED
 Nov 10 1987
 St. Col. 16005
 81/233 - GOLF

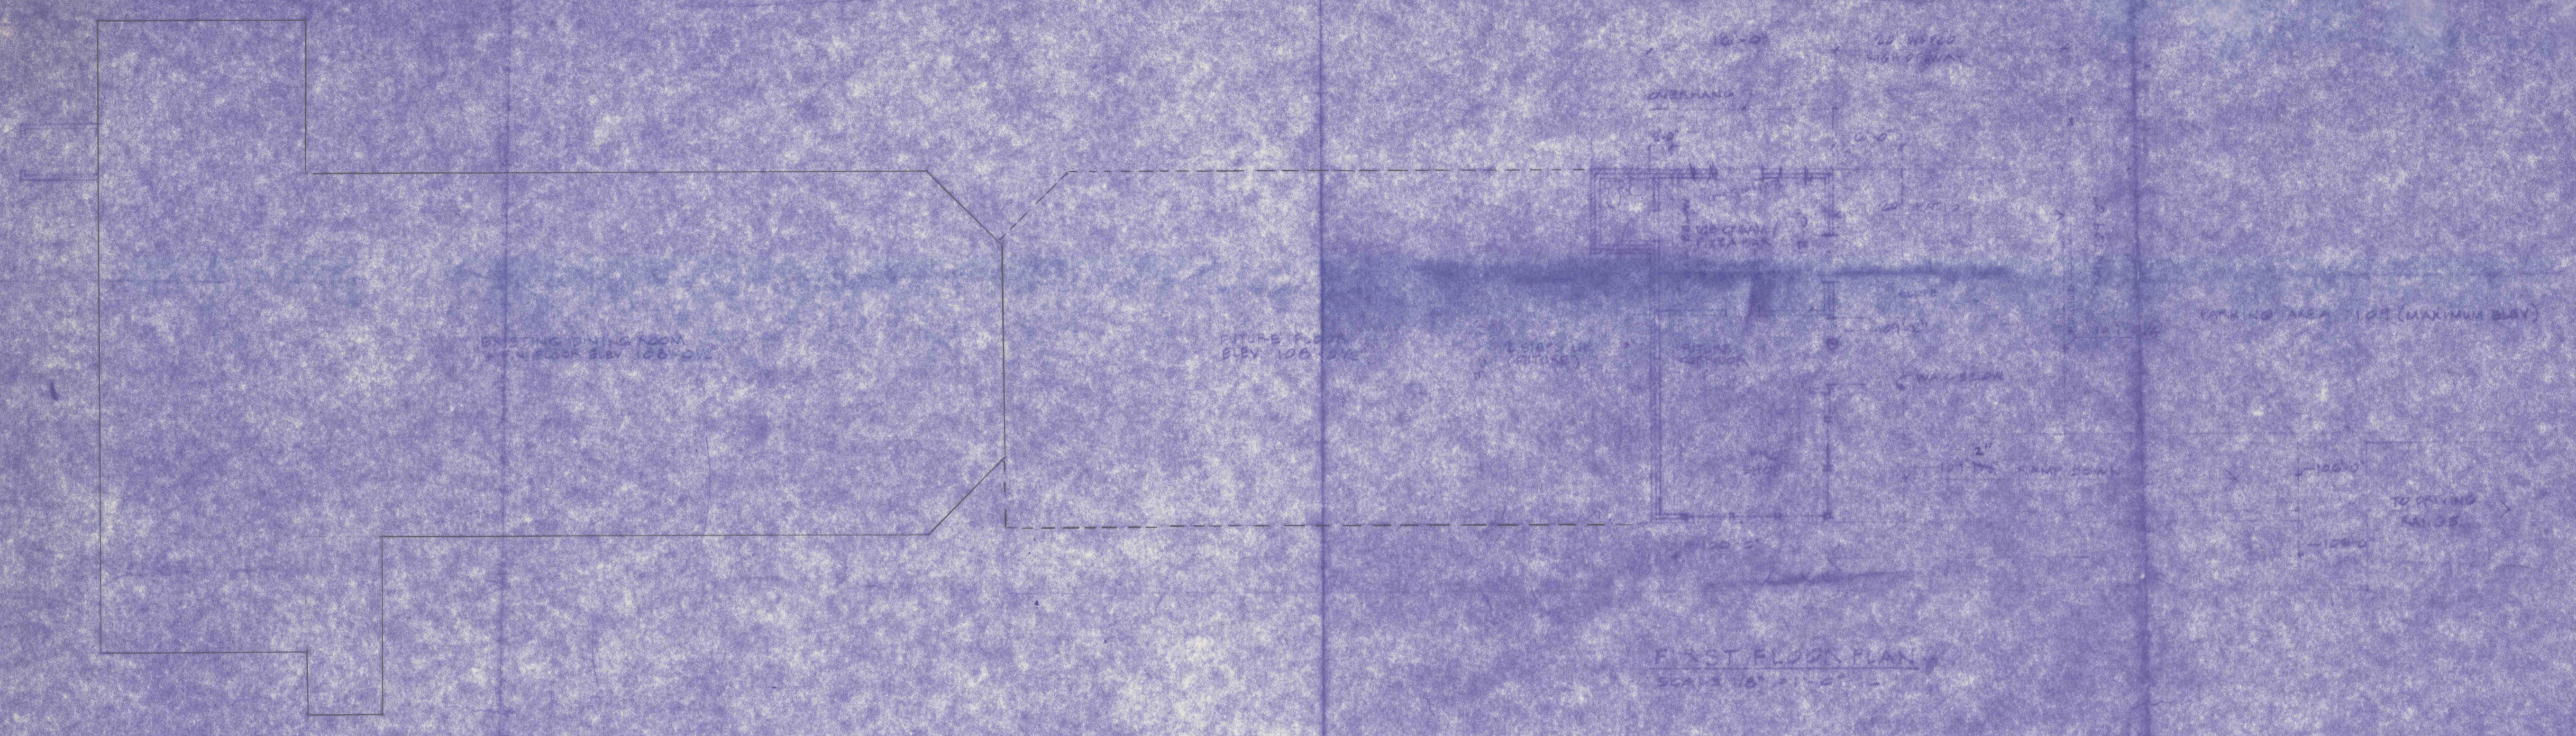

ICE CREAM / SHOES
 CONSTRUCTION
 ROUTE 244, AVELLA, PA 15102