


West 2777-8-5

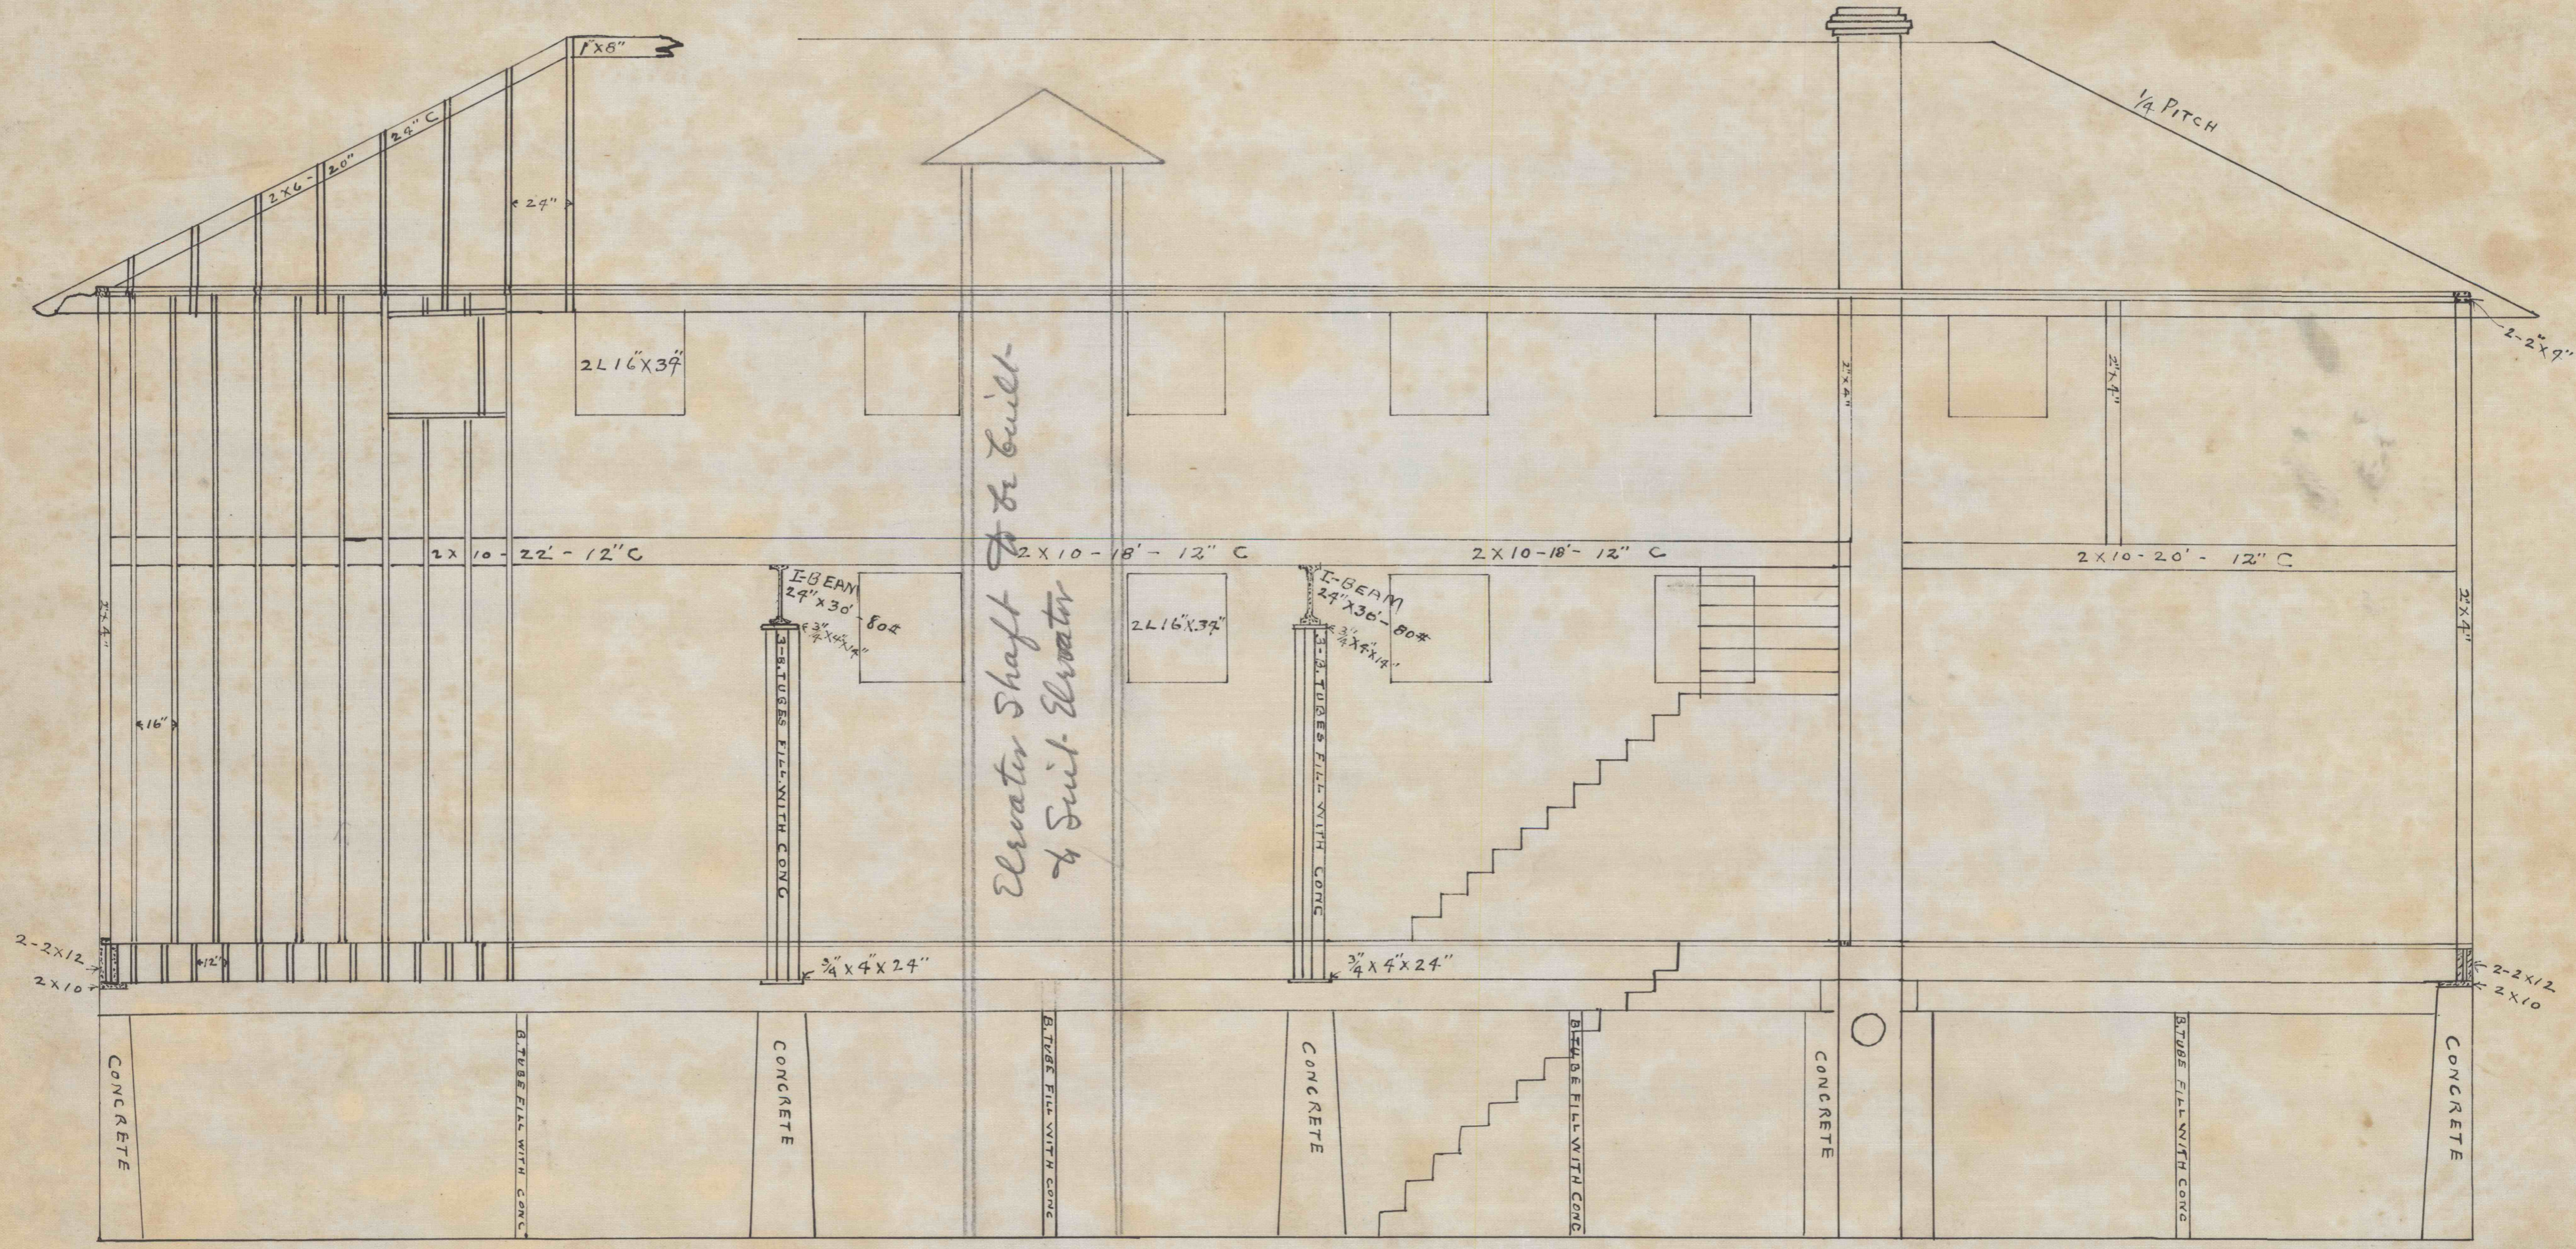

SIDE ELEVATION

West 4613/7