


West - 413/9

CONCRETE STEPS
FIRST FLOOR PLAN
FIRST FLOOR PLAN

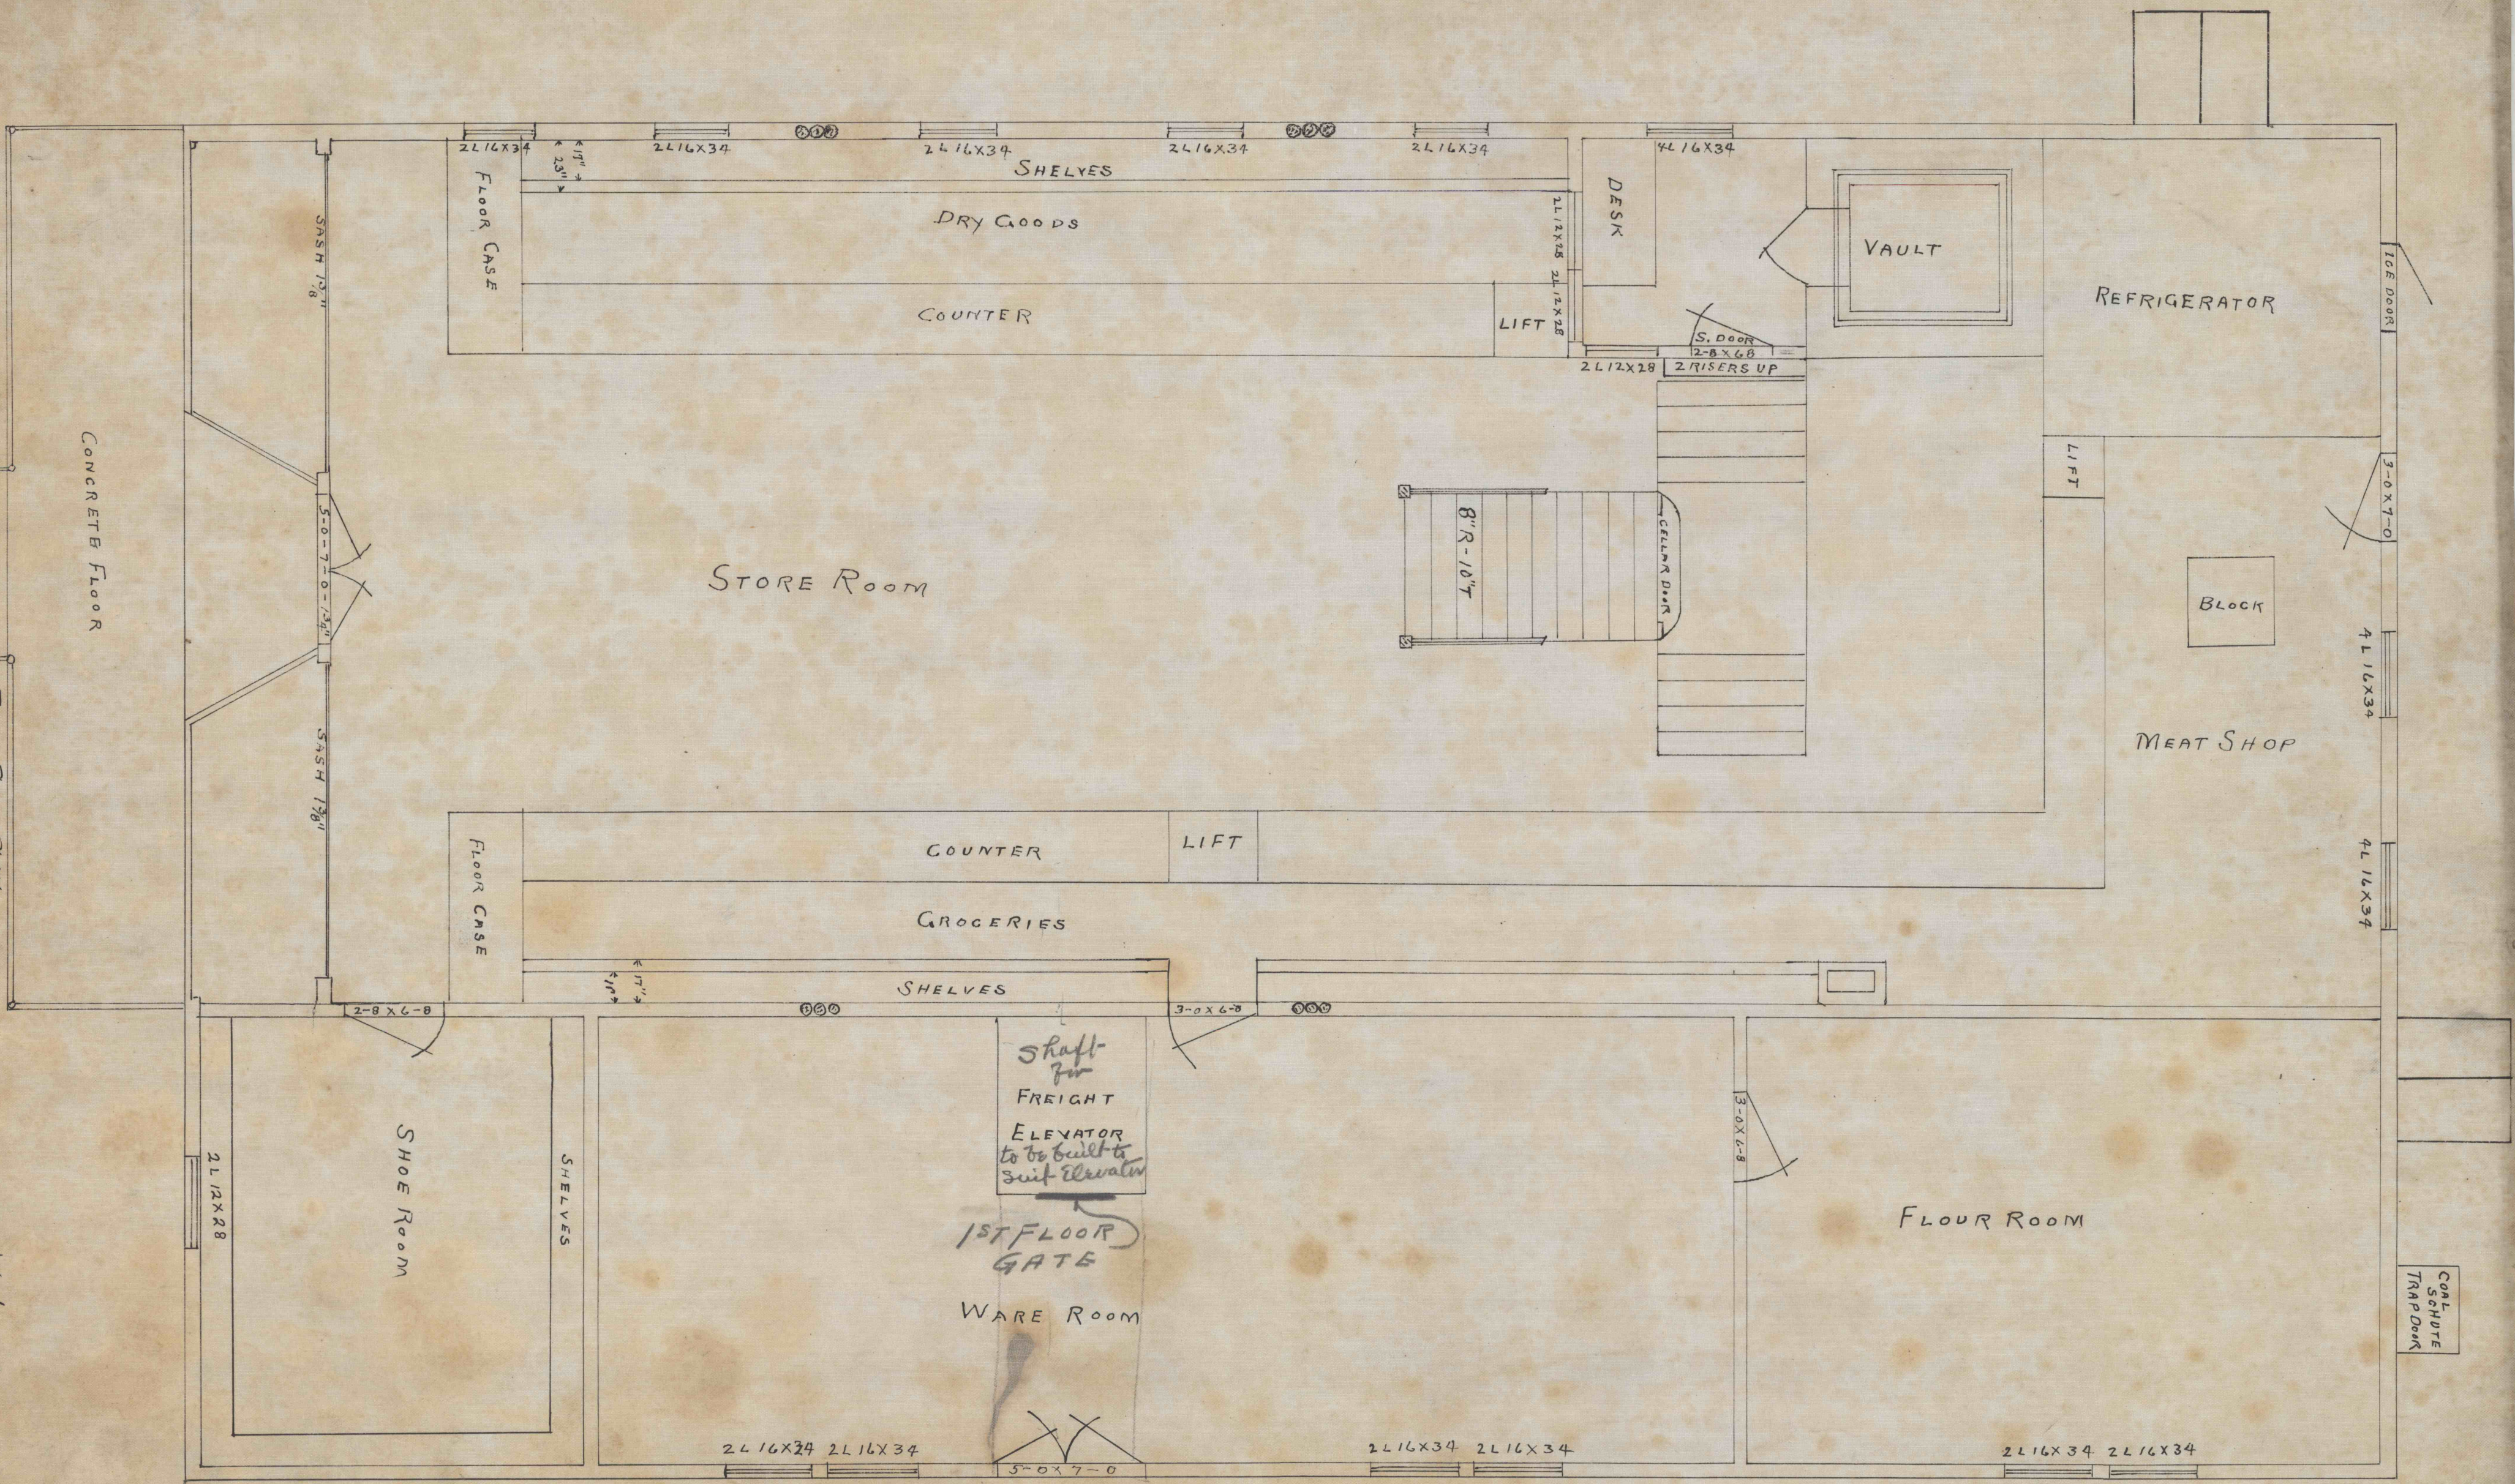

CORL SCHUTE TRAP DOOR

West 413/9