COAL PROPERTY

OWNED BY

WALTER M. GOODWIN

SITUATE IN

GEORGES TWP. FAYETTE CO., PA.

SCALE:- 1 INCH = 100 FEET.

HOMER L. BURCHINAL

ENGINEER

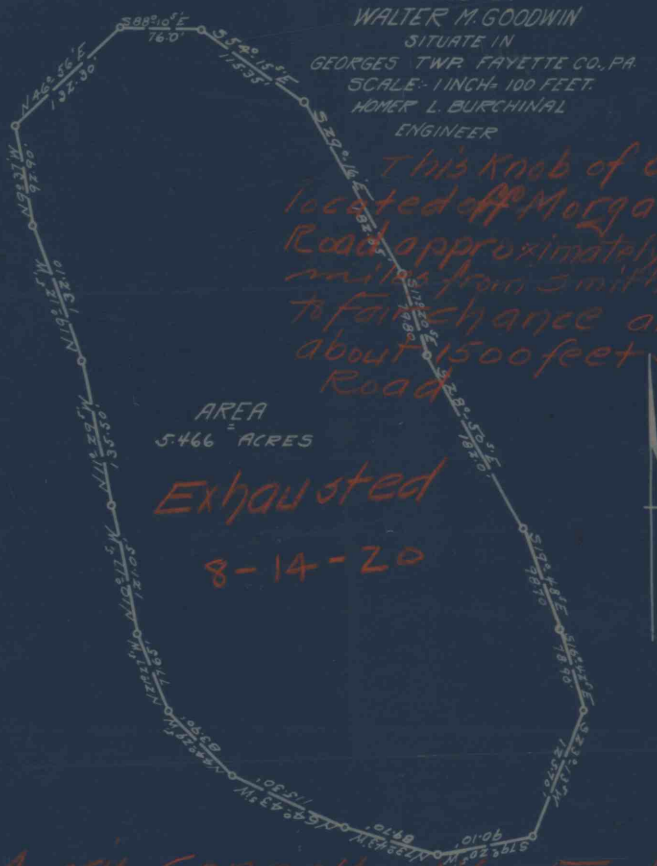

This Knob of Coal is located off Morgantown Road approximately 1¼ miles from Smithfield to Farmchance and about 1500 feet S.E. of Road

Exhausted

8-14-20

Morris Connellsville Fuel Co

Pittsburg Coal.

1-5-43