


M. HESS

H. K. MILLER

N

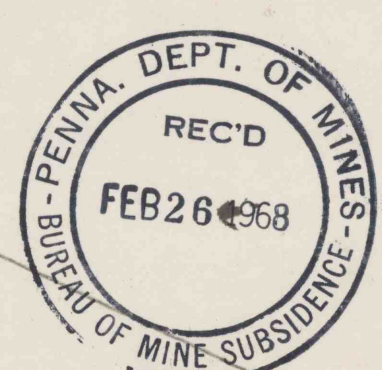

E. J. R. Edward J. Redilla

LEGEND


Contemplated Mining ~~9-1-67 to 3-1-68~~ 3-1-68 to 9-1-68

Support Area

Protected Structures

Mining Completed Area

Boundary Line

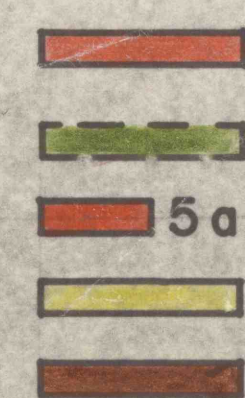

CRICHTON COAL & COKE CO.
 VIRGINIA NO. 20 MINE
 BRUSH VALLEY & CENTER TWPS.
 INDIANA COUNTY, PA.
 SCALE 1"=100' SURVEY DATE ~~8-31-67~~ 2-15-68

TO SHEET NO. 7

SHEET NO. 10

JOIN TO SHEET NO. 7

