


JOIN TO SHEET

JOIN TO SHEET NO. 7

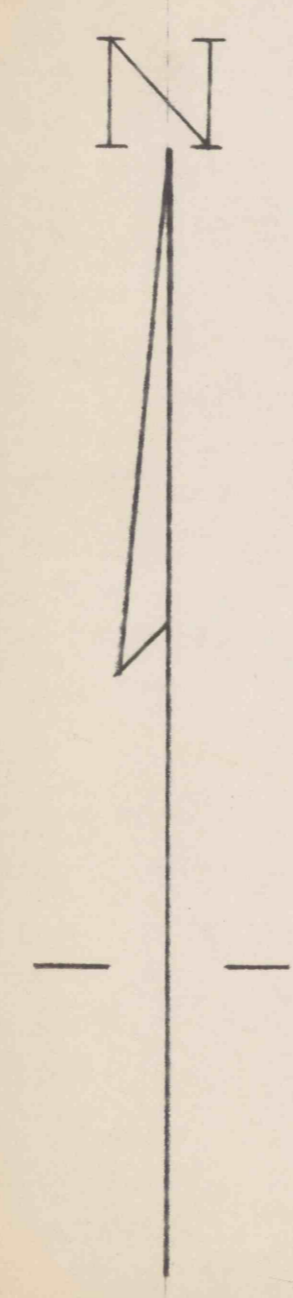


Gas Lines



JOHN DEYARMIN

H. MILLER

GAS WELL 150' BARRIER

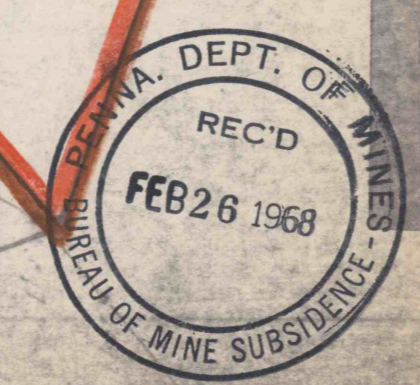

LEGEND		CRICHTON COAL & COKE CO.	
Contemplated Mining	9-1-67 to 3-1-68		VIRGINIA NO. 20 MINE
Support Area	3-1-68 to 9-1-68		BRUSH VALLEY & CENTER TWPS.
Protected Structures			INDIANA COUNTY, PA.
Mining Completed Area			SCALE 1"=100' SURVEY DATE 8-31-67
Boundary Line			2-15-68

SHEET NO. 9

82.0
Edward J. Kella