


C1-D1  
Sec. D9

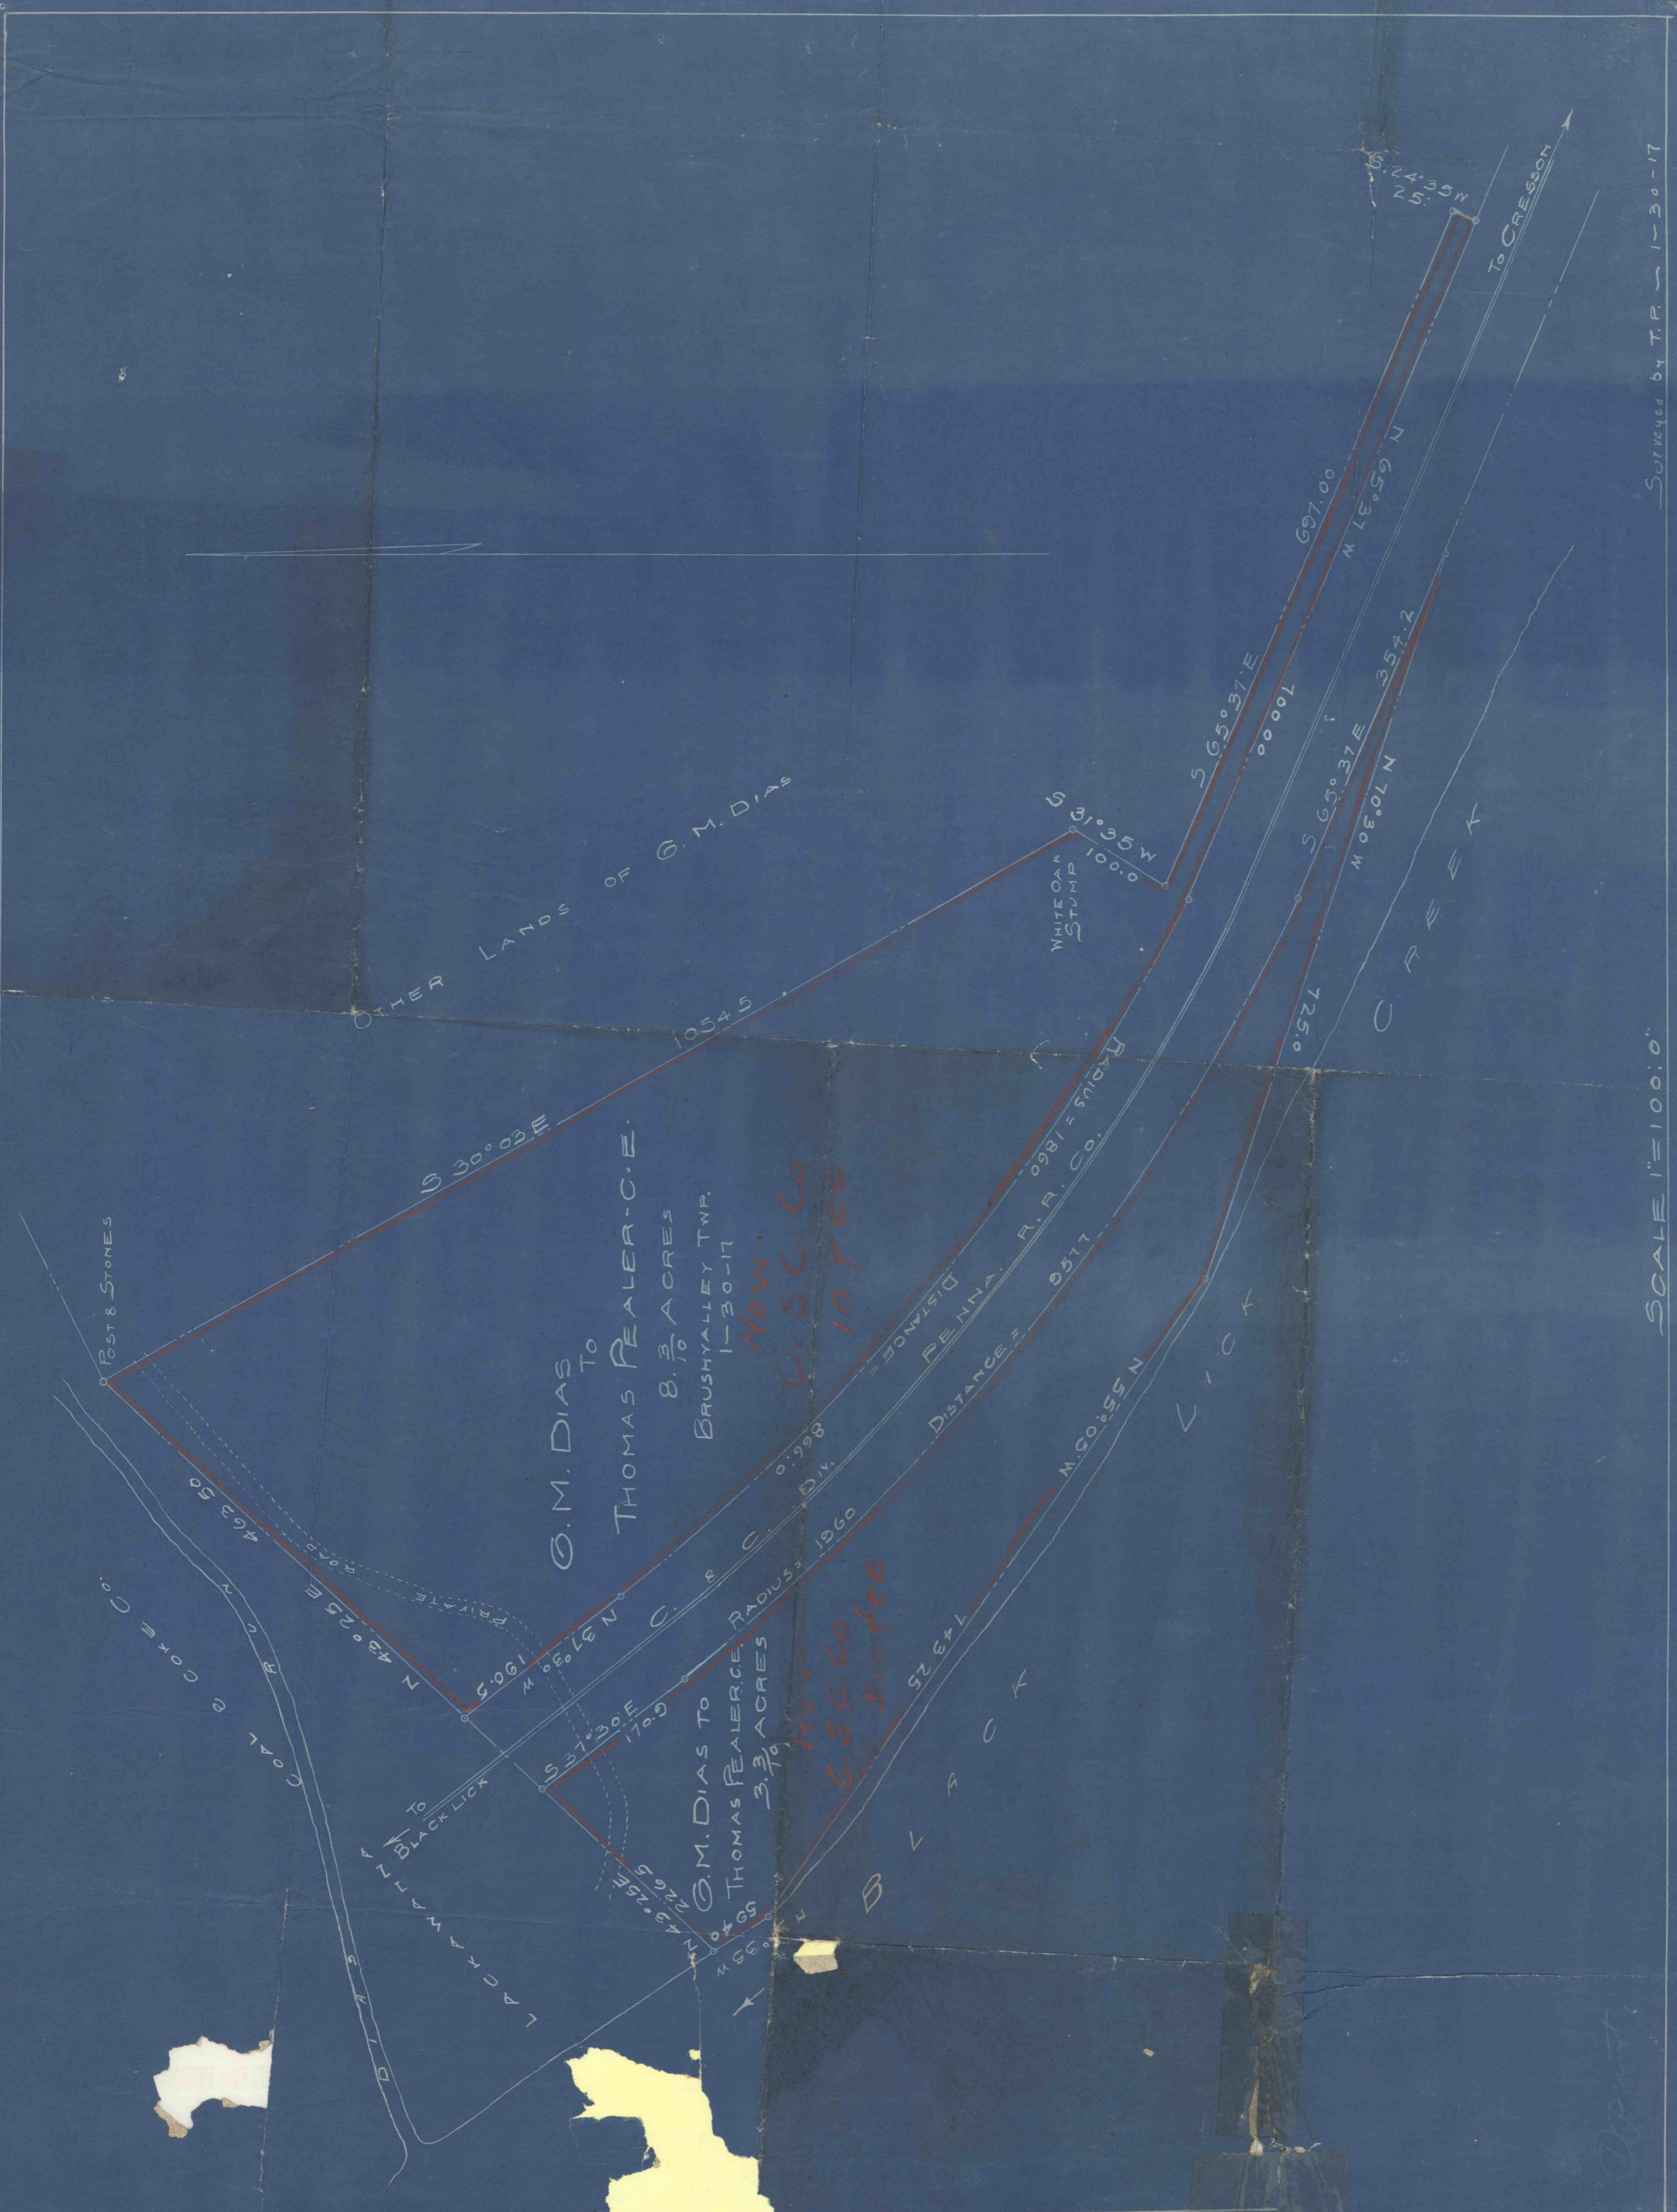

Surveyed by T. P. - 1-30-17

SCALE 1" = 100' 0"

W. P. W.