

E 1751,000

E 1748,000

N 453,000

N 452,000

N 451,000

N 450,000


N 3

N 2

N 1

MATCH TO SHEET 3G

MATCH TO SHEET 4H

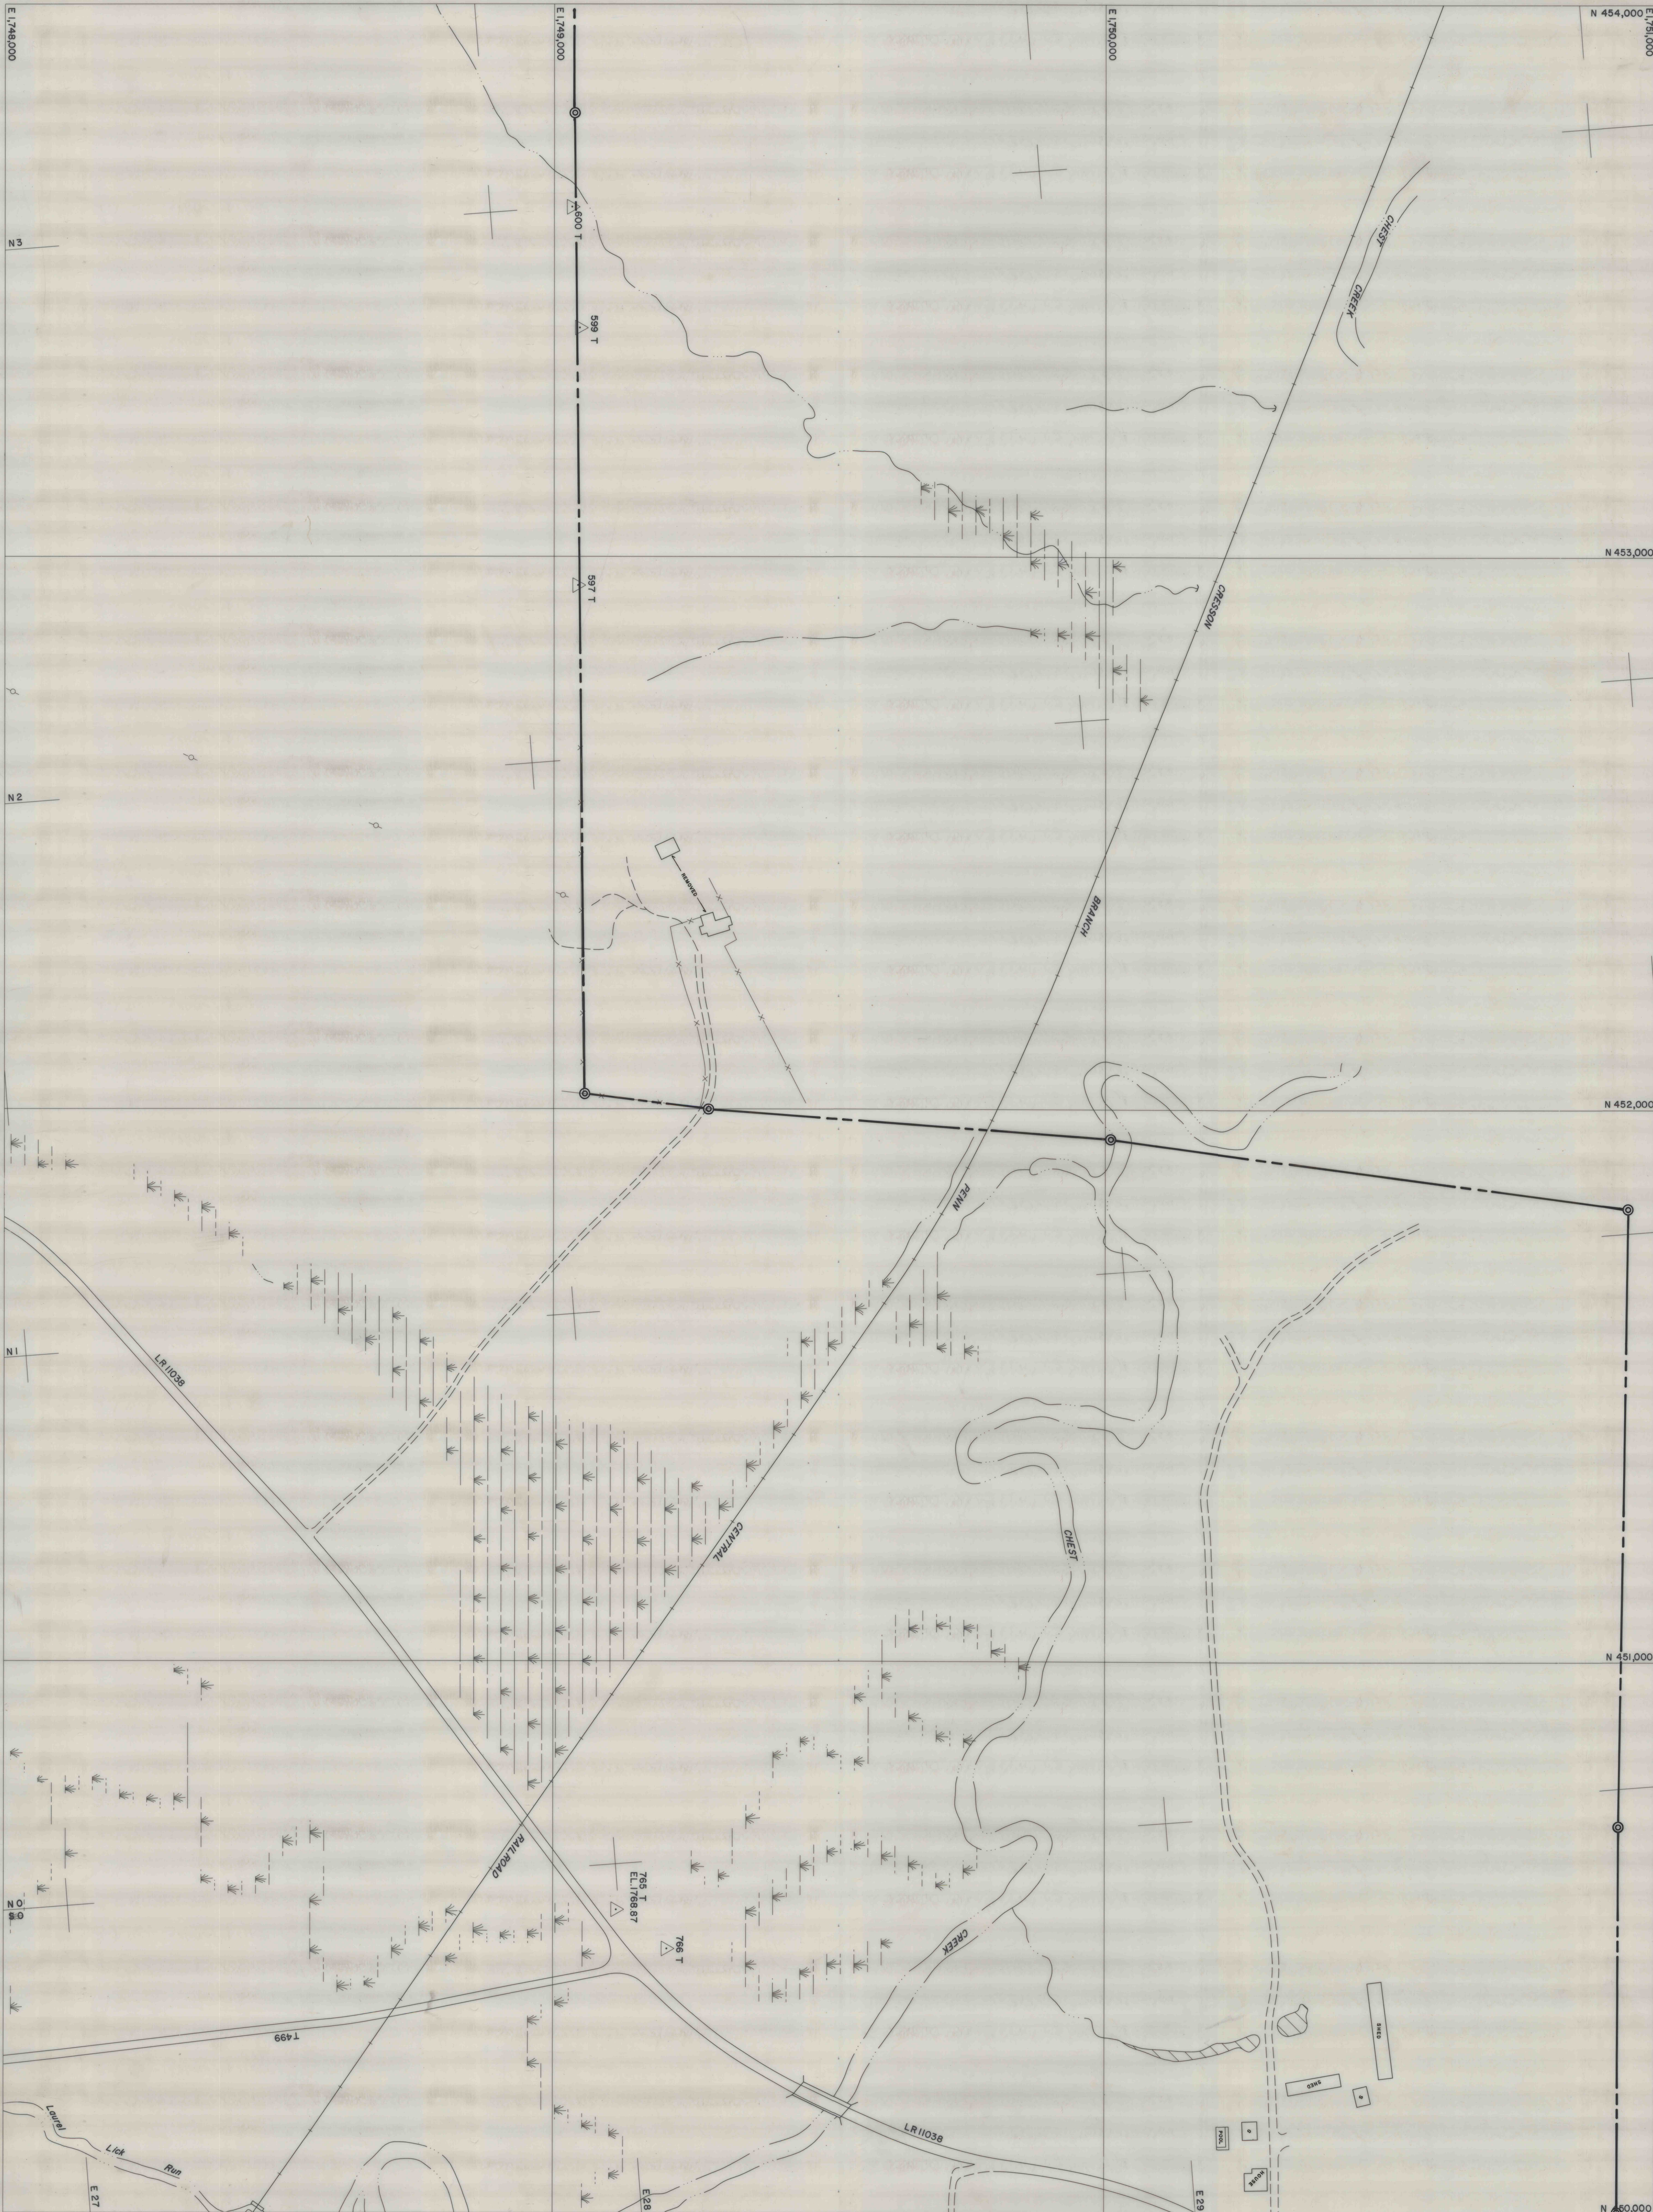

FINAL MAPPING DATE: 01-29-86

4420

BARNES & TUCKER COMPANY
 LANCASTER NO. 20 MINE
 EAST CARROLL TOWNSHIP, CAMBERIA COUNTY, PENNSYLVANIA
 SCALE: 1"=400'
 DATE: JULY, 1976

