BARNES & TUCKER COMPANY
LANCASHIRE NO. 20 MINE
EAST CARROLL TOWNSHIP, CAMBRIA COUNTY, PENNSYLVANIA
SCALE: 1"=100' DATE: JULY, 1976

3G

FINAL MAPPING DATE: 01-29-86
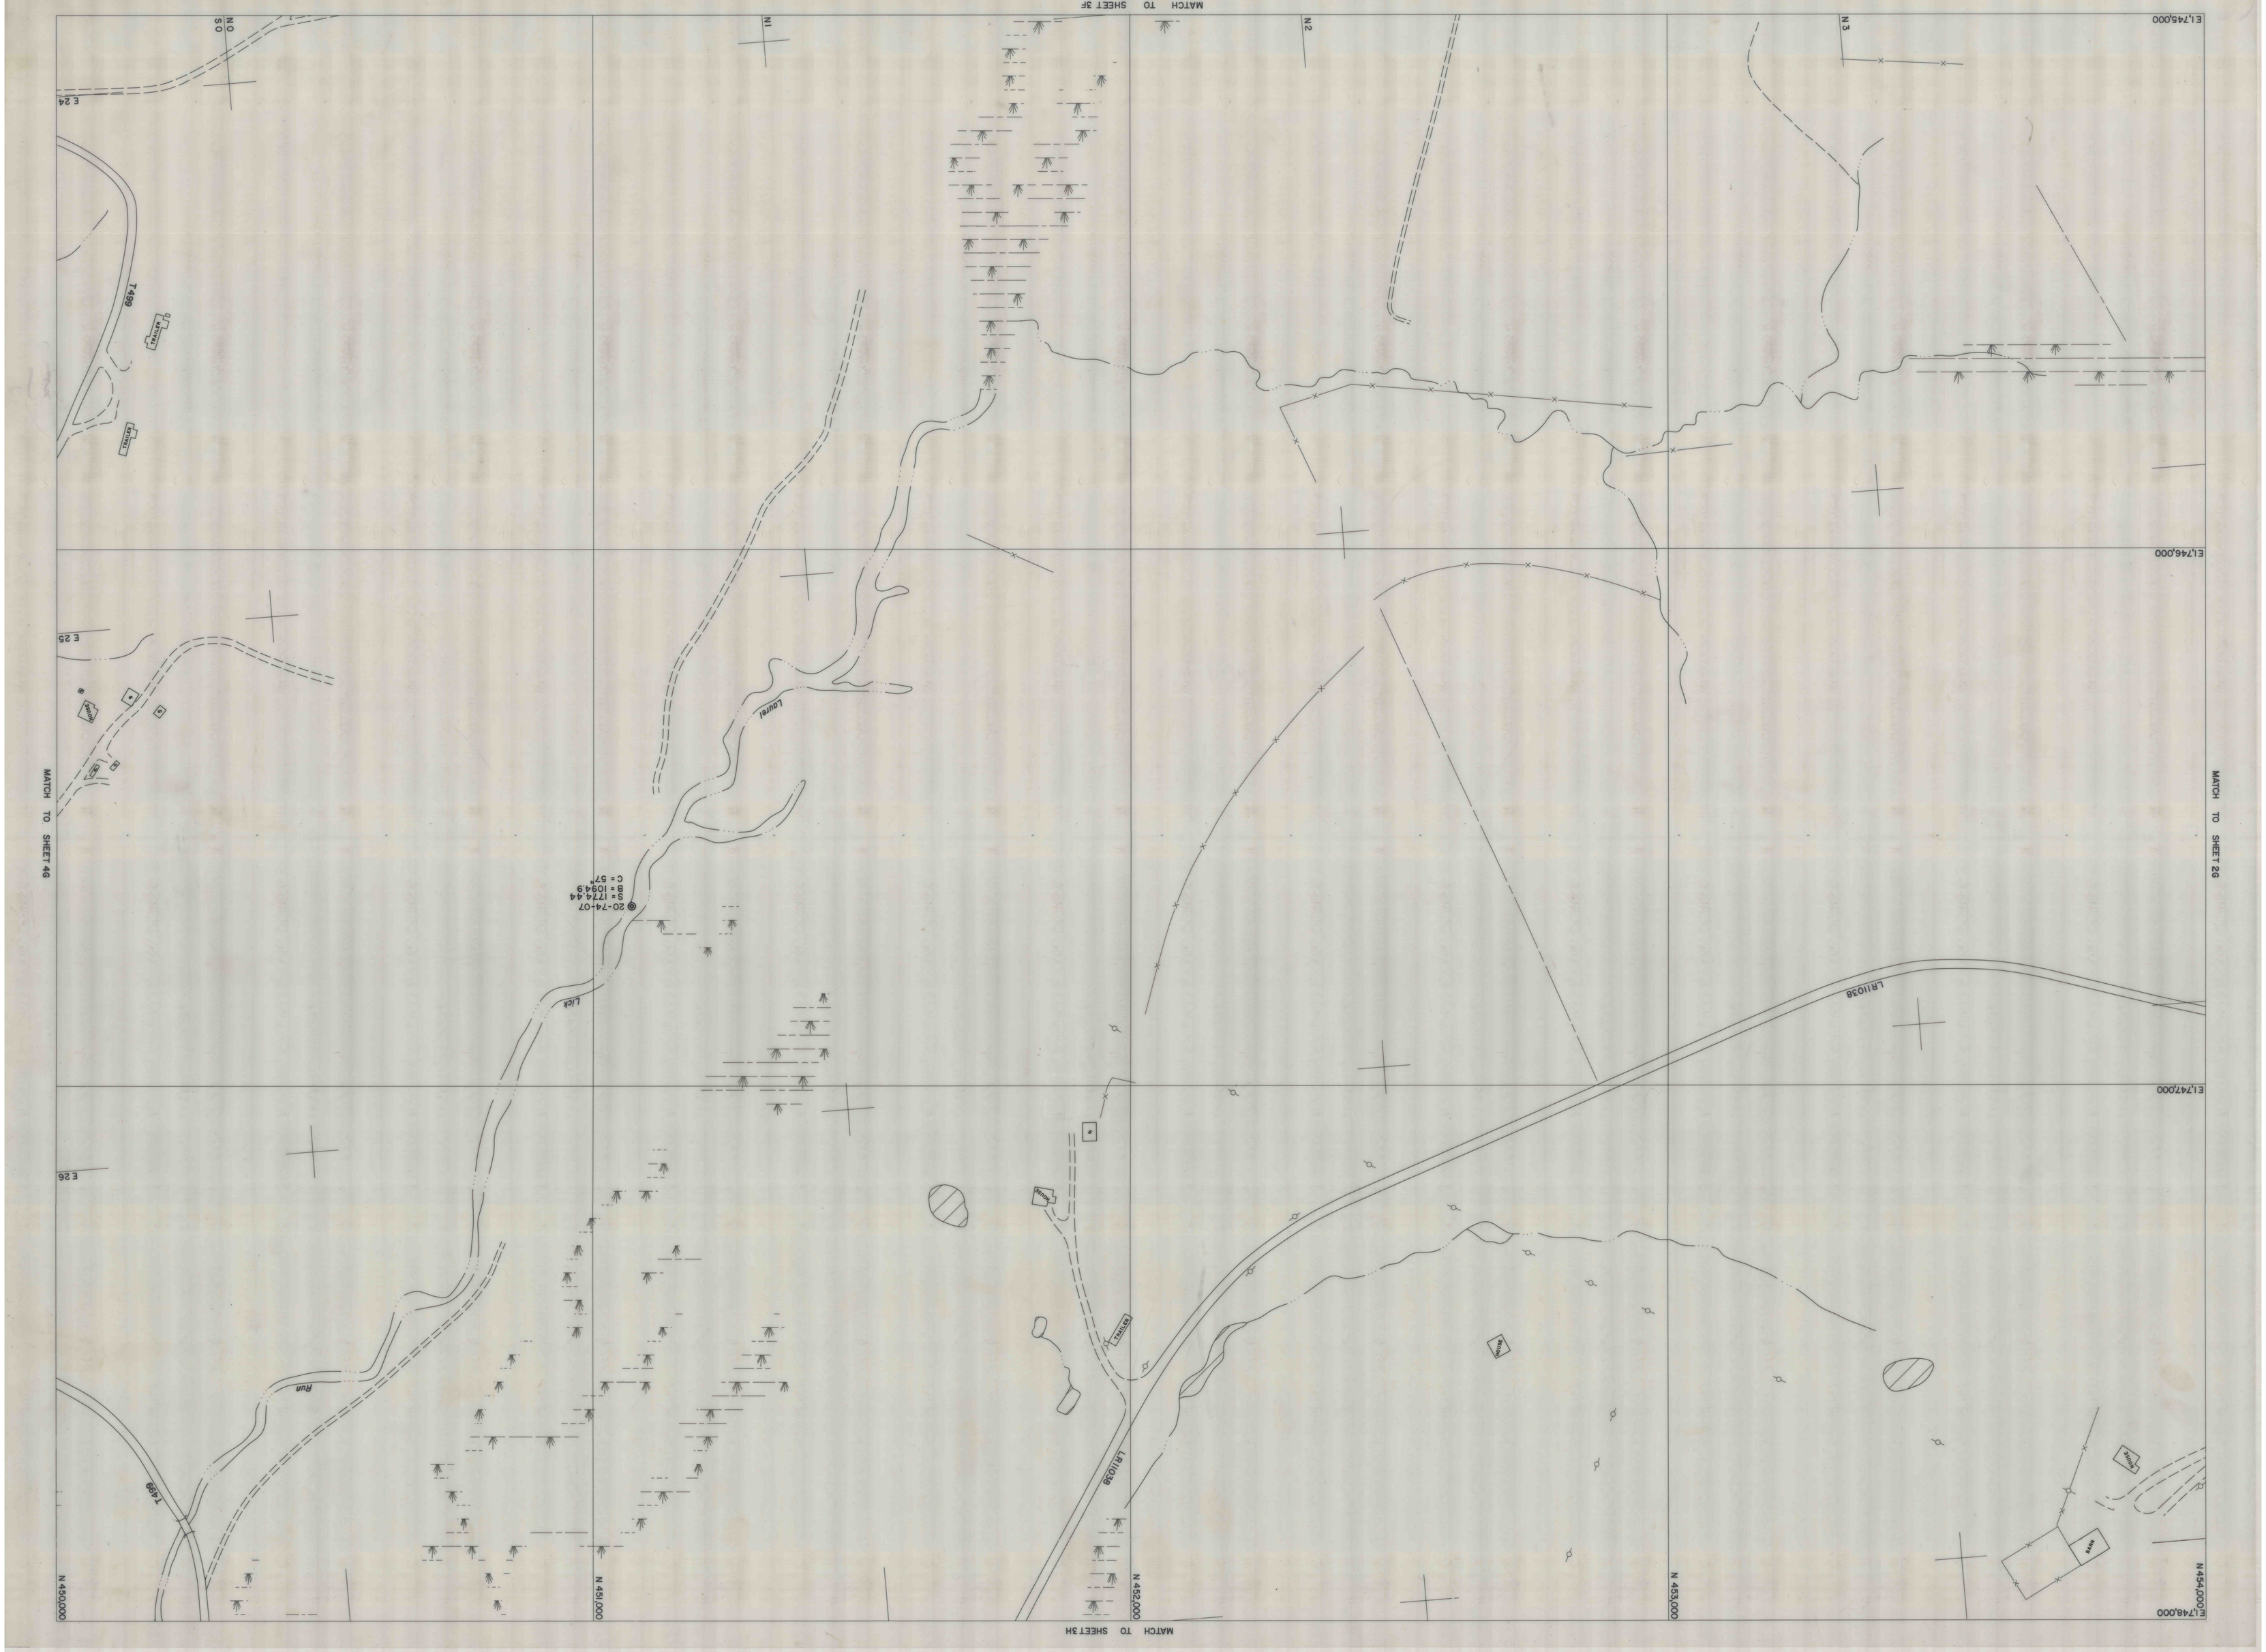
4420