

MATCH TO SHEET 3F

N 450,000  
E 1743,000

N 449,000

N 448,000

N 447,000

N 446,000


E 1744,000

E 1743,000

E 21

E 22

E 23

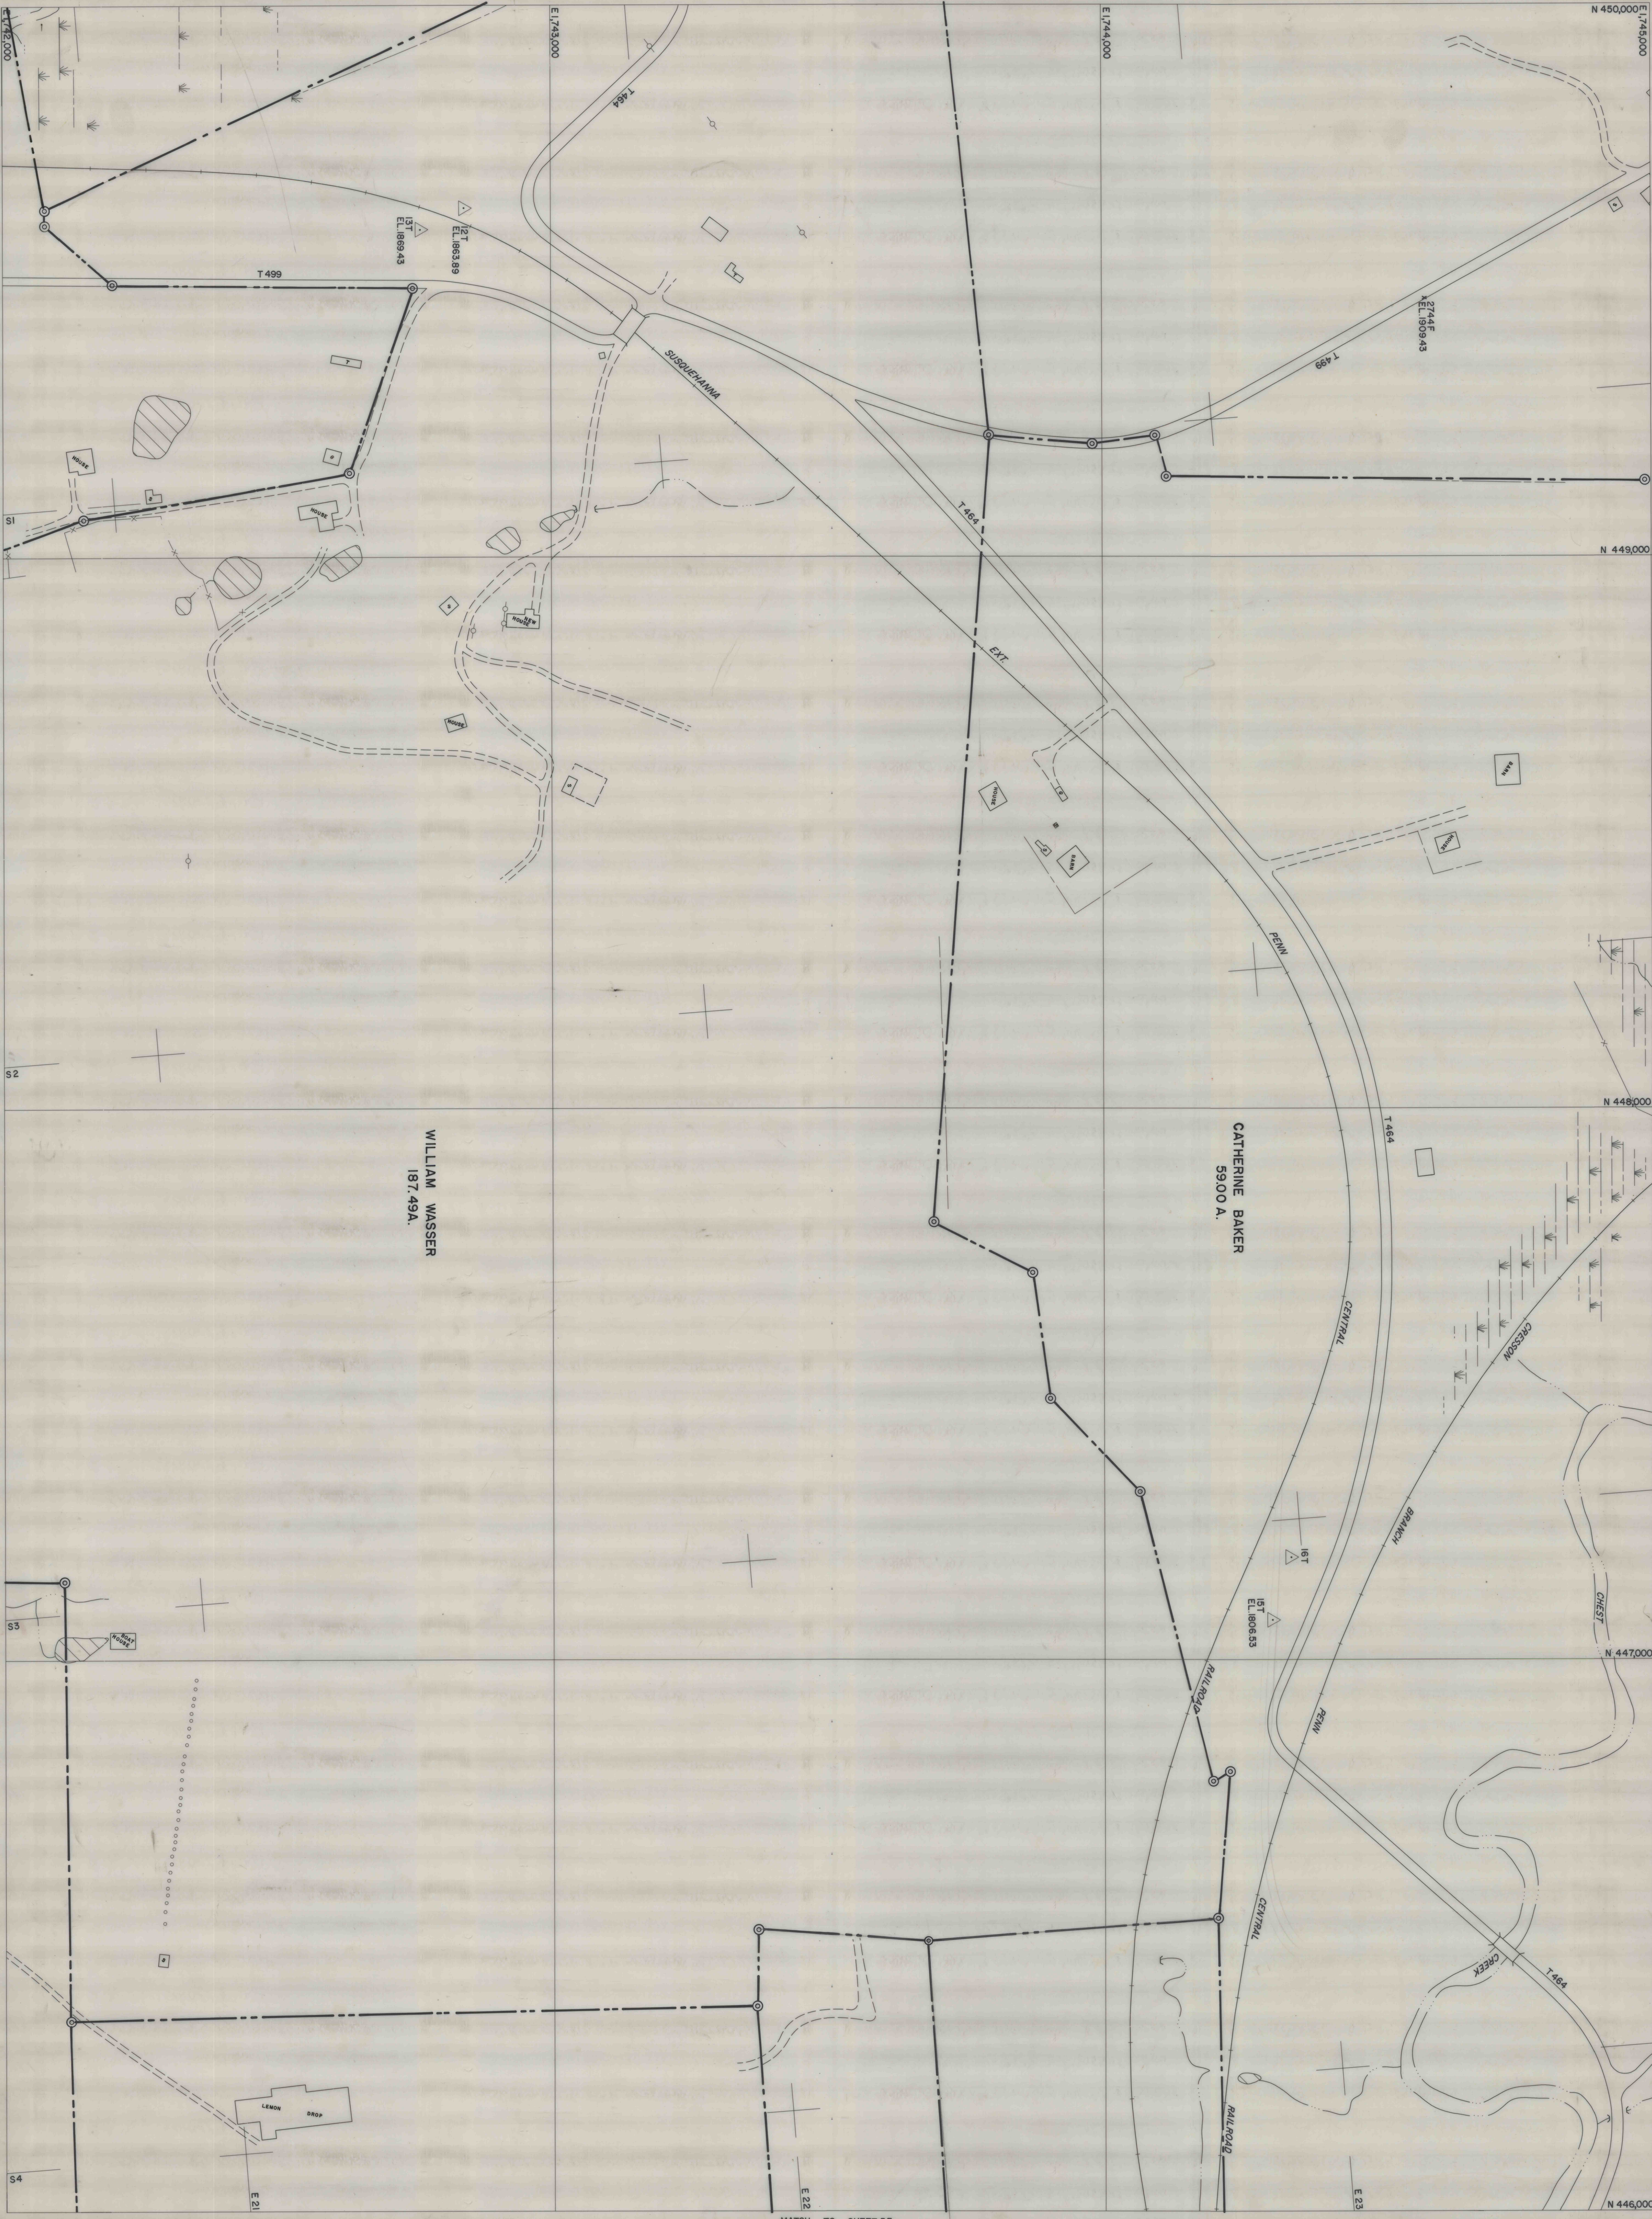

MATCH TO SHEET 5F

MATCH TO SHEET 4G

MATCH TO SHEET 4E



FINAL MAPPING DATE: 01-29-86  
4420

BARNES & TUCKER COMPANY  
LANCASTER NO. 20 MINE  
EAST CARROLL TOWNSHIP, CAMBERA COUNTY, PENNSYLVANIA  
SCALE 1"=100'  
DATE: JULY, 1976

4F