

N 442,000
E 1743,000

N 441,000

N 440,000

N 439,000

N 438,000


REGINA SHERRY
85.36A.

C. H. MC NULTY
49.89A.

JAMES KAYLOR
31.96 A.

W. J. BUCK
30.00A.

ANDREW ILLIG
38.00 A.

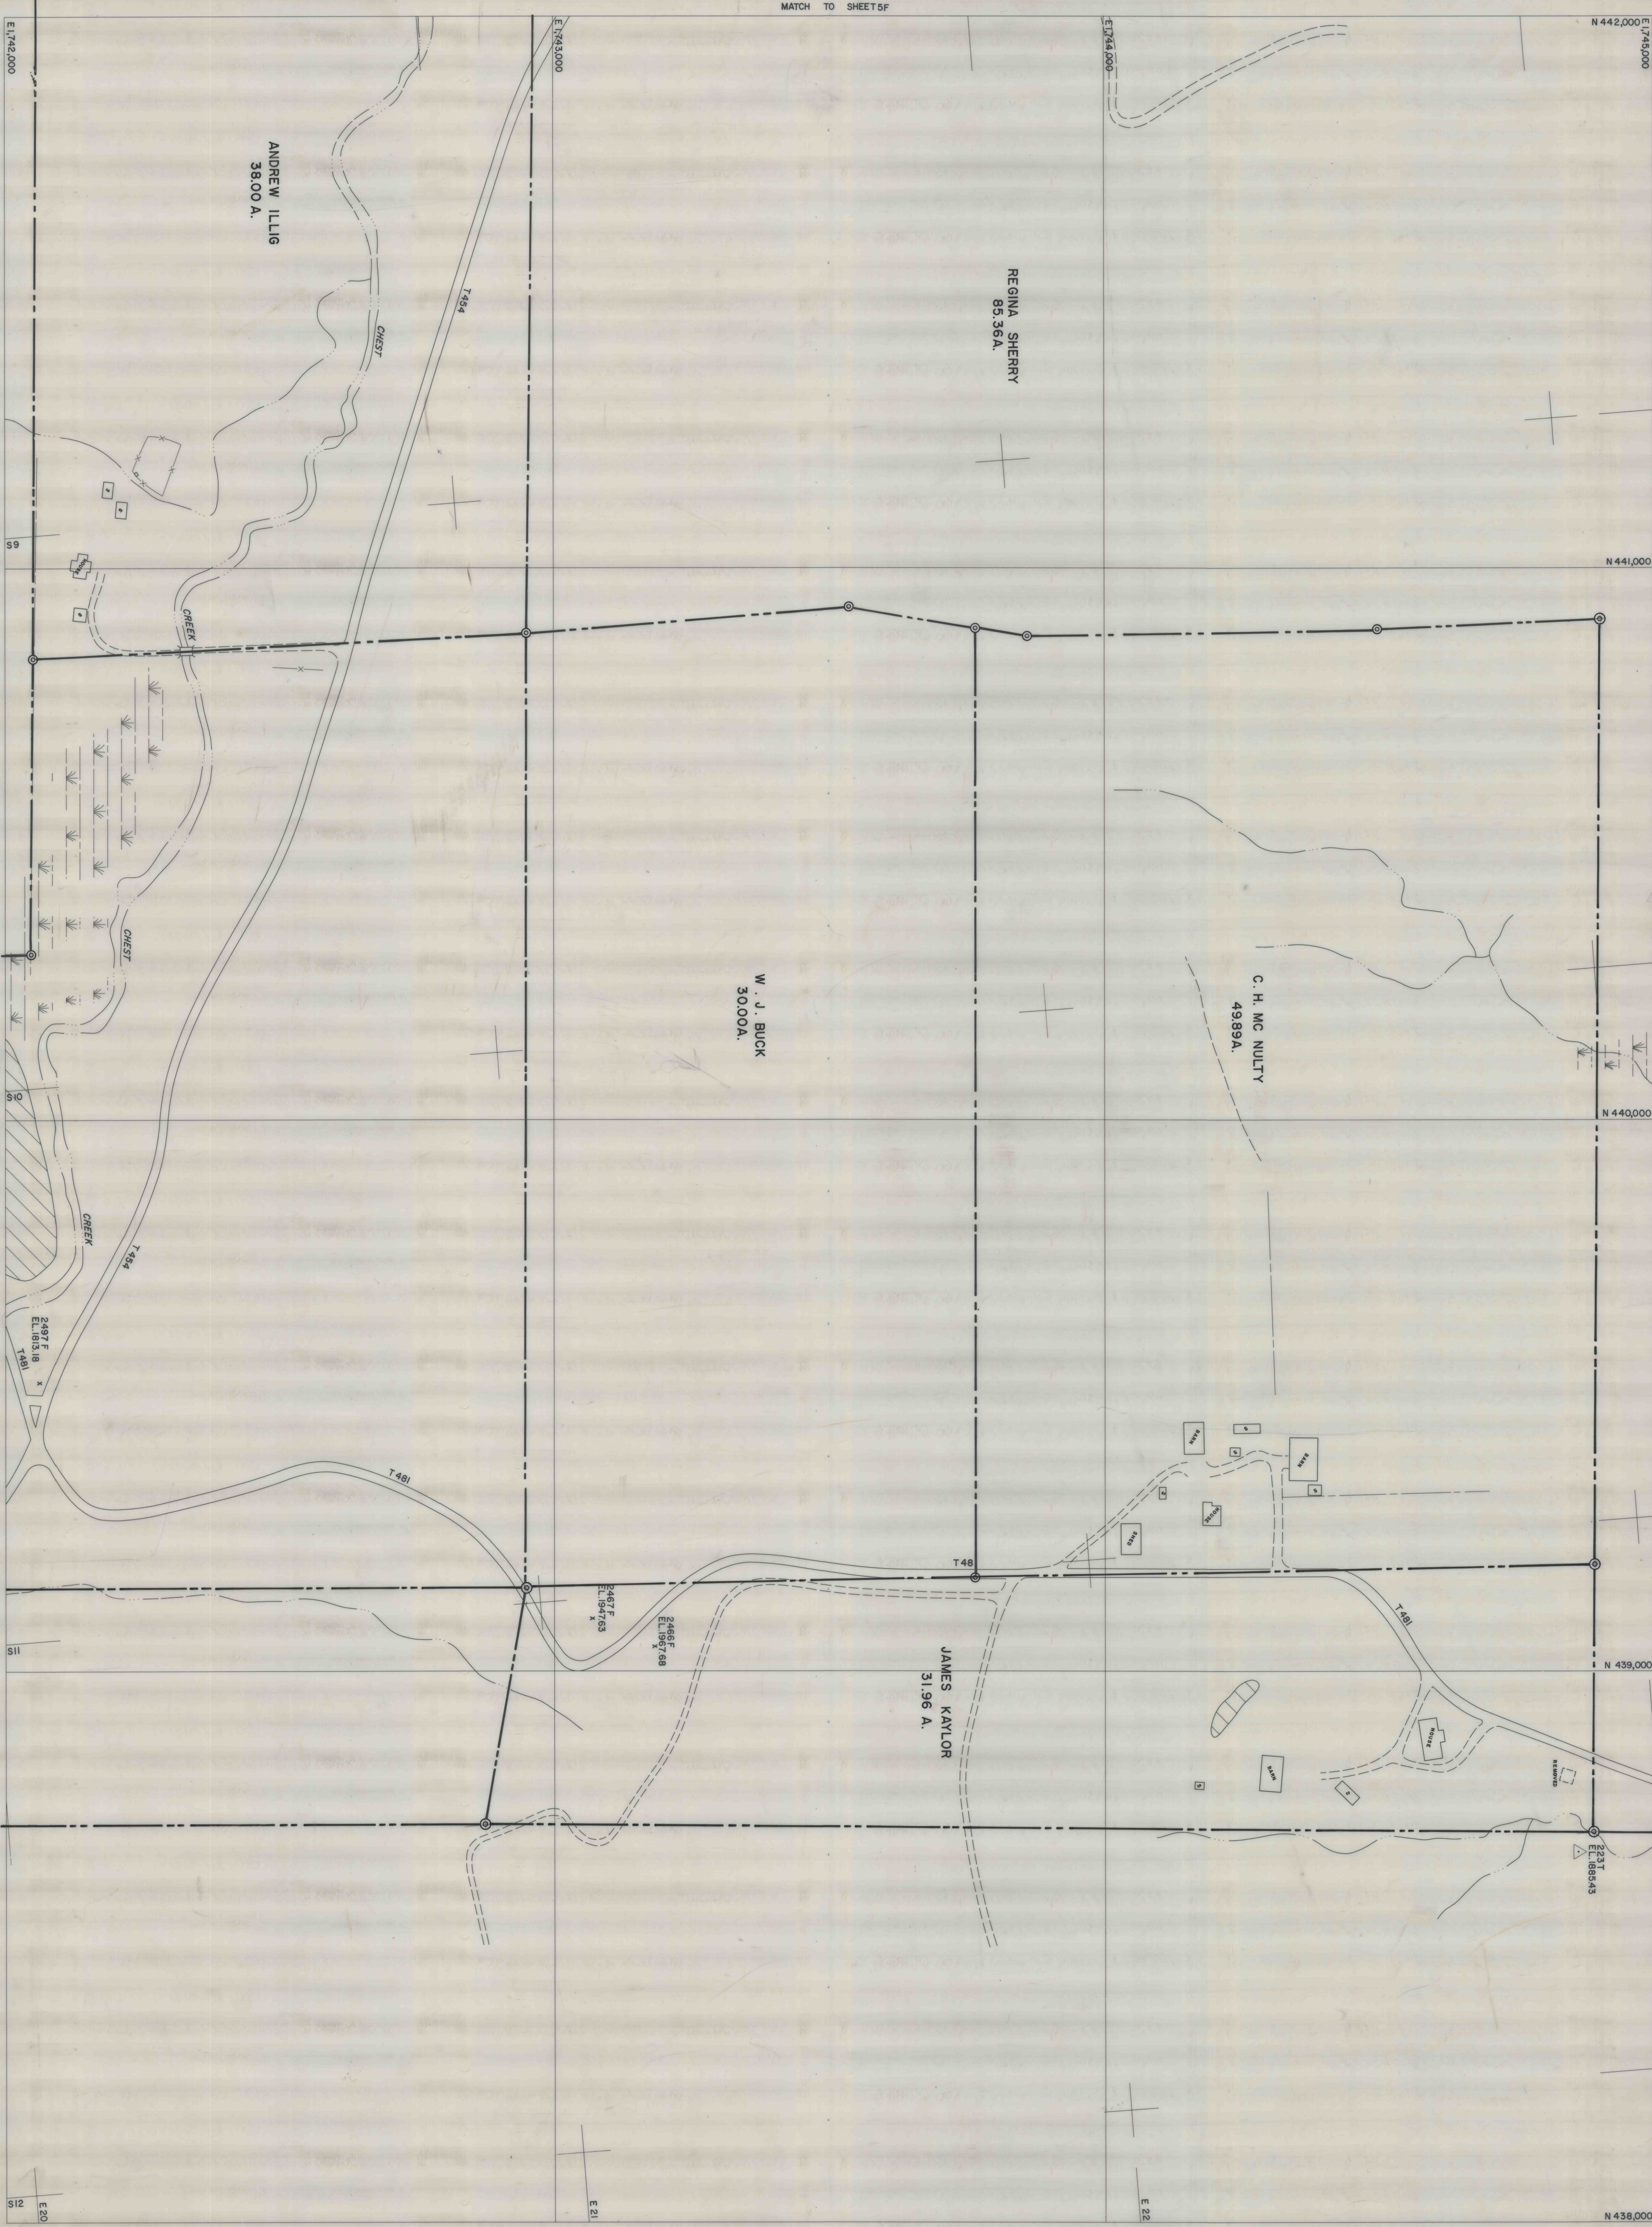

MATCH TO SHEET 6G

MATCH TO SHEET 6E

FINAL MAPPING DATE: 01-29-86
4420

BARNES & TUCKER COMPANY
LANCASHIRE NO. 20 MINE
EAST CARROLL TOWNSHIP, CAMBERIA COUNTY, PENNSYLVANIA
SCALE: 1"=400'
DATE: JULY, 1976