


FORD COLLIERIES CO.

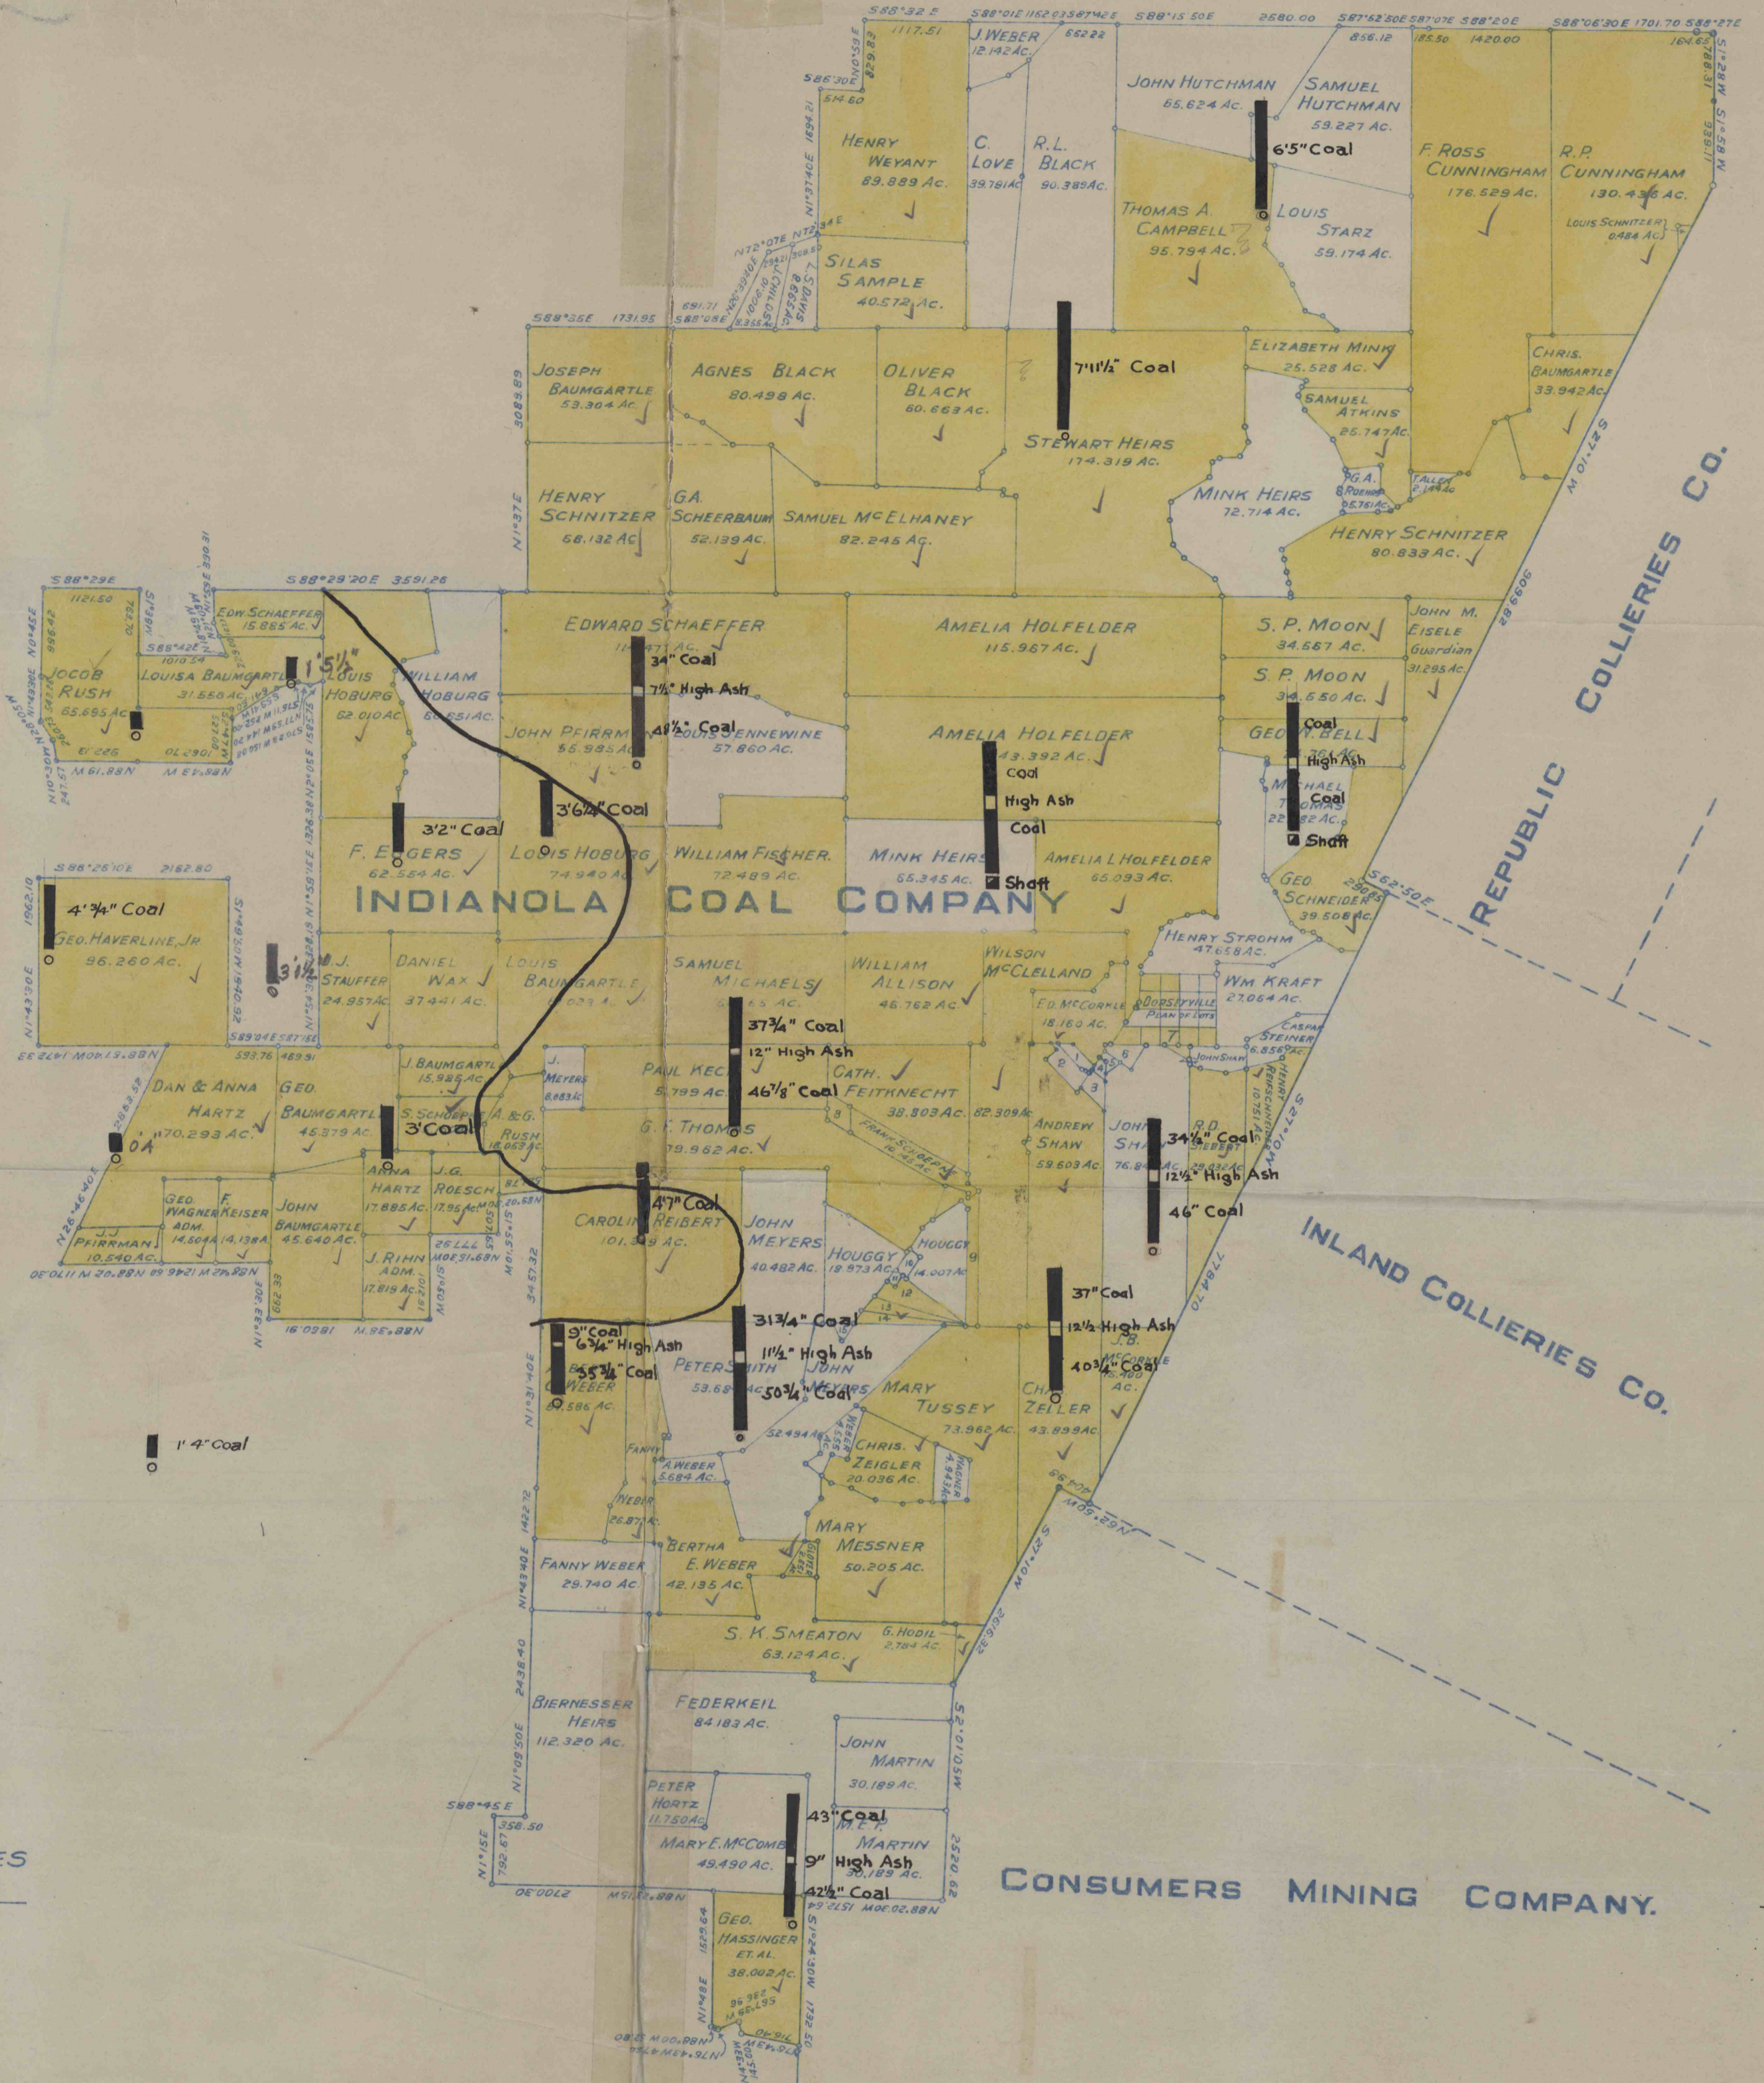

SMALL PARCELS

- 1 G Mc Intyre 1.242 Ac.
- 2 August Putz 2.901 "
- 3 Louis Grim 1.743 "
- 4 Dr McGary 0.520 "
- 5 W.W. Shaw 0.730 "
- 6 Cemetery Lot 1.963 "
- 7 Dorseyville (Popl.) 19.786 "
- 8 Michael Schoepne 1.909 "
- 9 Michael Schoepne 6.180 "
- 10 Church Lot 1.073 "
- 11 School Lot 0.368 "
- 12 Cath. Feitnecht 4.148 "
- 13 Michael Schoepne 2.582 "
- 14 Jas. Schoepne 2.393 "
- 15 Church Lot 0.558 "

SURVEY AREA = 5262.7475 ACRES
 J. B. FOSTER = 246717 "
 TOTAL AREA = 5287.4192 "

SURVEY OF
INDIANOLA COAL CO.
 PROPERTY

SCALE 1" = 1600' JANUARY 1919
 J.M. RAYBURN

#1367
 8-6-99
 C.C.