


SALTICK TWP.

DONEGAL TWP.

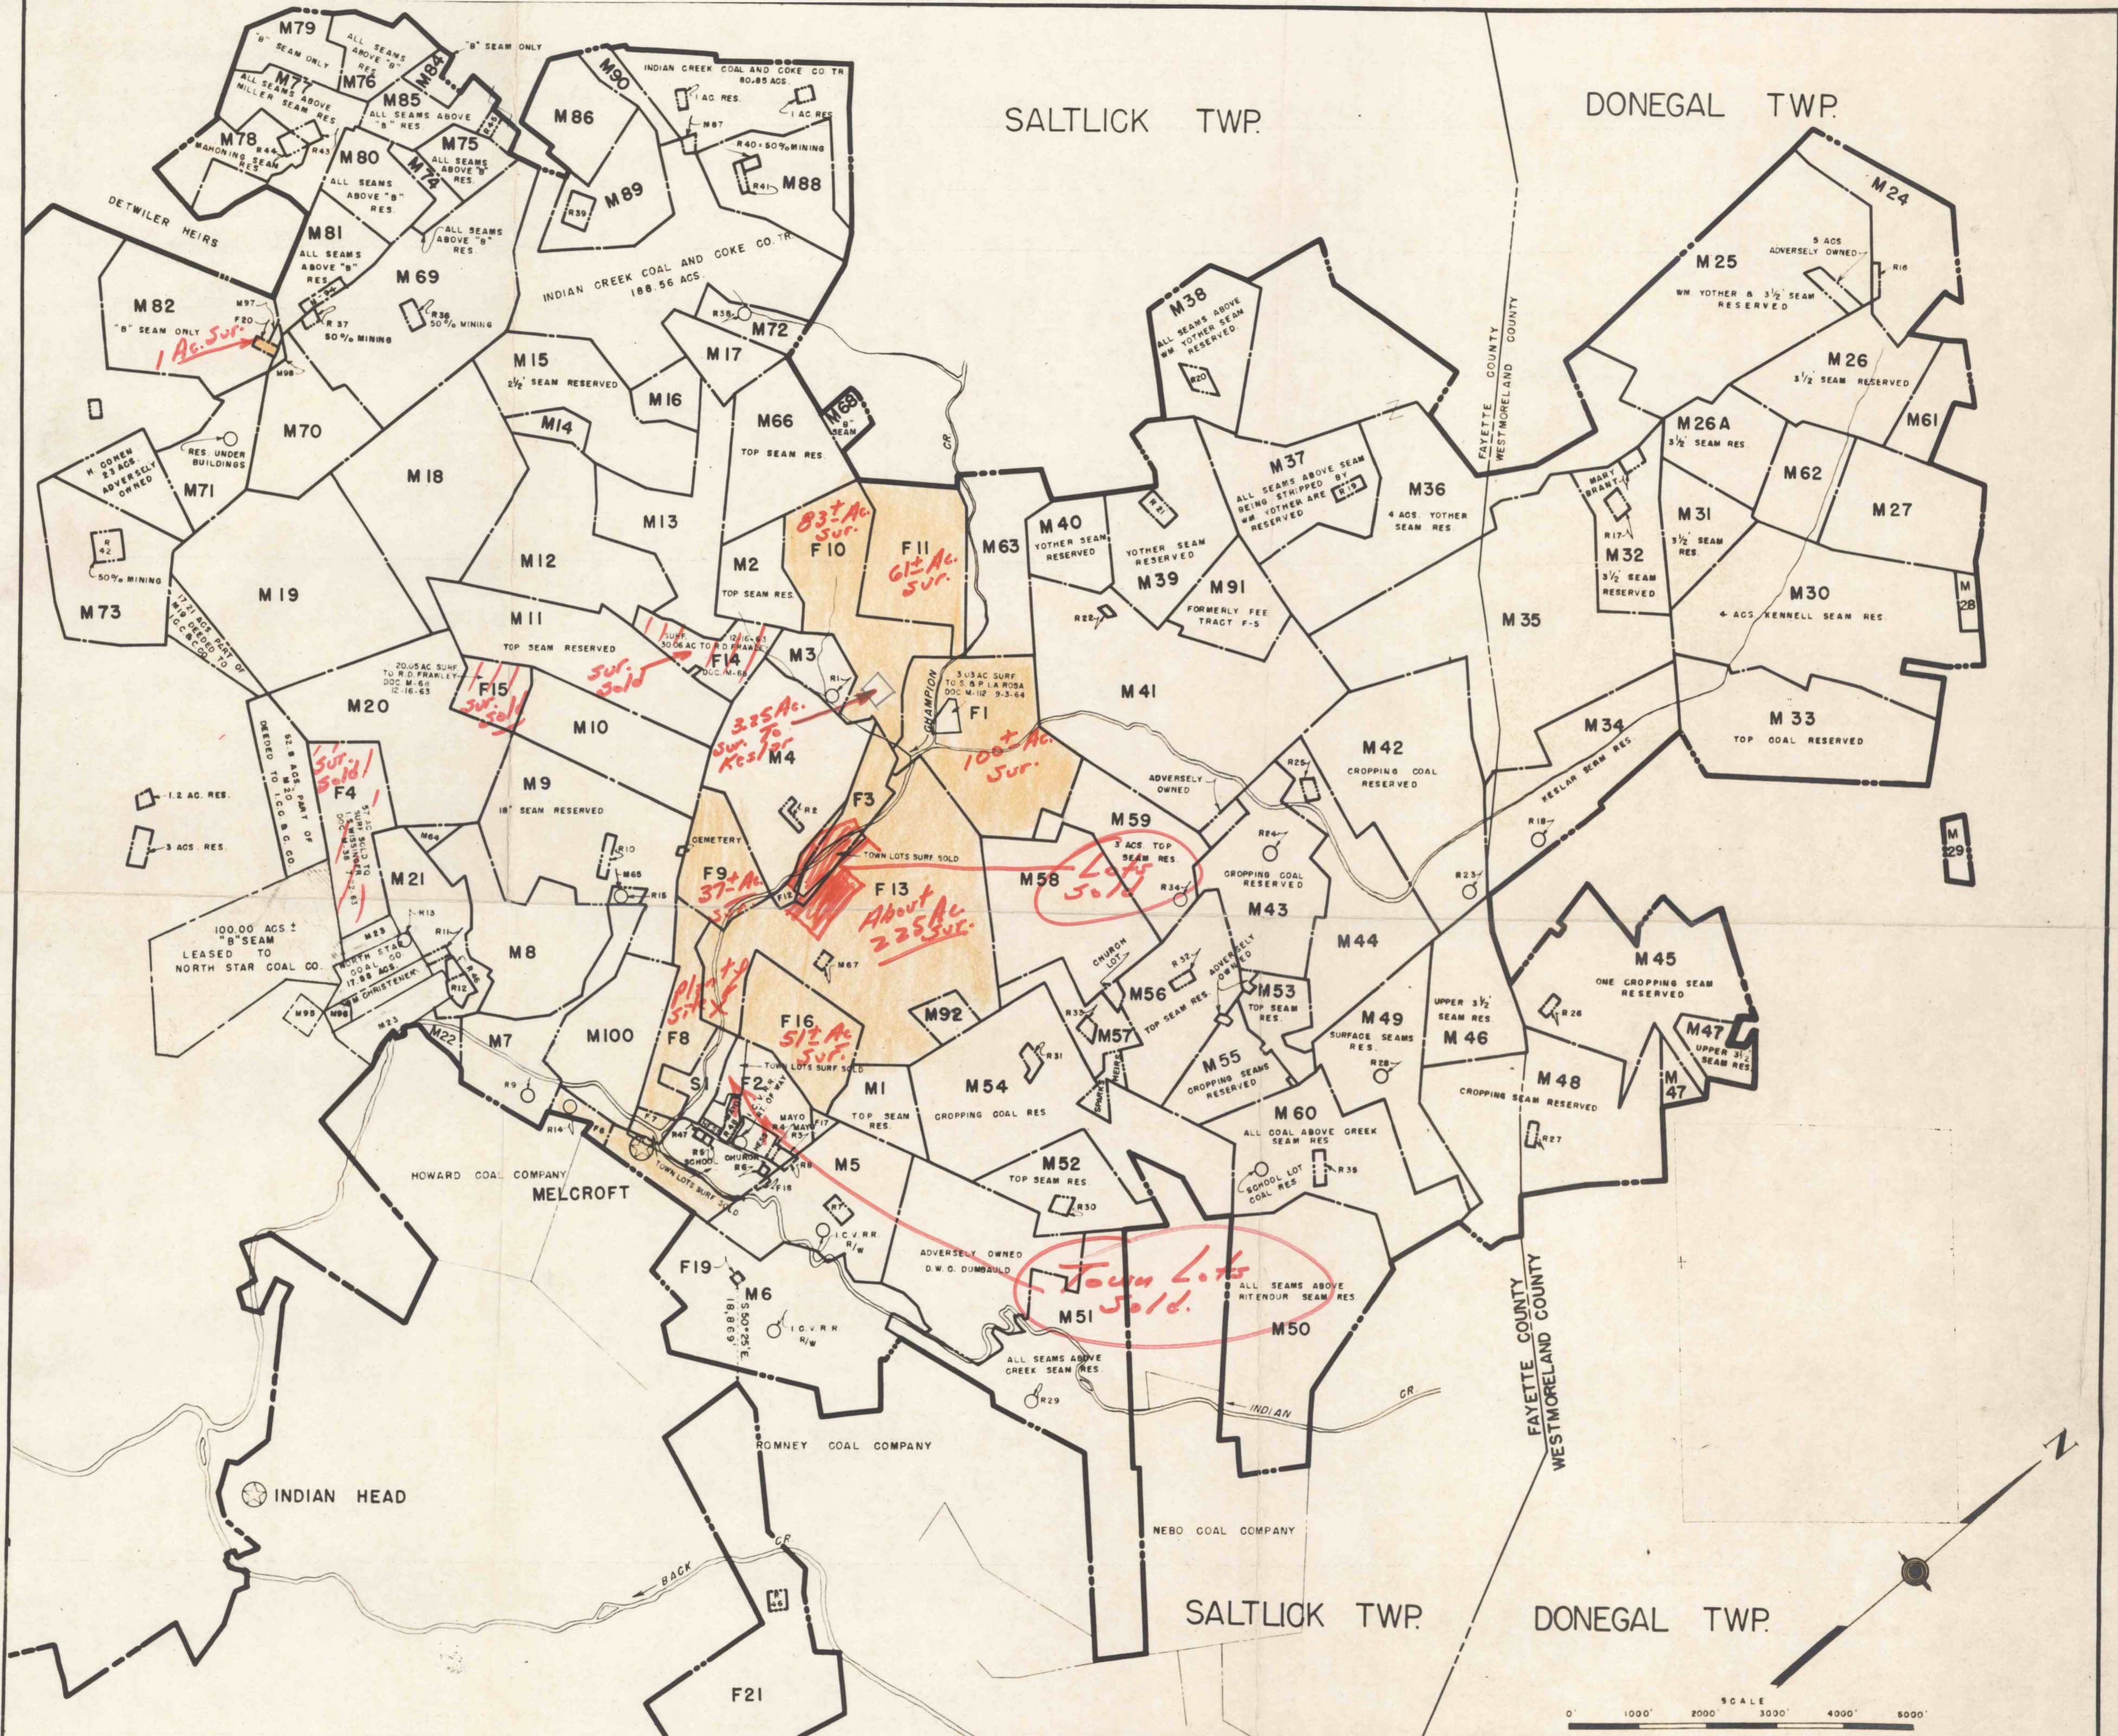

SALTICK TWP.

DONEGAL TWP.

REVISED	F.W.R.	10/65	NAME	DATE	EASTERN GAS AND FUEL ASSOCIATES	MELCROFT MINE	SCALE 1"=1000'	POSTED TO-10-2-57
			DRAWN BY V.R.G.	6-5-50	COAL DIVISION	PROPERTY MAP		
			CHECKED BY E.E.B.		PITTSBURGH, PA.			
REV.	DESCRIPTION	CHECKED BY	DATE	APPROVED				

P-6-26