


INDEX TO MINES

INDEX NUMBER	DESCRIPTION	INDEX NUMBER	DESCRIPTION
1	Rich Hill No. 1, E Seam	P13	Penna. Coal & Coke Company's No. 13, B Seam
V1	Carrolltown Coal Company's Victor No. 1, D Seam	14	Barnes Coal Company's No. 14, B Seam
D1	Duncan-Spangler Coal Company's Delta No. 1, D Seam	15	" " " " " " No. 15, B "
2	Rich Hill Coal Company's No. 2, D Seam	16	Old Puritan Mine, B Seam, (Abandoned)
D2	Duncan-Spangler Coal Company's Delta No. 2, D Seam	17	Penna. Coal & Coke Company's No. 17, D Seam
3	Madera-Hill Coal Mining Company's No. 3, E Seam	17E	" " " " " " No. 17E, E Seam
3 1/2	" " " " " " No. 3 1/2, D Seam	18	Cherrytree Coal Company's Victor No. 17, D Seam
4	" " " " " " No. 4, B Seam	18	Binder Brothers Coal Company, D Seam
R4	Rich Hill Coal Company's No. 4, D Seam	19	Butlerworth Coal Company's D Seam
V4	Carrolltown Coal Co's Victor No. 4, D Seam (W. Deringer)	20	Frank Lantz's Wagon Mine, D Seam
5	Rich Hill Coal Company's No. 5, E Seam	21	E.M. Weakland's Mines C & D Seams
6	Oak Ridge Coal & Coke Company's No. 6, C Seam	22	Beunier Coal Company's C, D & E Seams
7	Huelther Coal Company, C Prime Seam	23	Penna. Coal & Coke Co's C & D Seams (Nos. 21 & 22 Mines)
8	Lenox Coal Company's E Seam	24	Hastings Fuel Company's C Prime Seam
9	Carrolltown Coal Company's Victor's 9, B Seam	25	Moss Creek Coal Company's B Seam
10	Sterling Coal Company's D Seam (Abandoned)	26	Hastings Fuel Company's B Seam
11	Penna. Coal & Coke Company's No. 11, D Seam	27	Red Top Coal Company (Charles Hetrick) B Seam
11E	" " " " " " No. 11E, E Seam	28	Penna. Coal & Coke Company's No. 28, D Seam
12	Porter Coal Company's Lancashire No. 12, D Seam	31	" " " " " " No. 31, D Seam
P12	Penna. Coal & Coke Company's No. 12, D Seam	62	Reed Coal Mining Company, D Seam
V12	Old Victor, No. 12 - Now Penna. Coal & Coke Co., D Seam		
13	Duncan-Spangler Coal Company's No. 13, D Seam		

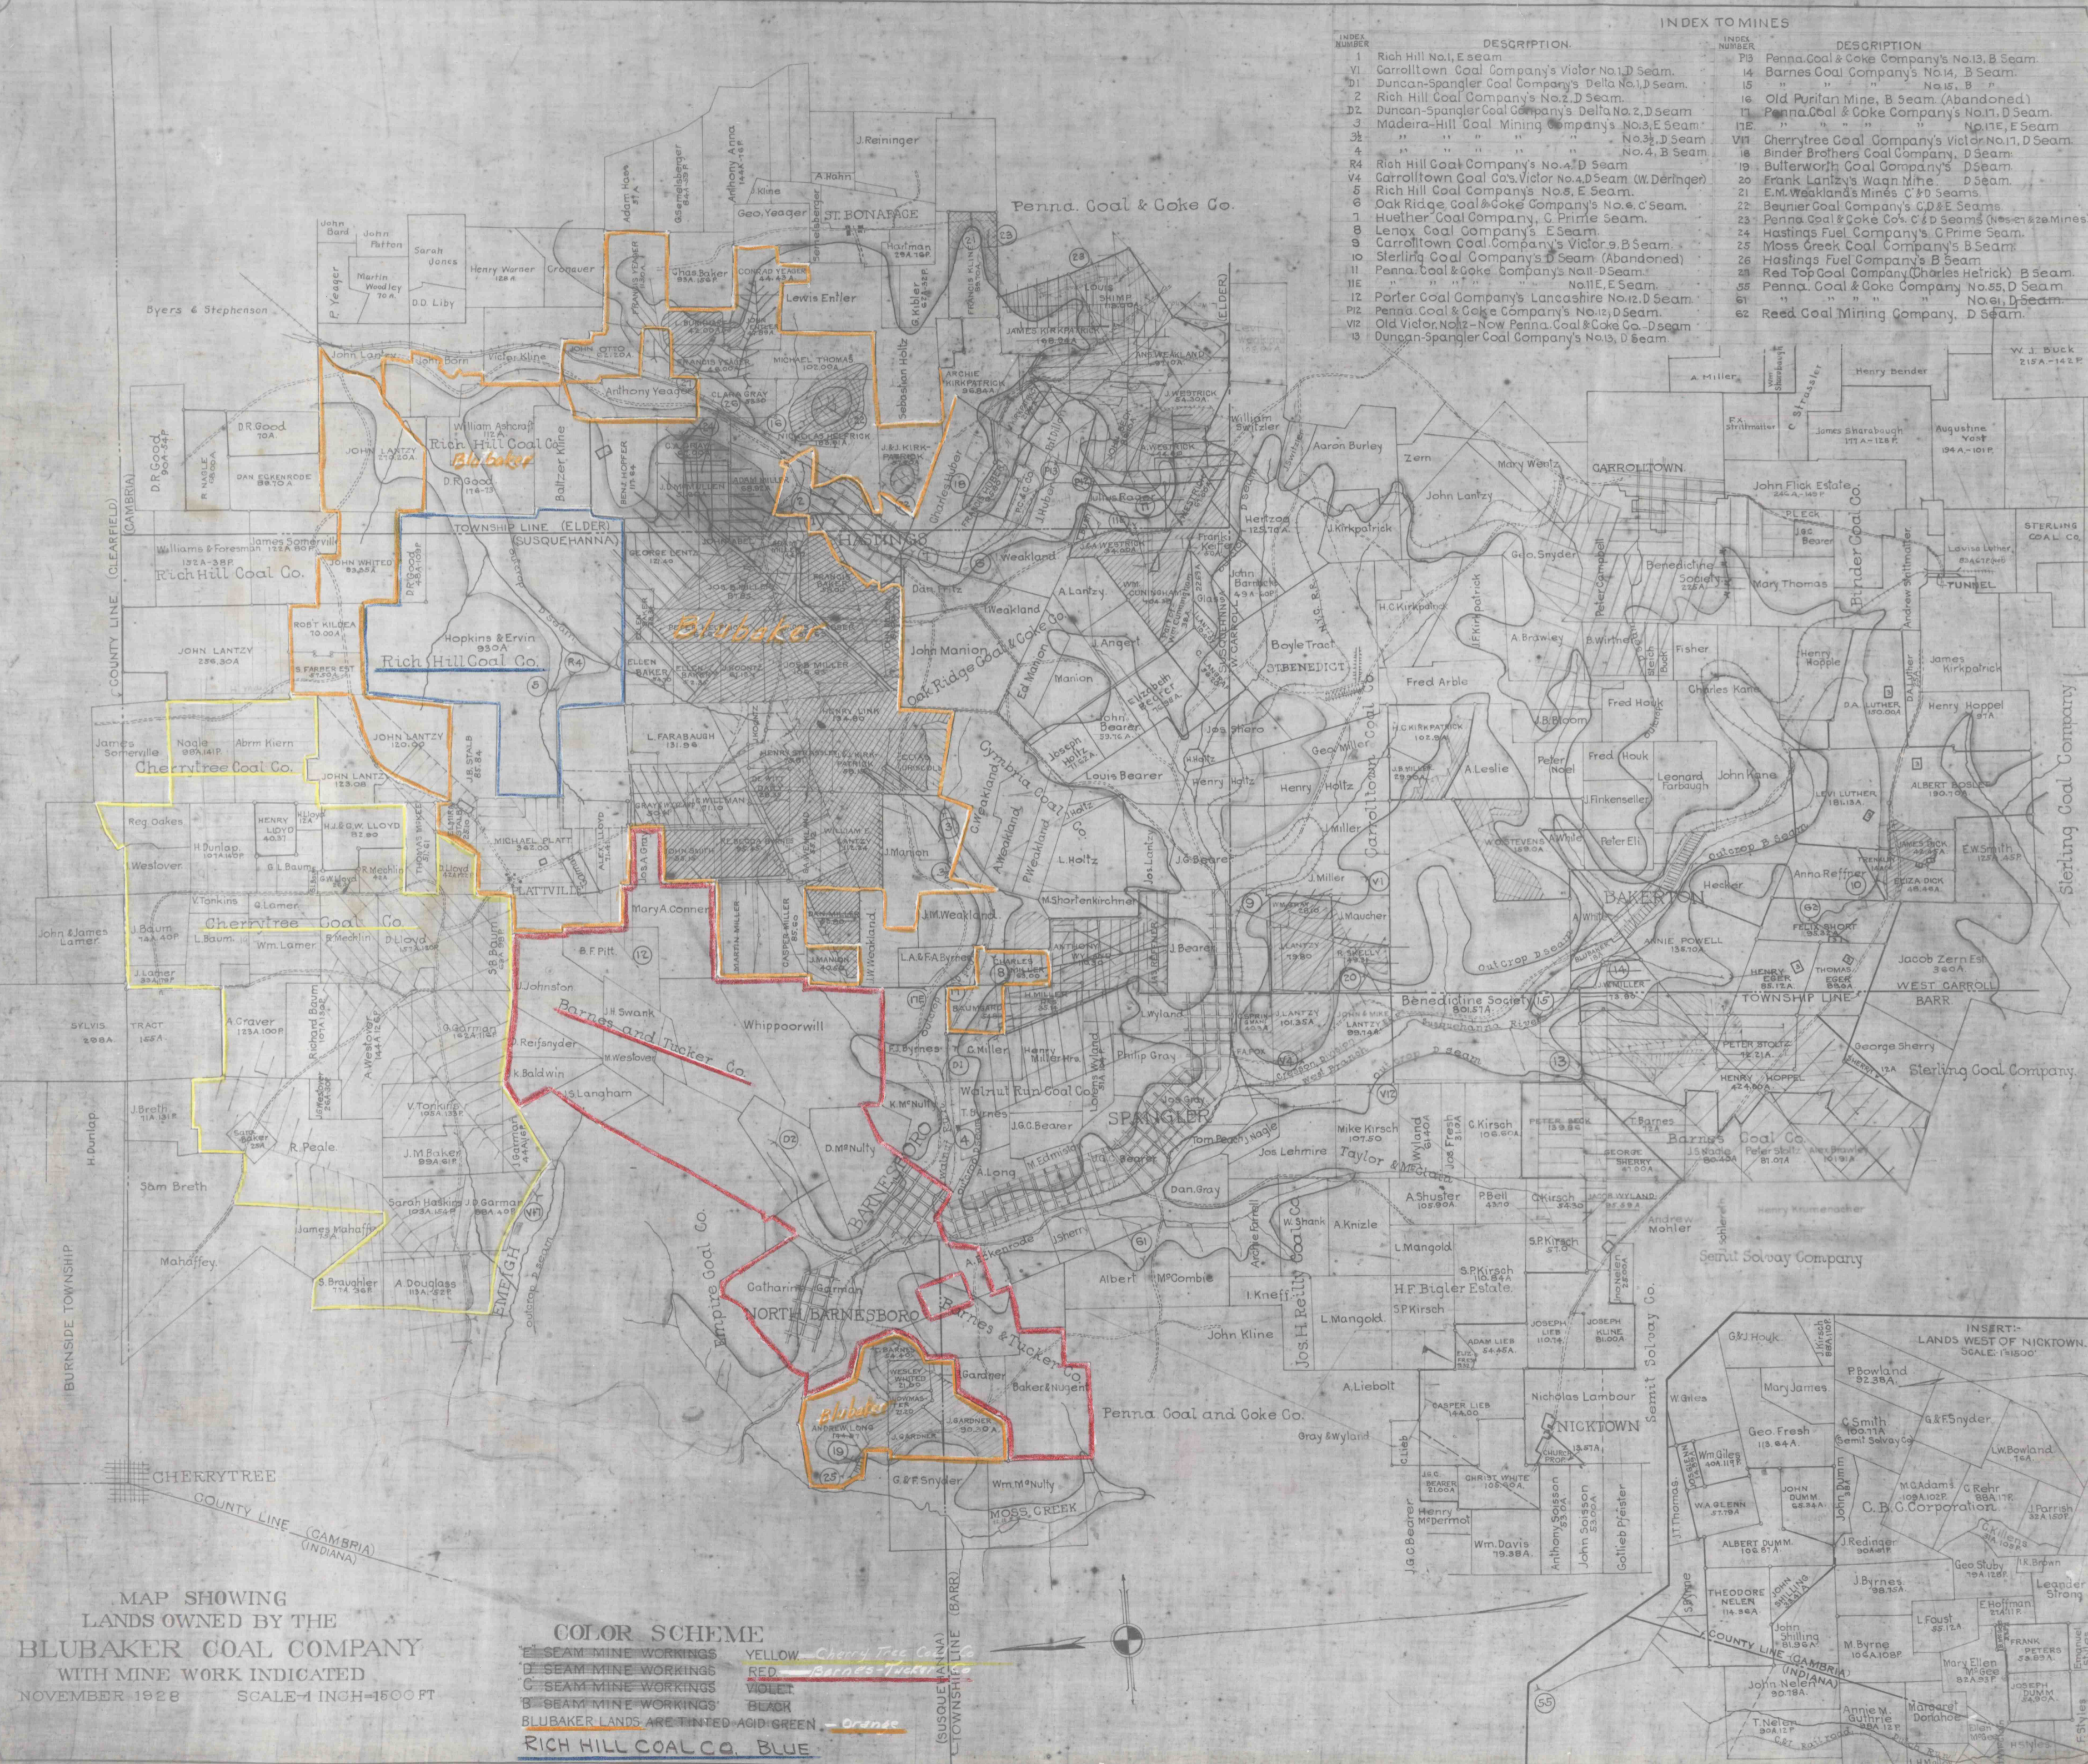

MAP SHOWING
LANDS OWNED BY THE
BLUBAKER COAL COMPANY
WITH MINE WORK INDICATED
NOVEMBER 1928 SCALE 1 INCH = 1500 FT

COLOR SCHEME

E SEAM MINE WORKINGS	YELLOW - Cherrytree Coal Co.
D SEAM MINE WORKINGS	RED - Barnes & Tucker Co.
C SEAM MINE WORKINGS	VIOLET
B SEAM MINE WORKINGS	BLACK
RICH HILL COAL CO. BLUE	BLUE