


Shank, Clarence & Paul
 Creek Bottom
 Indiana Co. District 25
 1956 Annual

328175

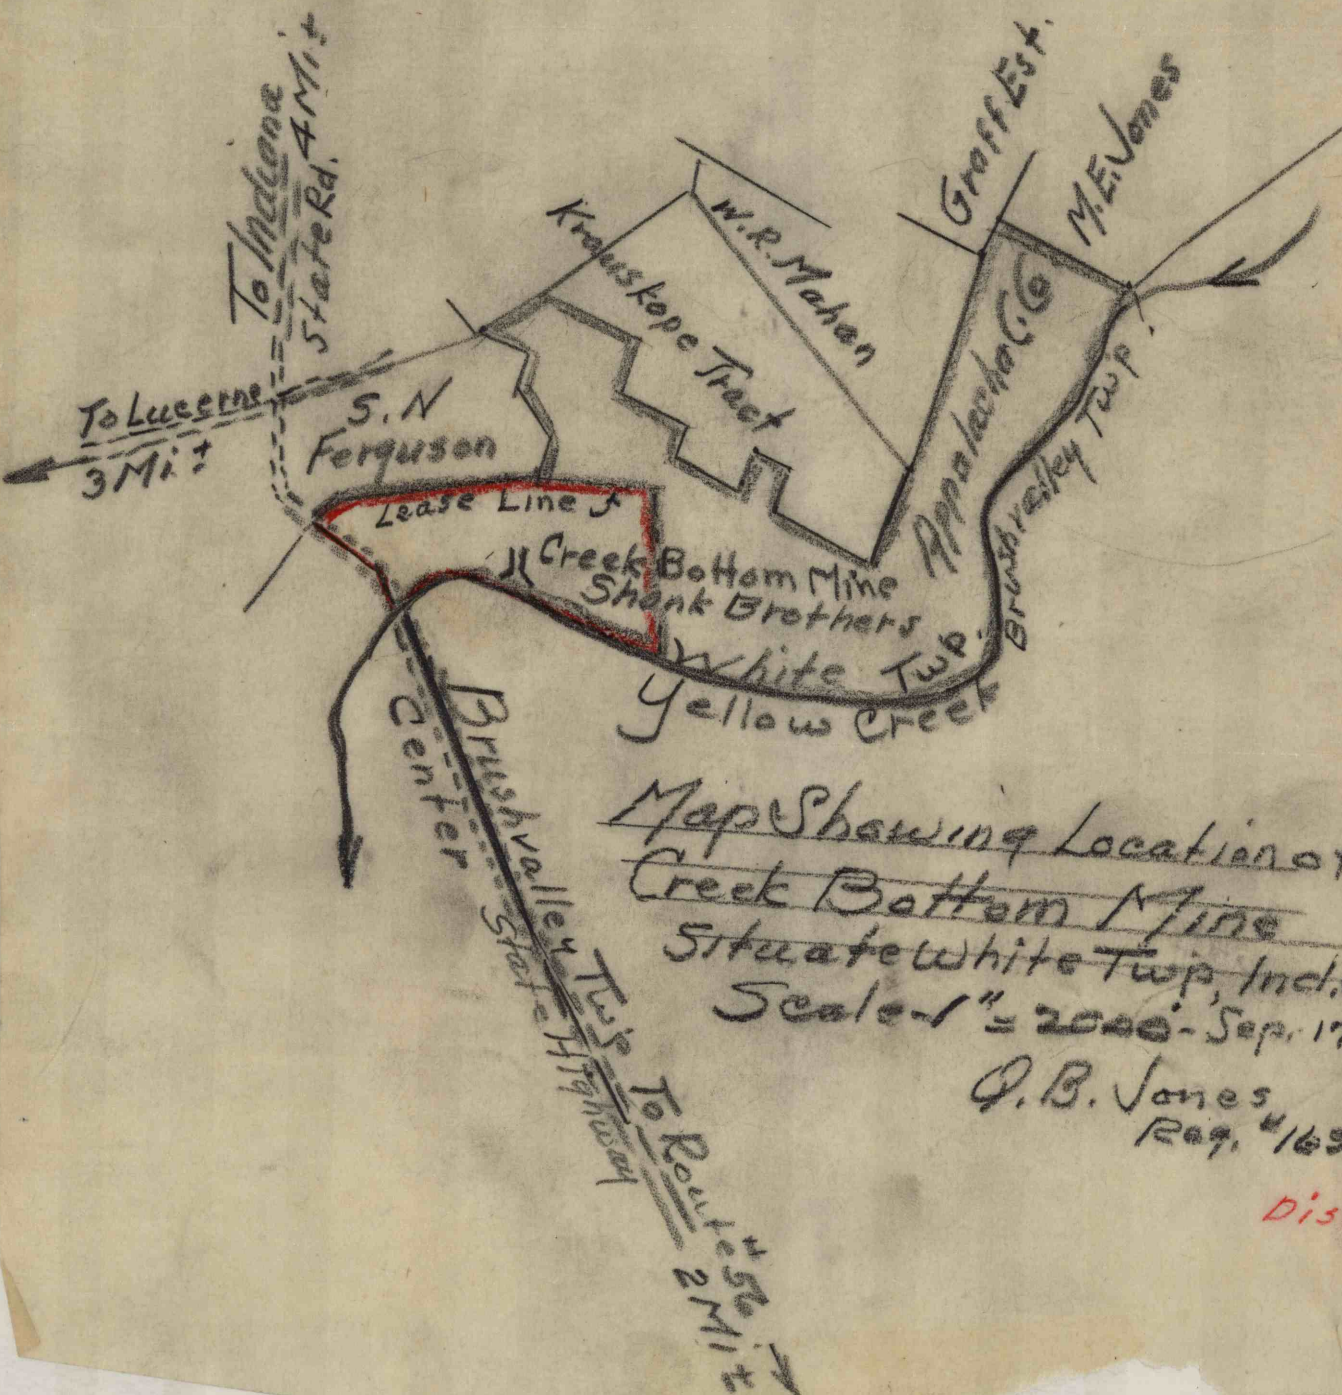

Map Showing Location of
 Creek Bottom Mine
 Situate White Twp, Ind. Co., Pa.
 Scale - 1" = 2000' - Sep. 17-'57

Q. B. Jones
 Reg. #1691

Dist 25 1956