


MASONTOWN QUADRANGLE N. W. 4

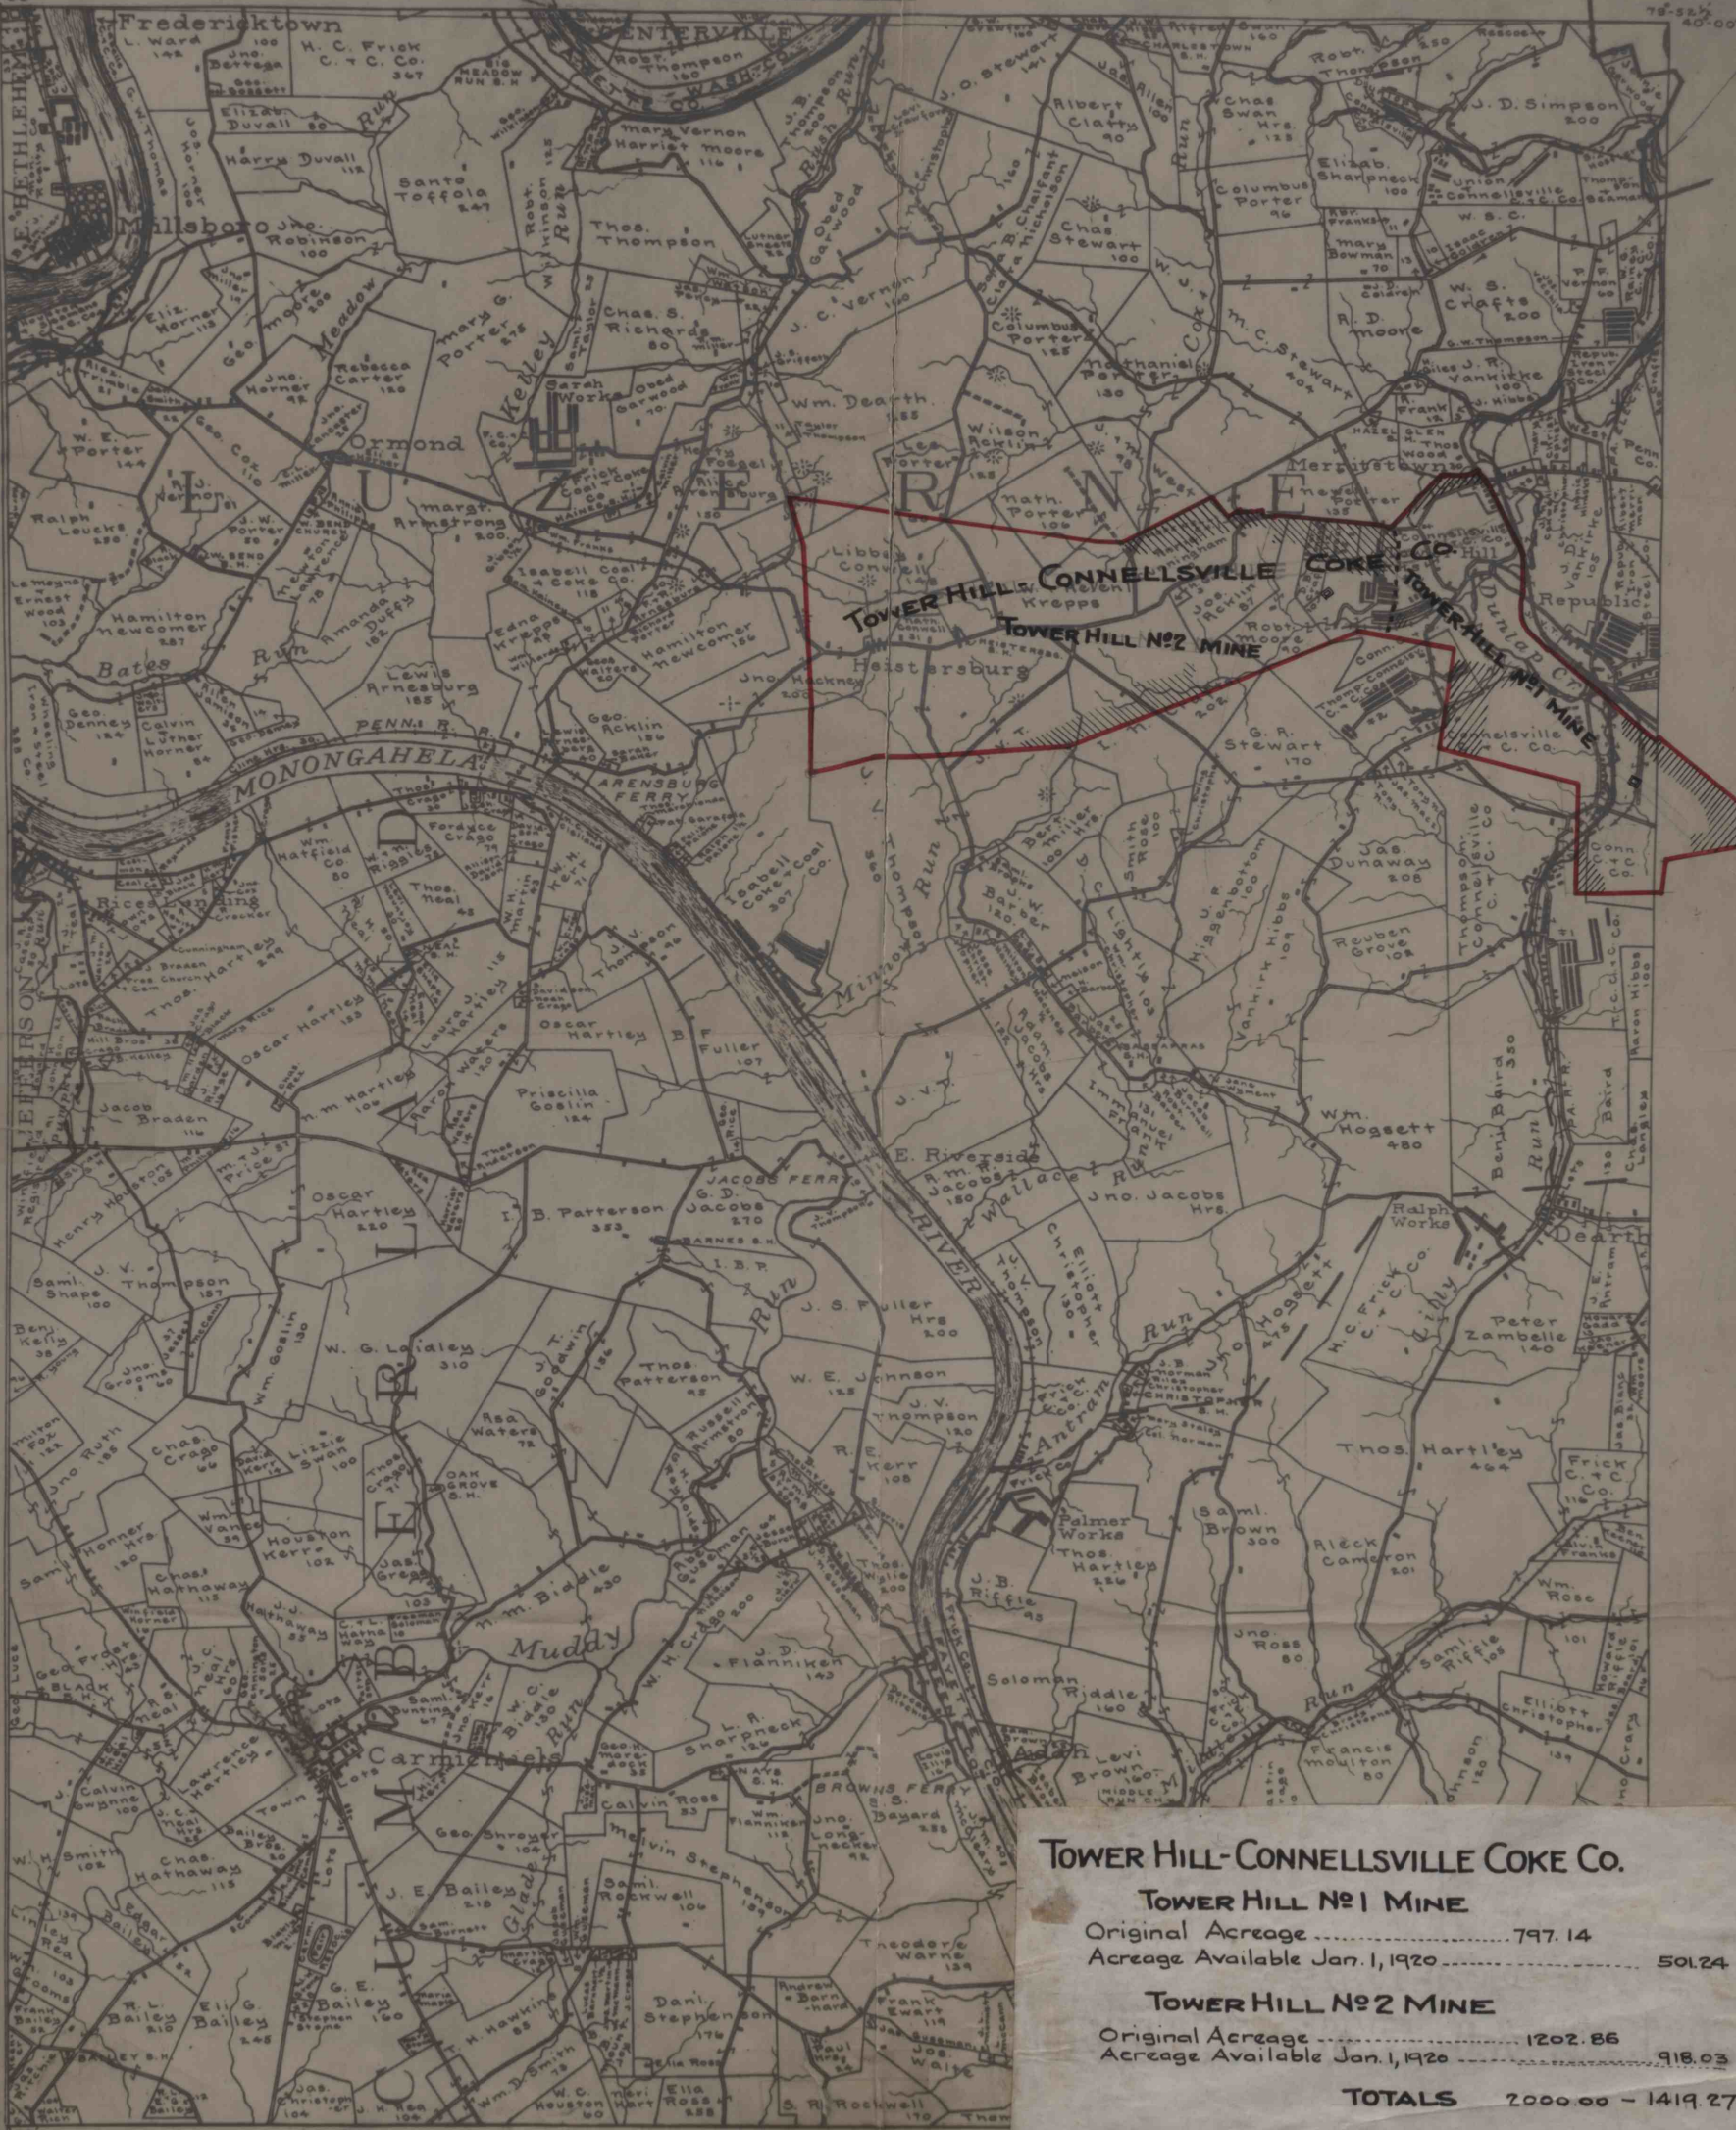

TOWER HILL-CONNELLSVILLE COKE CO.	
TOWER HILL No. 1 MINE	
Original Acreage	797.14
Acreage Available Jan. 1, 1920	501.24
TOWER HILL No. 2 MINE	
Original Acreage	1202.86
Acreage Available Jan. 1, 1920	918.03
TOTALS	2000.00 - 1419.27