


DISCLAIMER: This map is provided as a courtesy to the Pennsylvania Bureau of Deep Mine Safety by American Premier Underwriters, Inc. (fka The Penn Central Railroad Corporation) and its subsidiary United Railroad Corp., which own or owned, but do not operate, the coal assets depicted hereon.

American Premier Underwriters, Inc. and United Railroad Corp. disclaim any representation or duty to any person as to the accuracy or completeness of this map or its fitness for any particular mining, safety or real estate related purpose. Any person who uses this map for any reason undertakes an independent duty to verify its accuracy and completeness, assumes all risks of its use, and agrees to hold American Premier Underwriters, Inc., United Railroad Corp. and their respective affiliates, shareholders, directors, officers and employees harmless from damage or liability arising from its use.

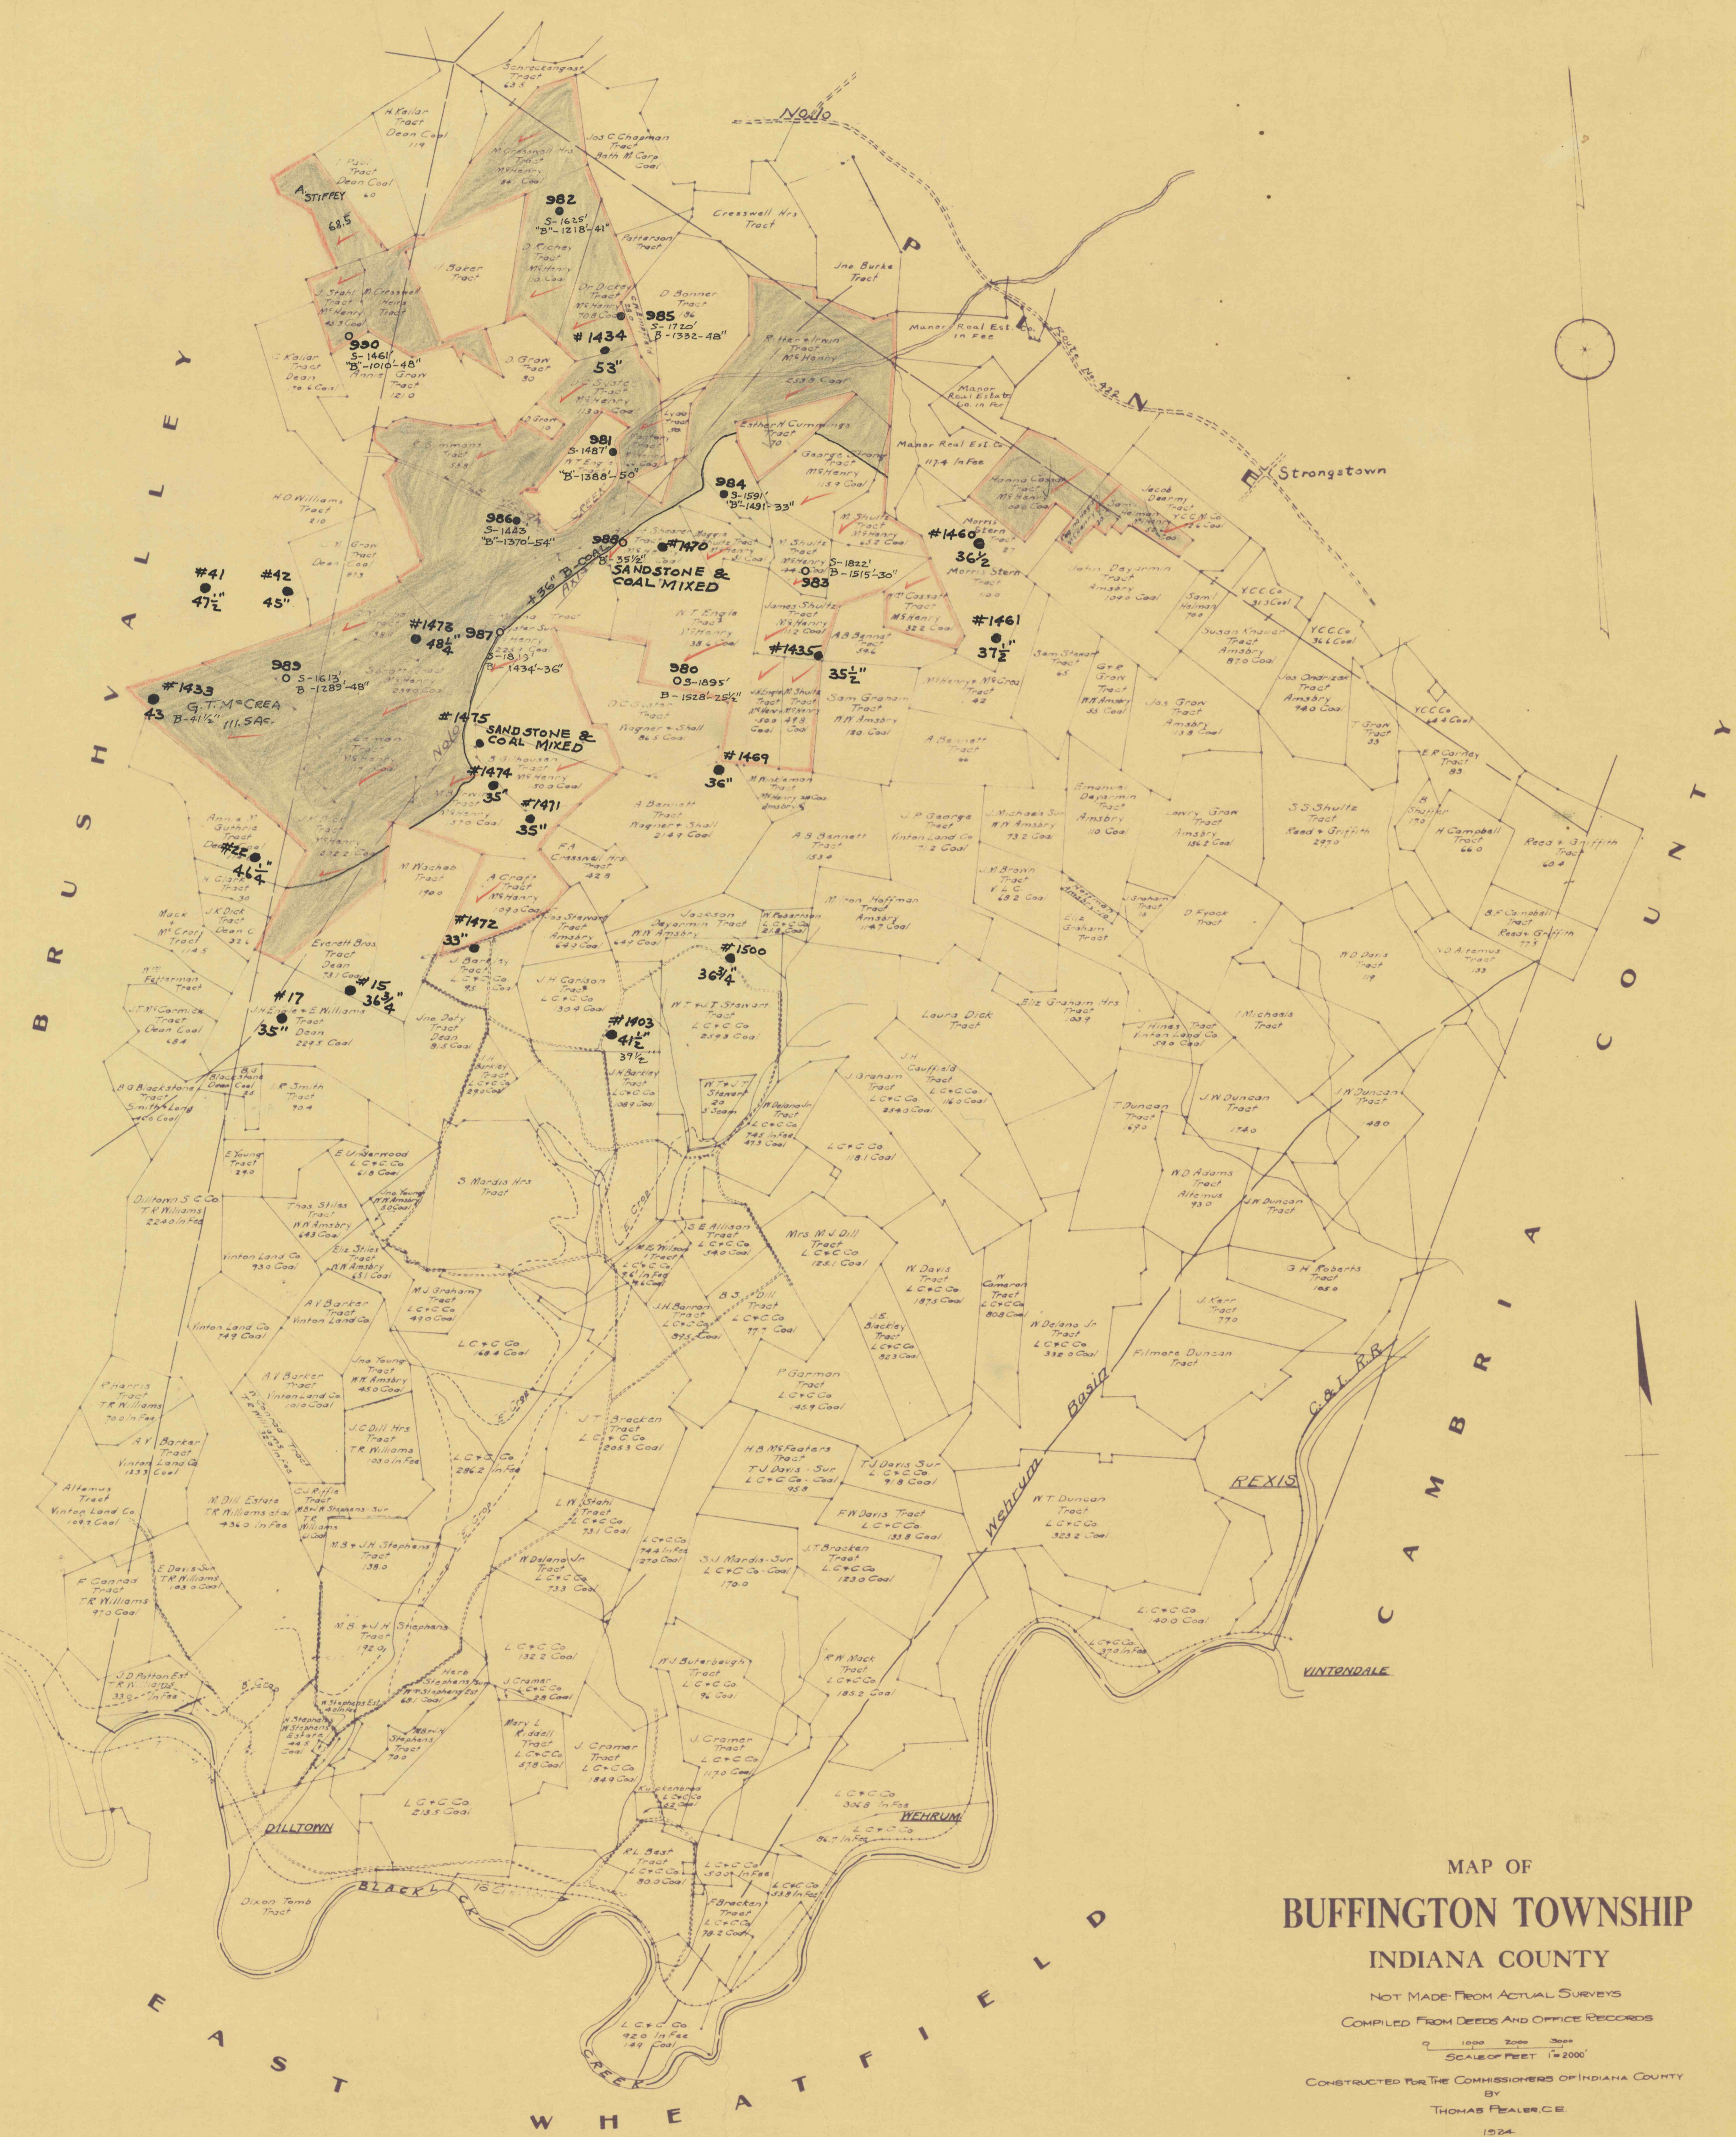

MAP OF
BUFFINGTON TOWNSHIP
INDIANA COUNTY

NOT MADE FROM ACTUAL SURVEYS
COMPILED FROM DEEDS AND OFFICE RECORDS
SCALE OF FEET 1"=200'
CONSTRUCTED FOR THE COMMISSIONERS OF INDIANA COUNTY
BY
THOMAS FEALERCE
1934

"B" SEAM

Approx
+ 36" Coal - 2010 AC @ 66 2/3% Recovery 42.5' avg Ht = 8,556,600 Tons
+ 36" Coal - 149 AC @ 66 2/3% Recovery 36" avg Ht = 536,400 "
- 36" Coal - 1309 AC
Total = 3468 AC.

Note - This Estimate is Approximate as this is a Farm Line Map and not necessarily to scale, also this affects location of D.D. Holes.