

MATCH LINE MAP M16

3B COAL COMPANY (SINK CONSTRUCTION INC.)
COAL - SINK CONSTRUCTION INC.

PAUL TEDROW
C/O ALAN TEDROW
COAL - PAUL TEDROW
KB

DDH 2-58

Not
Mined

DDH GW5

No Mining On
This Sheet
During The Period
Final Map

N 276,000


N 276,000

N 277,000

N 277,000

LEGEND

- MINE ACTIVITY PERMIT NO.56841318
- BOUNDARY OF SUBSIDENCE PERMIT.
- PROTECTED STRUCTURES. 2
- OTHER STRUCTURES. 2A,2B
- DENOTES BUILT AFTER THE ACT. AA
- OCCUPANT - NOT OWNER. 3L
- CONTEMPLATED MINING 9-15-98 TO 3-15-99
- SUPPORT AREA.
- PAST SIX MONTH MINING.
- WELL
- SPRING
- C PRIME - UPPER KITTANNING

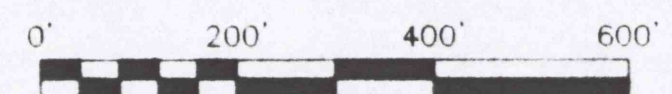

PIERPONT NO.10 MINE
QUEMAHONING TOWNSHIP SOMERSET COUNTY
UPPER KITTANNING - C' SEAM

CONTRACT OPERATOR
PIERPONT MINING, INC.
P.O. BOX 286
SOMERSET, PA. 15501


SOLAR NO.10 MINE
QUEMAHONING TOWNSHIP SOMERSET COUNTY
UPPER KITTANNING - C' SEAM

SOLAR FUEL COMPANY
BOX 488
SOMERSET, PA. 15501

SHEET INDEX

M15	M16	N13
M19	M20	N17
R7	R8	S5

RECEIVED
OCT 15 1998
Dept. of Environmental Protection
Administrative Services Office

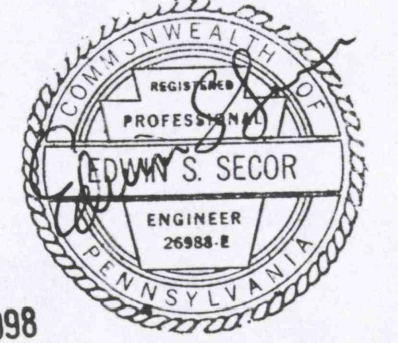

OCT 14 1998

M20