


**DISCLAIMER:** This map is provided as a courtesy to the Pennsylvania Bureau of Deep Mine Safety by American Premier Underwriters, Inc. (Was The Penn Central Railroad Corporation) and its subsidiary United Railroad Corp. which own or control, but do not operate, the coal assets depicted hereon.

American Premier Underwriters, Inc. and United Railroad Corp. disclaim any representation or duty to any person as to the accuracy or completeness of this map or its fitness for any particular mining, safety or real estate related purpose. Any person who uses this map for any reason understands, and independent duty to verify its accuracy and completeness, assumes all risks of its use, and agrees to hold American Premier Underwriters, Inc., United Railroad Corp. and their respective affiliates, shareholders, directors, officers and employees harmless from damage or liability arising from its use.

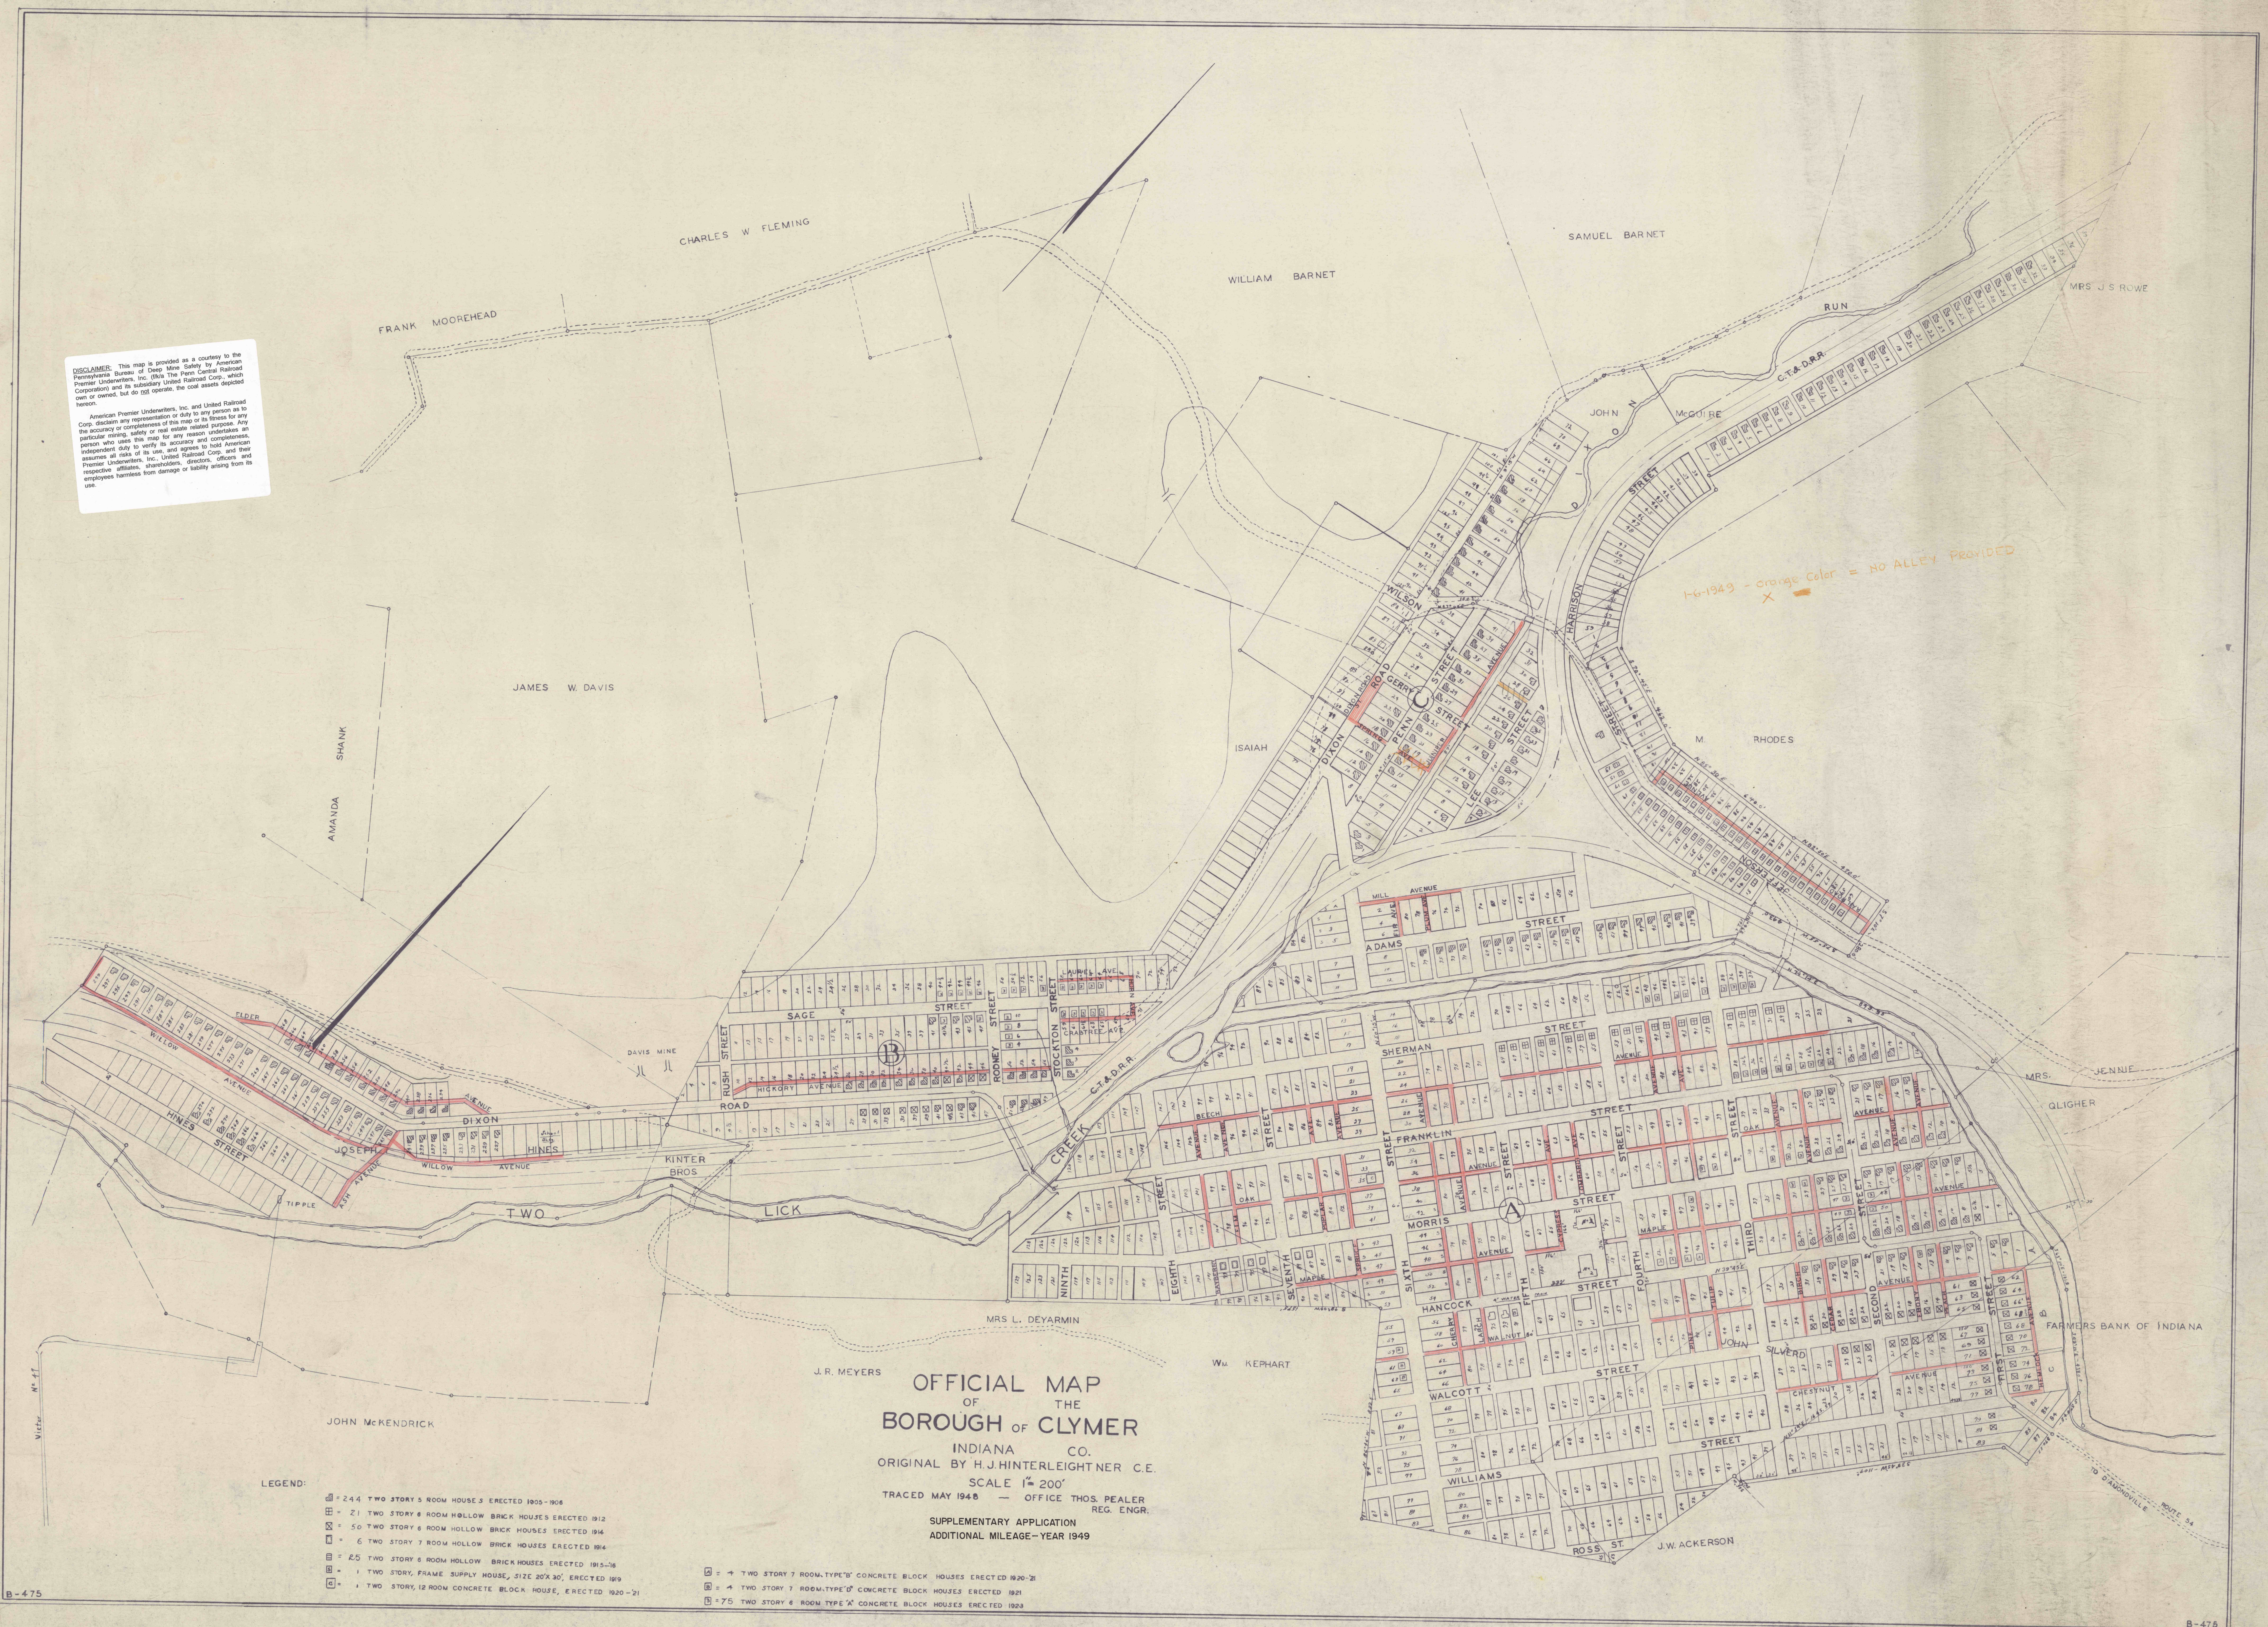

**OFFICIAL MAP**  
OF THE  
**BOROUGH OF CLYMER**  
INDIANA CO.  
ORIGINAL BY H.J. HINTERLEIGHTNER C.E.  
SCALE 1" = 200'  
TRACED MAY 1948 — OFFICE THOS. PEALER  
REG. ENGR.  
SUPPLEMENTARY APPLICATION  
ADDITIONAL MILEAGE—YEAR 1949

- LEGEND:**
- = 244 TWO STORY 3 ROOM HOUSES ERECTED 1905-1906
  - = 21 TWO STORY 6 ROOM HOLLOW BRICK HOUSES ERECTED 1912
  - = 50 TWO STORY 6 ROOM HOLLOW BRICK HOUSES ERECTED 1914
  - = 6 TWO STORY 7 ROOM HOLLOW BRICK HOUSES ERECTED 1914
  - = 25 TWO STORY 6 ROOM HOLLOW BRICK HOUSES ERECTED 1915-16
  - = 1 TWO STORY, FRAME SUPPLY HOUSE, SIZE 20'X30', ERECTED 1919
  - = 1 TWO STORY, 12 ROOM CONCRETE BLOCK HOUSE, ERECTED 1920-21
  - = 4 TWO STORY 7 ROOM, TYPE "B" CONCRETE BLOCK HOUSES ERECTED 1920-21
  - = 4 TWO STORY 7 ROOM, TYPE "D" CONCRETE BLOCK HOUSES ERECTED 1921
  - = 75 TWO STORY 6 ROOM, TYPE "A" CONCRETE BLOCK HOUSES ERECTED 1923