


**DISCLAIMER:** This map is provided as a courtesy to the Pennsylvania Bureau of Deep Mine Safety by American Premier Underwriters, Inc. (fka The Penn Central Railroad Corporation) and its subsidiary United Railroad Corp., which own or owned, but do not operate, the coal assets depicted herein.

American Premier Underwriters, Inc. and United Railroad Corp. disclaim any representation or duty to any person as to the accuracy or completeness of this map or its fitness for any particular mining, safety or real estate related purpose. Any person who uses this map for any reason undertakes an independent duty to verify its accuracy and completeness, assumes all risks of its use, and agrees to hold American Premier Underwriters, Inc., United Railroad Corp. and their respective affiliates, shareholders, directors, officers and employees harmless from damage or liability arising from its use.

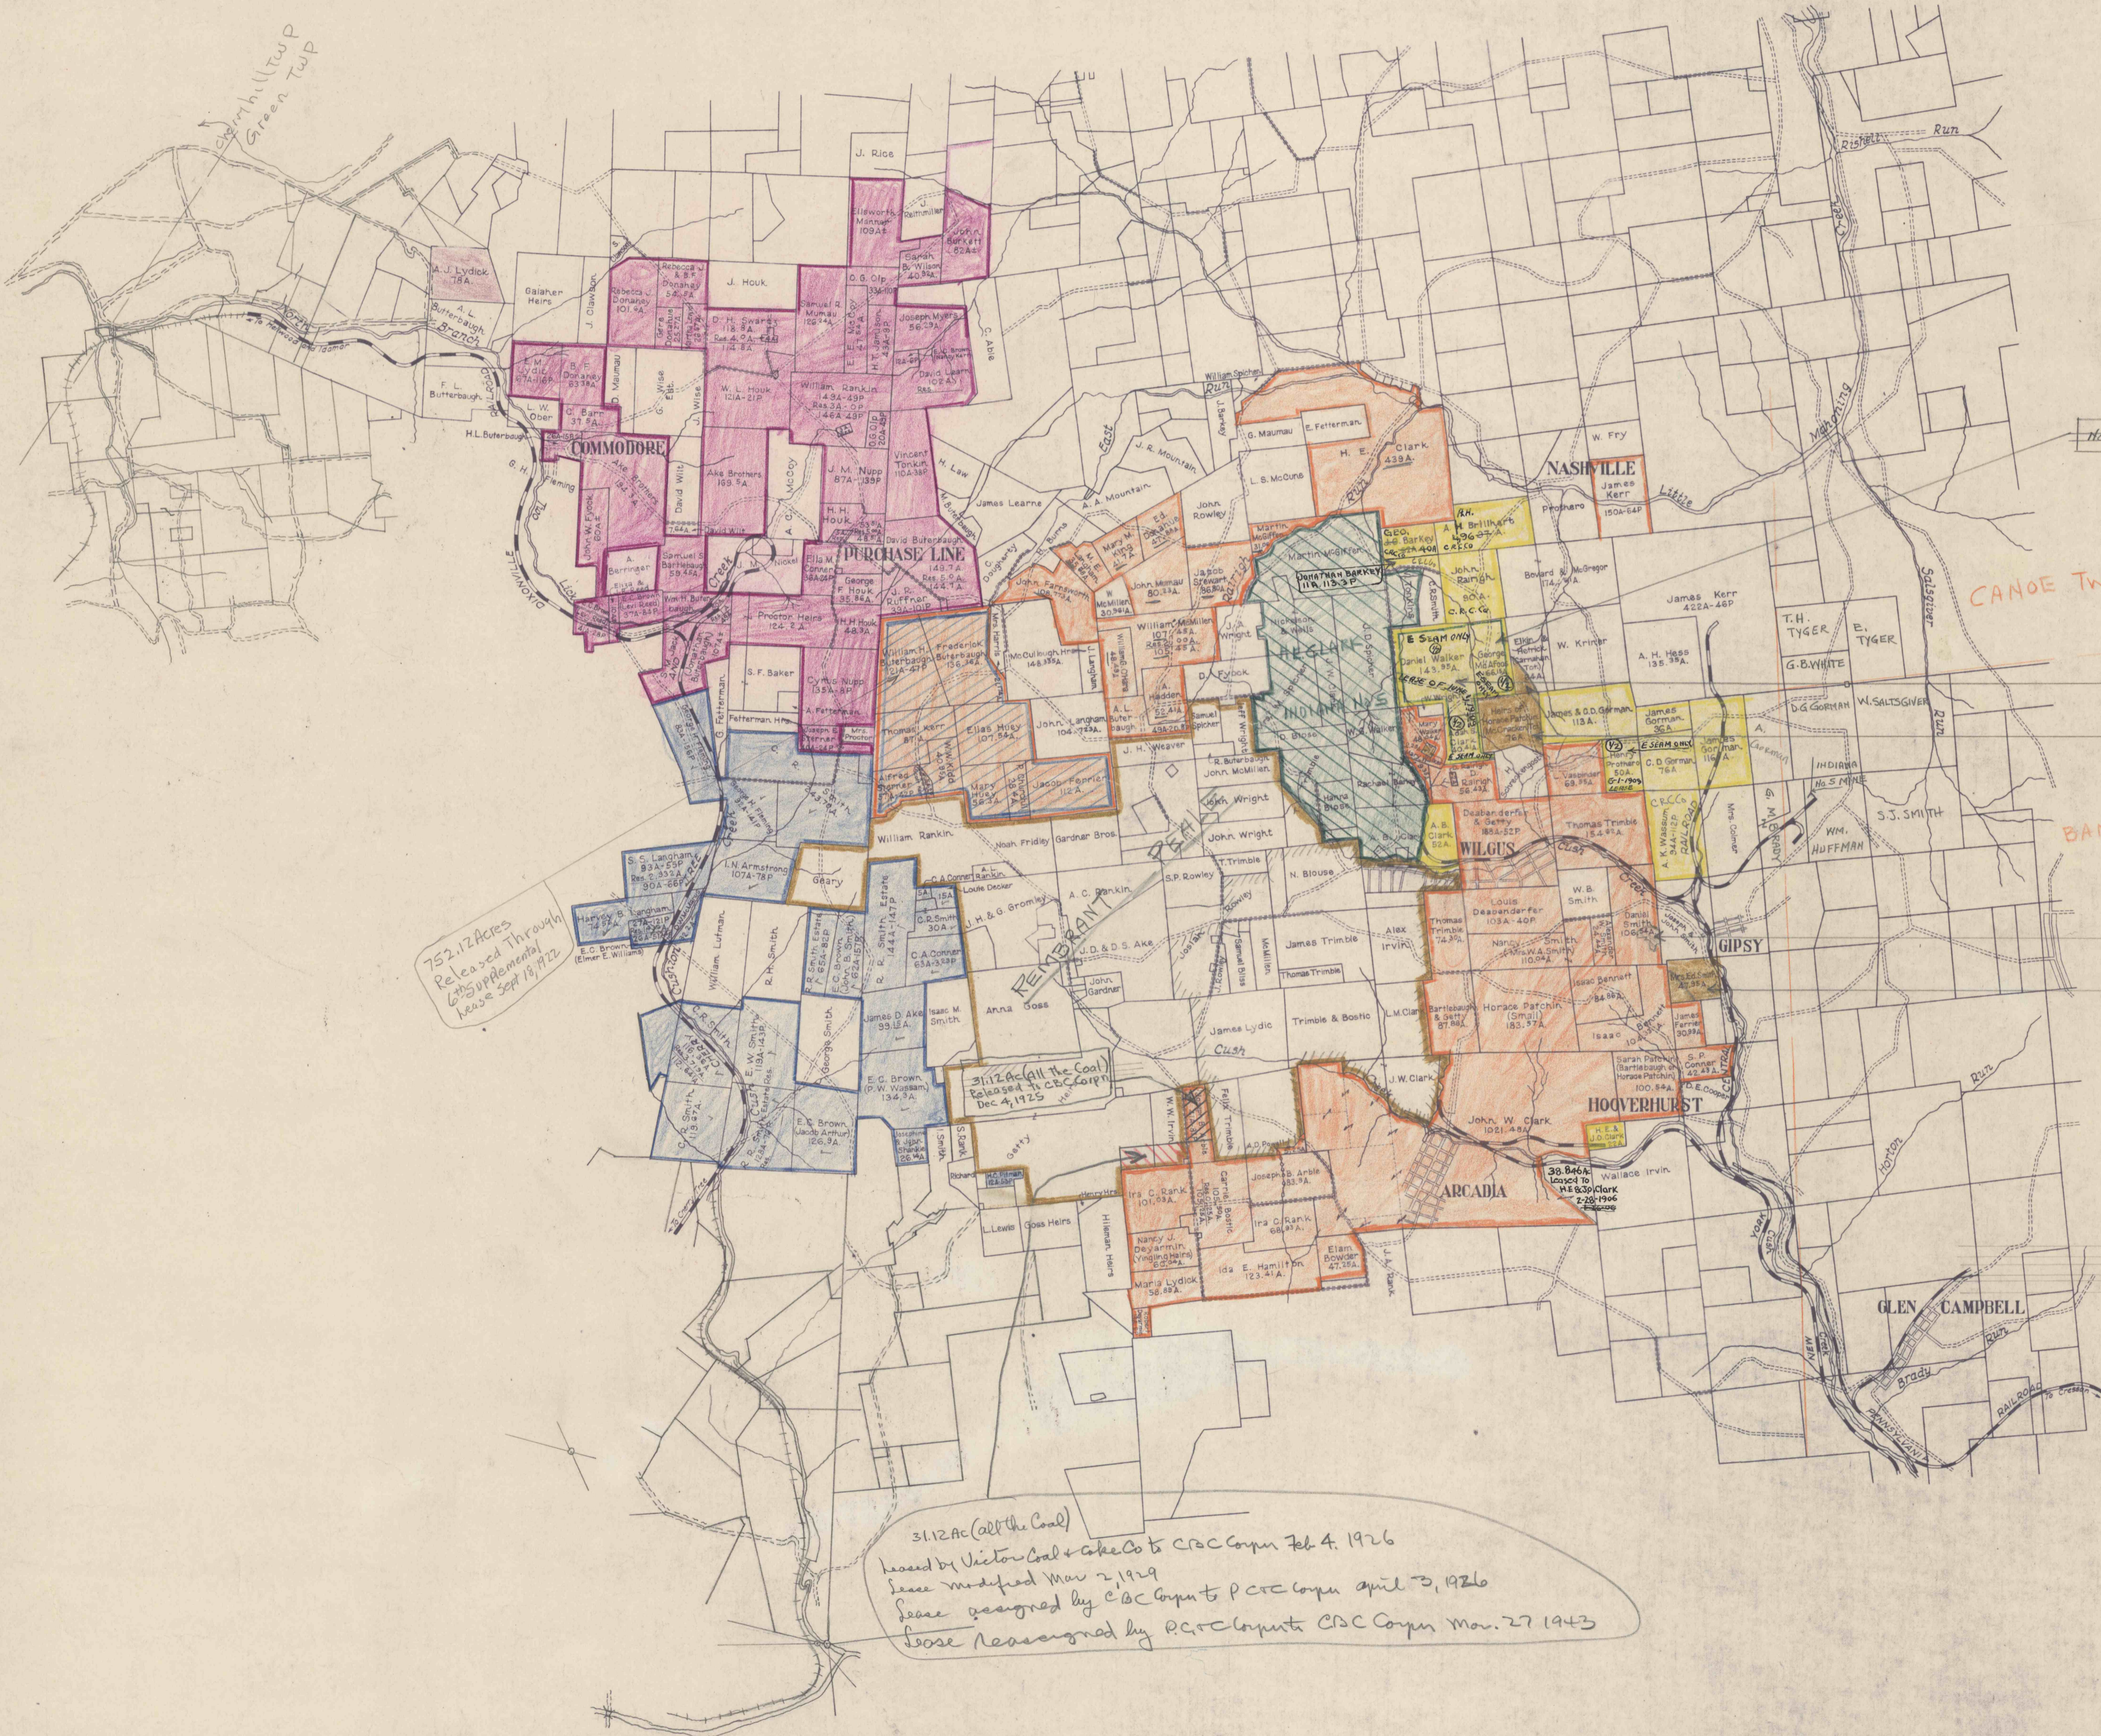

NOV. 17, 1915 SUPPLEMENT TO LEASE OF JUNE 1, 1909

DEED  
CHESTNUT RIDGE COAL CO (E-SEAM ONLY)  
TO  
P.C. & C. CORPN OCT. 29, 1935  
LEASE EXPIRED MARCH 25, 1926

7,385 AC BED E-COAL  
SUBLEASED BY P.C. & C. CORPN  
TO  
JOSEPH SMITH AUG. 2, 1937

LEASED BED E COAL TO C.D. GORMAN BY P.C. & C. CORPN JAN. 8, 1912  
RELEASED TO C.D. GORMAN BY P.C. & C. CORPN JAN. 14, 1926

752.17 Acres  
Released Through  
6th Supplemental  
Lease Sept 19, 1922

31.12 Ac (all the Coal)  
Released to C.B.C. CORPN  
Dec. 4, 1925

31.12 Ac (all the Coal)  
leased by Victor Coal & Coke Co to C.B.C. CORPN Feb. 4, 1926  
Lease modified Mar 2, 1929  
Lease assigned by C.B.C. CORPN to P.C. & C. CORPN April 3, 1926  
Lease reassigned by P.C. & C. CORPN to C.B.C. CORPN Mar. 27, 1943

- LEGEND**
- HOLDINGS OF P.C. & C. CORPN IN ARCADIA DISTRICT
  - PROPERTY LEASED BY C.B.C. CORPN TO P.C. & C. CORPN NOV. 15, 1911
  - PROPERTY SUBLEASED BY " " "
  - PROPERTY LEASED DIRECTLY BY P.C. & C. CORPN " "
  - PROPERTY LEASED BY C.B.C. CORPN TO P.C. & C. CORPN NOV. 15, 1911
  - RELEASED BY C.B.C. CORPN TO C.B.C. CORPN THROUGH MODIFYING AGREEMENT JUNE 1, 1913
  - PROPERTY ACQUIRED BY C.B.C. CORPN FROM P.C. & C. CORPN NOV. 15, 1911
  - AND NOT SUBSEQUENTLY CONTROLLED BY P.C. & C. CORPN (NOT IN P.C. & C. CORPN LEASES)
  - MAP REVISED SEPTEMBER 11, 1926
  - PEALE, REMBRANT
  - H.E. CLARK and No. 5 mine

PENNSYLVANIA COAL & COKE CORPORATION  
ARCADIA AND PURCHASE LINE DISTRICTS  
GRANT AND MONTGOMERY TOWNSHIPS, INDIANA COUNTY, PENNA.  
ENGR. DEPT. P.C. & C. CORPN. CRESSON, PA. MAR. 12, 1922.  
SCALE 1:3000'