


MAP OF MINERAL LANDS
OF
KIER FIRE BRICK COMPANY

NEAR SALINA, WESTMORELAND CO., PA.
SCALE: 1" = 400' J.S. SILLIMAN & CO., ENGRS
MAR. 1924 ALTOONA, PA.

MINE WORKINGS, AND PROPERTY LINES MARKED WITH COURSES AND
DISTANCES WERE SURVEYED BY US.
OTHER PROPERTY LINES AND DATA PLOTTED FROM DRAFTS BY OTHER
ENGINEERS AND BY P.R.R. CO. OR FROM DEEDS
D.D. HOLES LOCATED BY US MARKED THUS: ©
D.D. HOLES LOCATED BY OTHER ENGINEERS MARKED THUS: ©

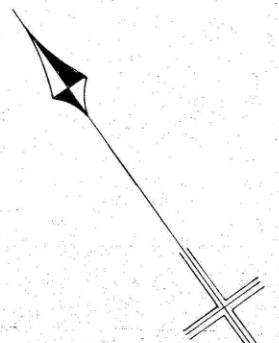

R. H. BUSH

O. H. FERGUSON

J. F. WOLFORD

WM. BORTS

JOHN MCGAULEY

ANANIAS HILTY

CHAS. CARMANAN

© D.D. HOLE NO. 3
(COCHRAN COAL CO.)

LABANNAH CARMANAN

LUCIEN CLAWSON

J. B. YOGKEY

T. D. HINE

© D.D. HOLE NO. 4
(COCHRAN COAL CO.)

W. J. DETTMAN
KIER FIRE BRICK CO. - CLAY
KIER FIRE BRICK CO. - CLAY
© D.D. HOLE NO. 1
© D.D. HOLE NO. 2
G. S. APPLE
FIRE BRICK CO. - CLAY

W. C. ALGORN

MRS. MATHILDA RAMSEY

DAVID WILLARD

© D.D. HOLE NO. 1
(COCHRAN COAL CO.)

JOHN SMELTZER

MATTHIAS YOGKEY

JAS. KLUGH