


(HARVE-MACK COAL CO. SIDING)
Property of C.T. & D. R.R. Co.
255.65
N 22°-58' E

MIKE PATSIC
TO
HARVE-MACK COAL CO.
Situate - Green Twp. Ind. Co. Pa.
Scale 1"=40' Sept. 9, 1922
Office of Thos. Pealer C.E.

2.335 Acres.

Shanties on this tract.

MIKE PATSIC

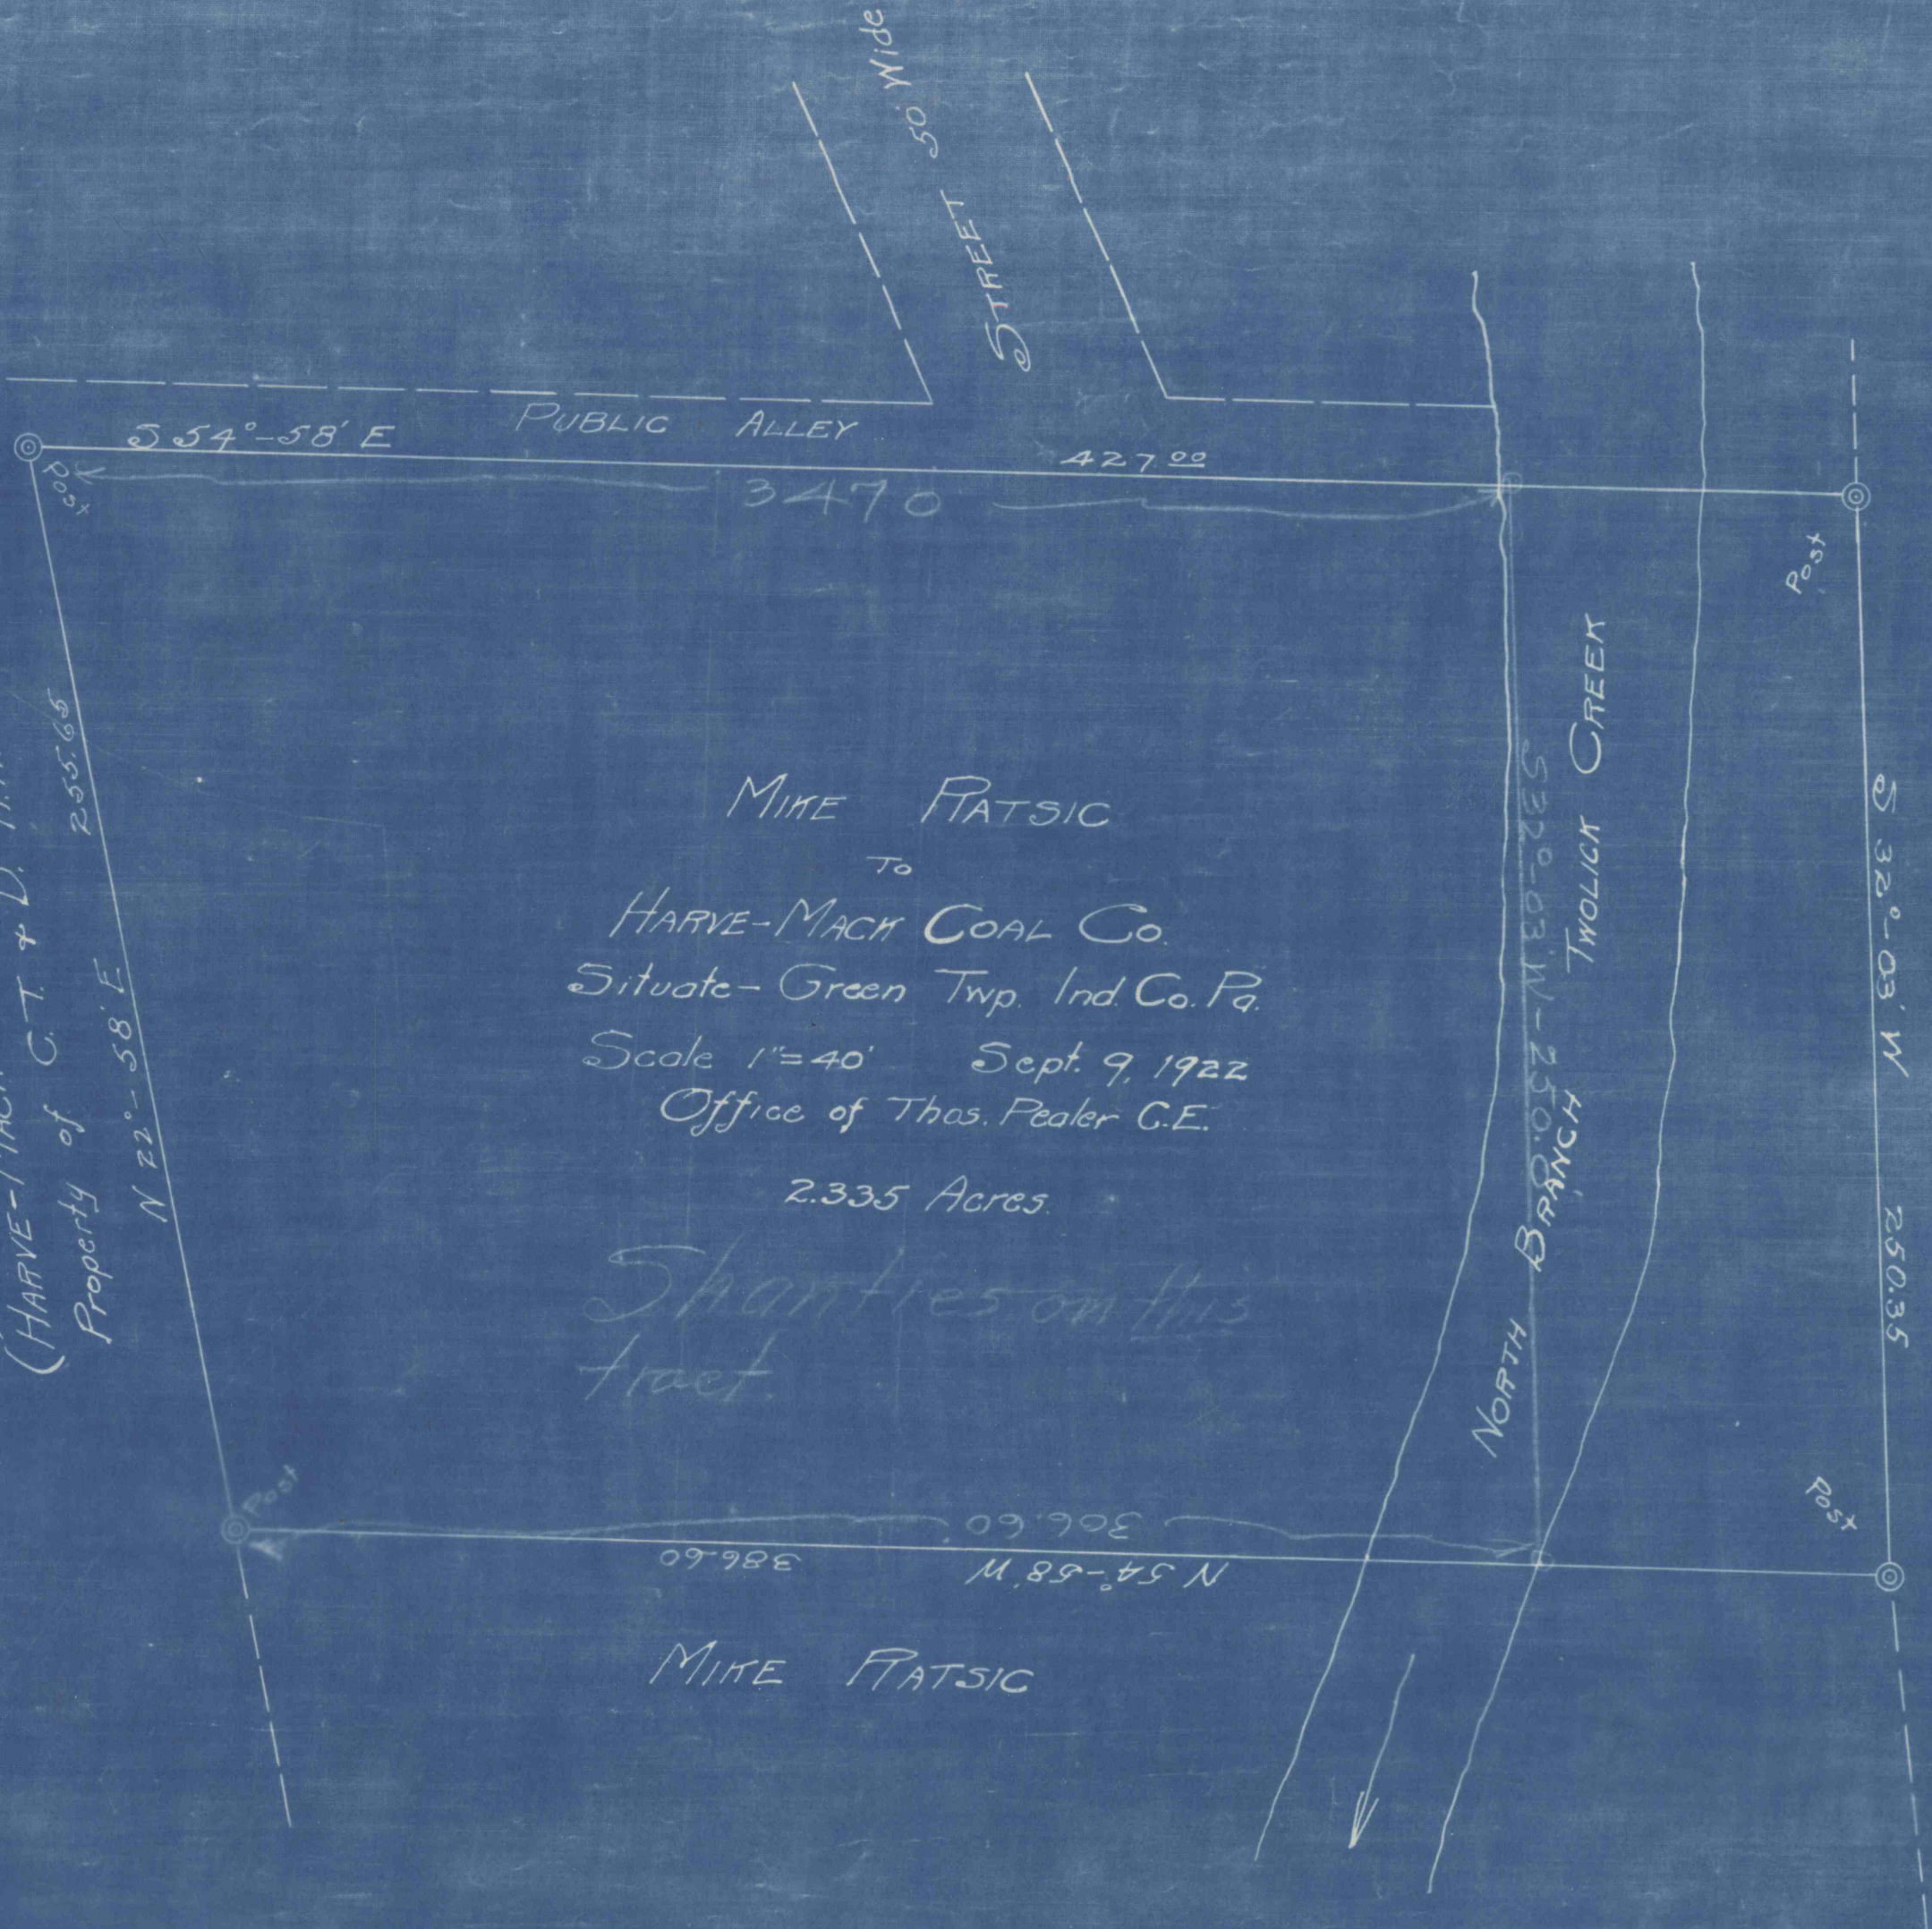

C.T. & D. R.R. Co.