

**COAL LANDS
OF
A.G. CAMPBELL**

SITUATED IN LOYALHANNA TWP.
WESTMORELAND CO., PA.

CONTAINING 229.62 ACRES. + 8.513 = 238.133 ACRES
6/10/15

DEC. 6, 1913

ALBERT SMITH C.E.
SALTSBURG PA.


ELIJAH BORTZ


L.B. BASH

W.M. BASH

A.K. JOHNSTON.

THOMAS KING

HEIRS OF
SAMUEL STEEL

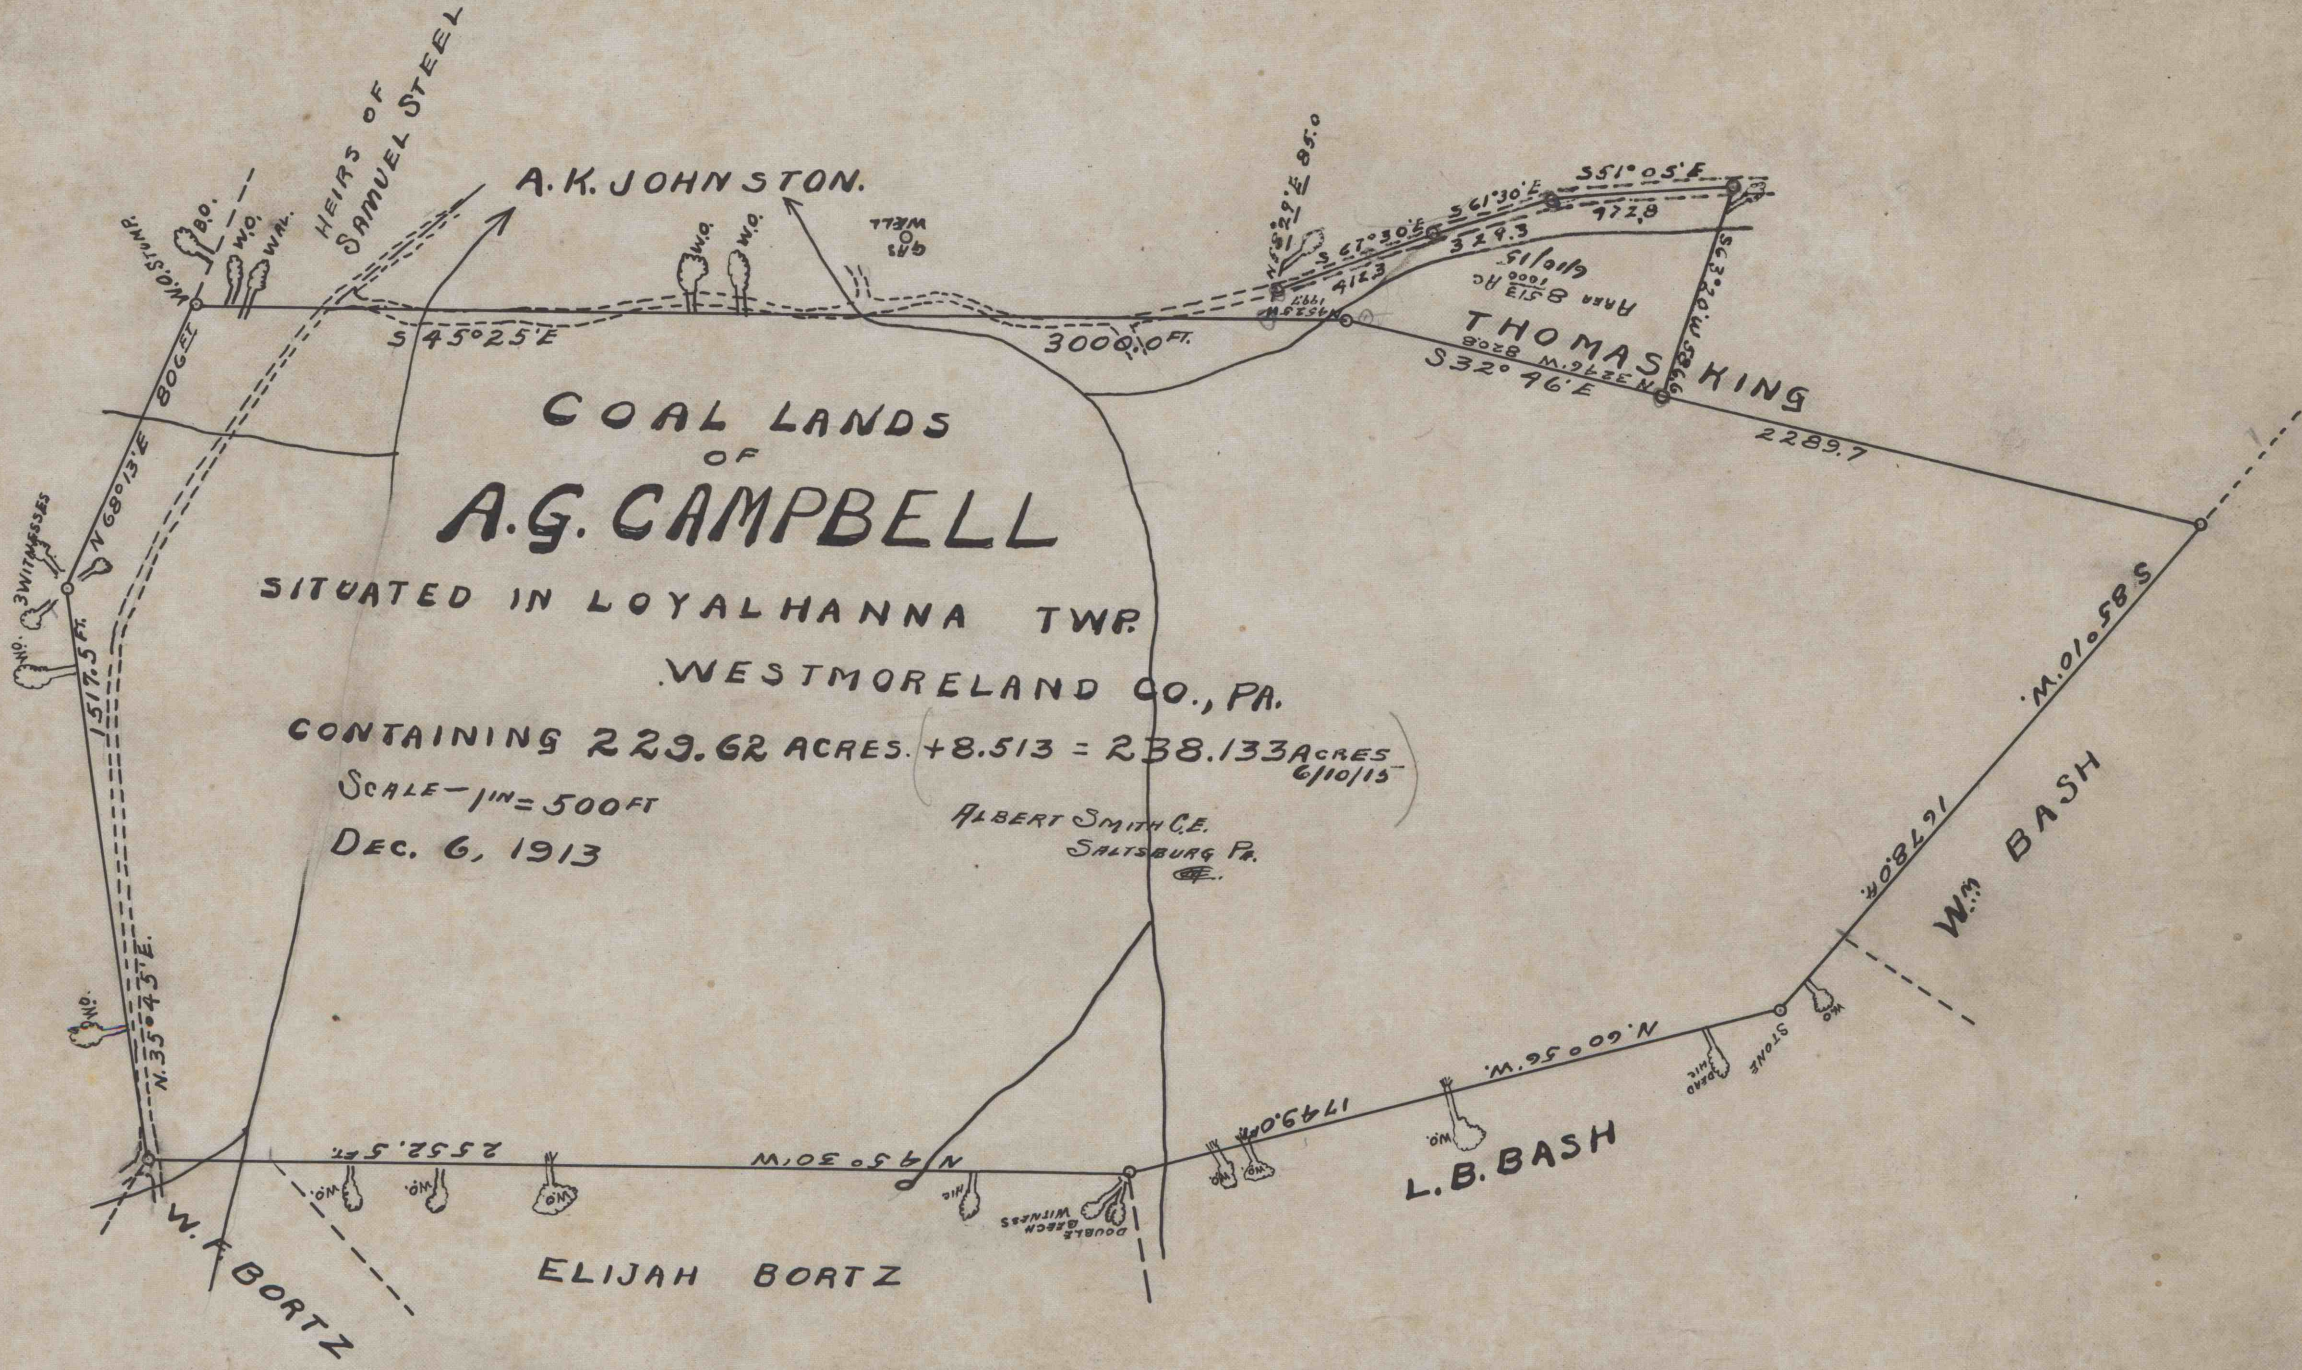

4325
4-4
L.H. 3030