

20 to # 29
Torn down in 1920

TO JACKSONVILLE

PUBLIC


ROAD

TO HONER CITY

Blacklick
TO

ABOUT 1200 FEET

TO JACKSONVILLE
TO HONER CITY
PUBLIC ROAD
TO

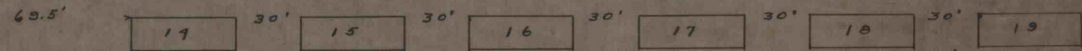

69.5'

51'

30'

30'

30'

30'

30'

30'

30'

30'

30'

30'

30'

BUILDINGS
OF
GRAFF COAL CO

BLACKLICK TOWNSHIP INDIANA COUNTY PENNA.
SCALE 1" = 50' JULY 5, 1918 ALBERT SMITH C.E.
SALTSBURG PA.

SHEET # 2

Revised Sept. 26, '23

TO JACKSONVILLE
TO HONER CITY
PUBLIC ROAD
TO

11 TO 19 1 story



C-2103