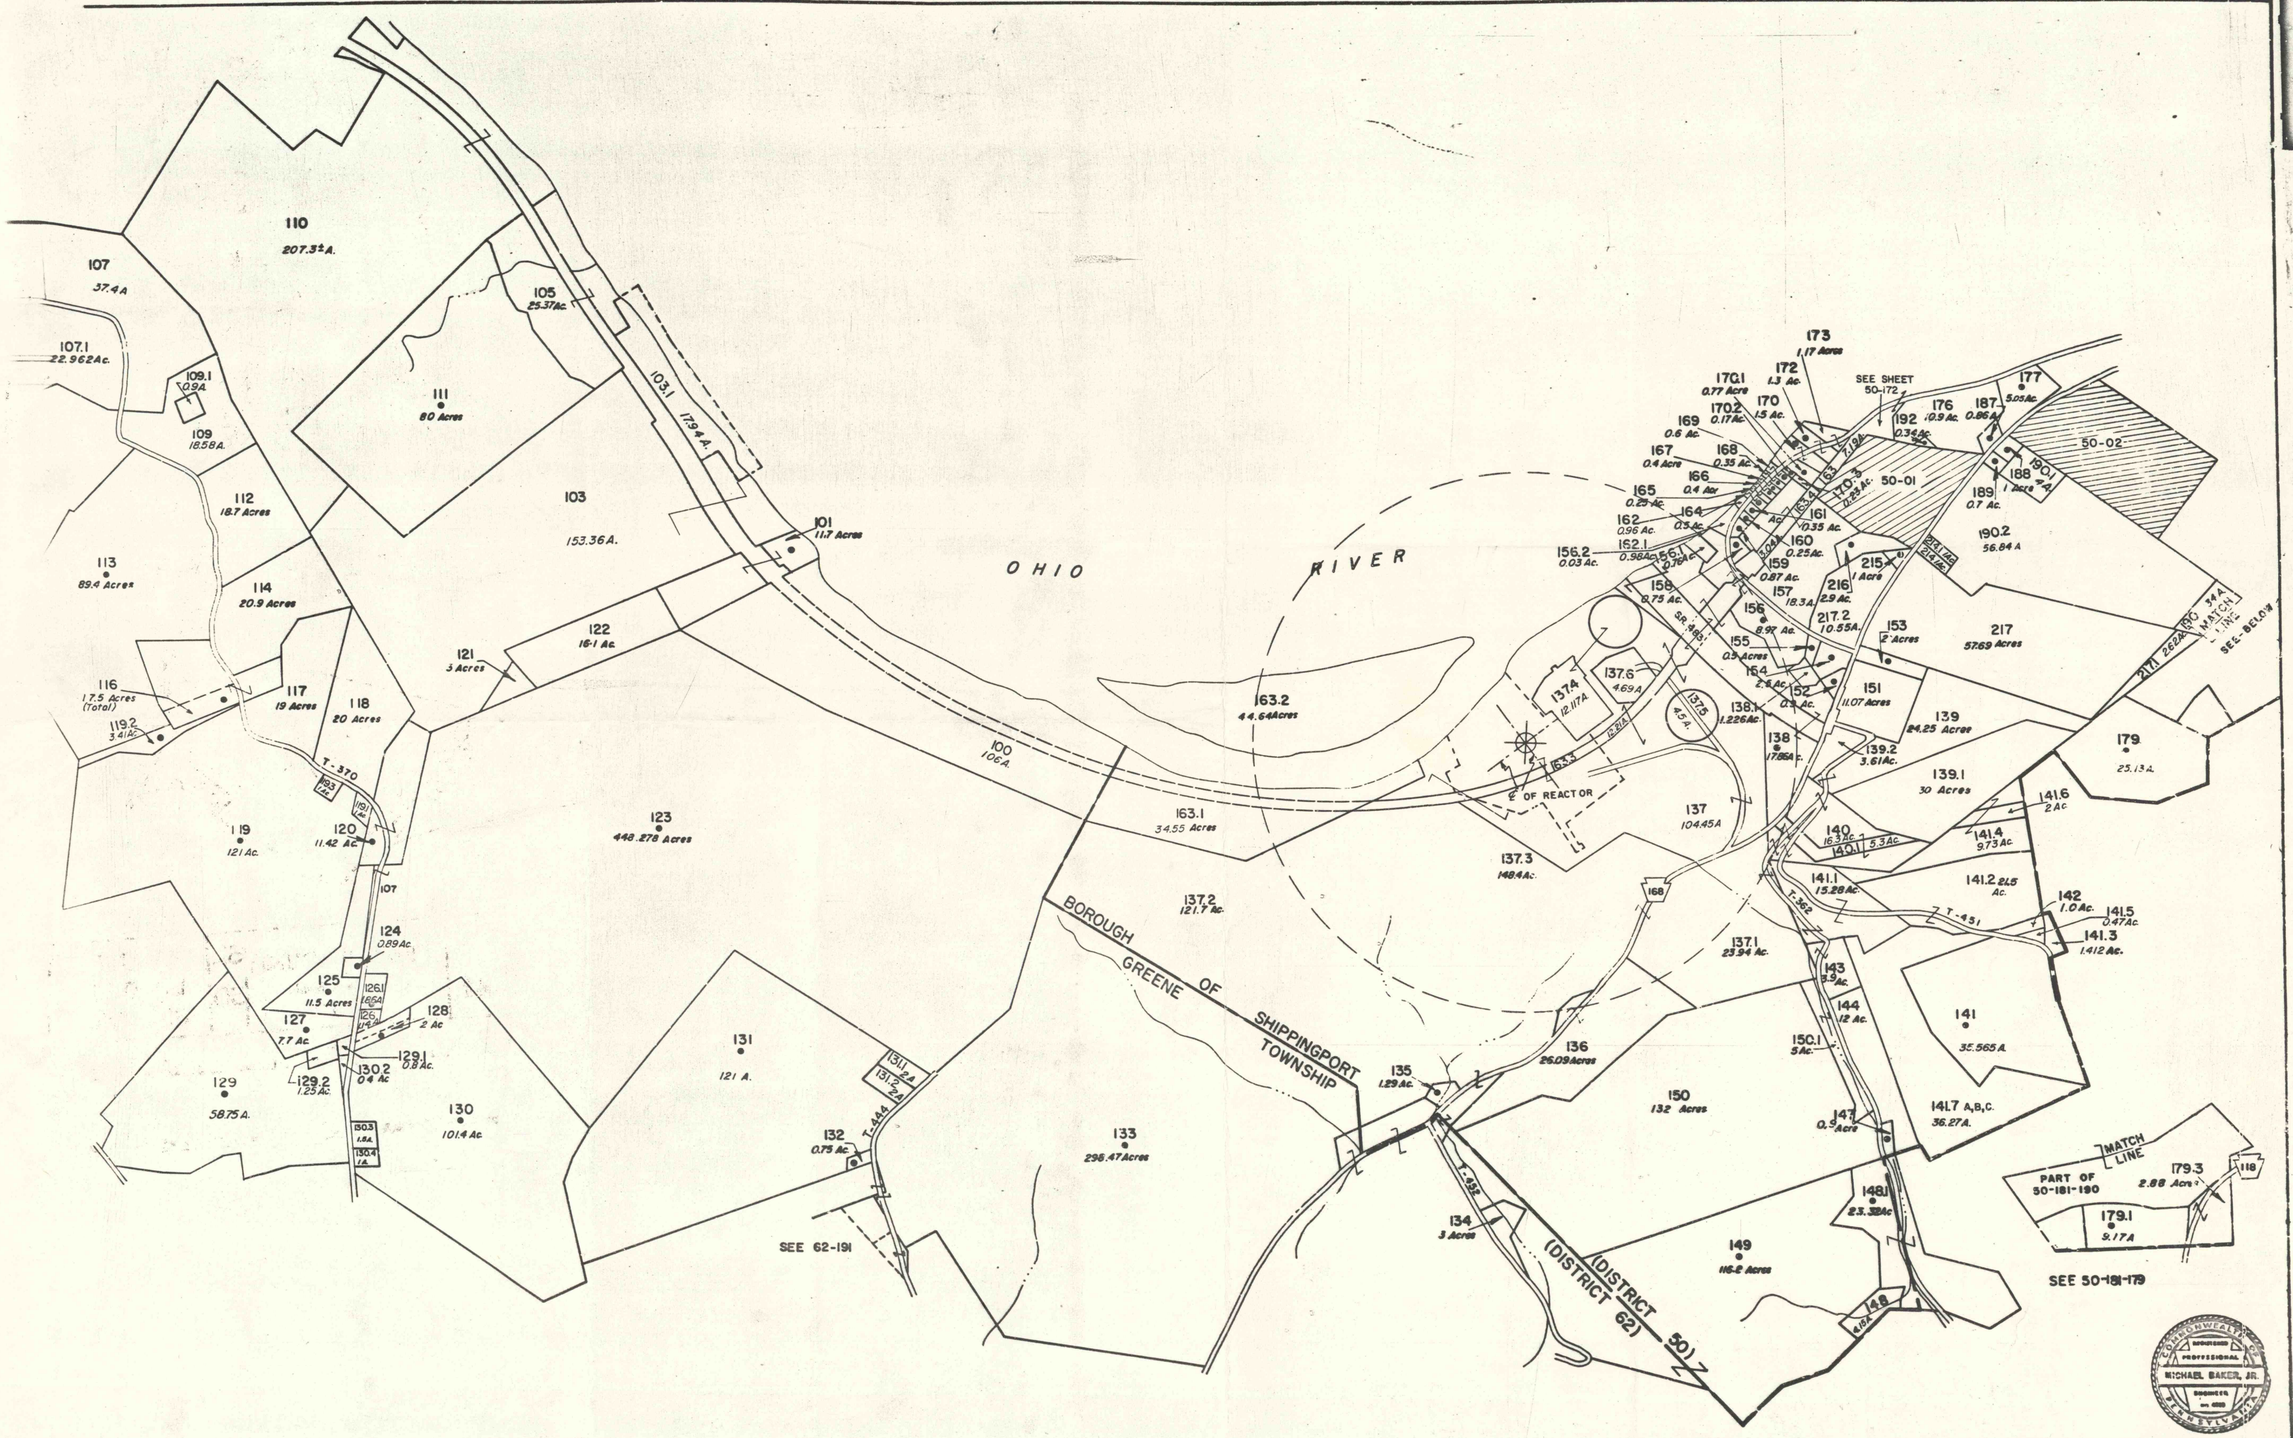

BY					
	2-13-81 R.M. & Dist. 50	3-4-72	W.J.S.	3-1-84 R.M.P. Dist. 62	
	2-26-81 R.M.P. " 62	4-25-72	E.T.Z.	2-1-85 E.A.P. " 50	
	3-1-82 R.M.P. " 50	5-2-72	J.J.C.	2-15-85 R.M.P. " 62	
	4-23-82 R.M.P. " 62	9-5-72	J.J.C.		
	2-7-83 R.M.P. " 50	3-7-73	J.J.C.		
	5-24-83 E.A.P. " 62	2-19-74	J.J.C.		
	2-8-84 E.A.P. " 50	3-24-76	J.M.T.		

KEY MAP

170	171	172
180	181	182
190	131	192

PREPARED BY
MICHAEL BAKER, JR., INC.
CONSULTING ENGINEERS
ROCHESTER, PENNSYLVANIA

660 0 660 1320
SCALE IN FEET

BEAVER COUNTY
Pennsylvania
1957

62
50

GREENE TWP.
BOROUGH OF SHIPPINGPORT

DISTRICT NUMBERS
62-50

TAX MAP NO. 181