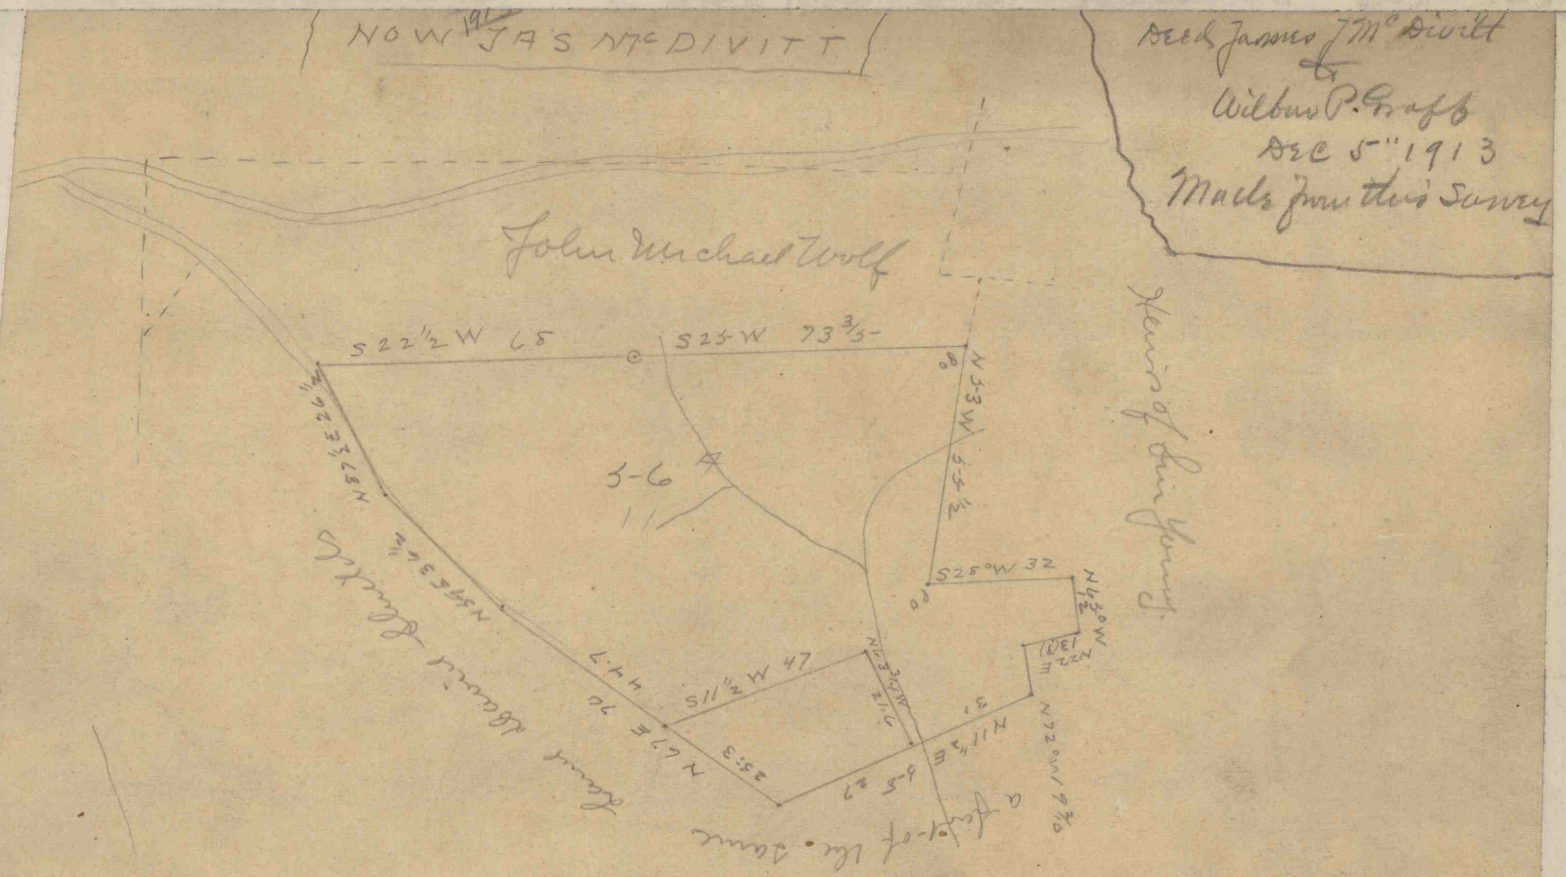

January 5th A.D. 1871 Surveyed the above 5-6 Acres Strict measure situation in Salem Township Westmoreland County State of Pennsylvania

Wm McCutchen

4311

4-4