


# EMPIRE COAL MINING

LOWER KITTANNING COAL OWNED IN FEE (15)

CLEARFIELD BITUMINOUS COAL CORPORATION

Bone included in "Section Mined" is thrown out when mined

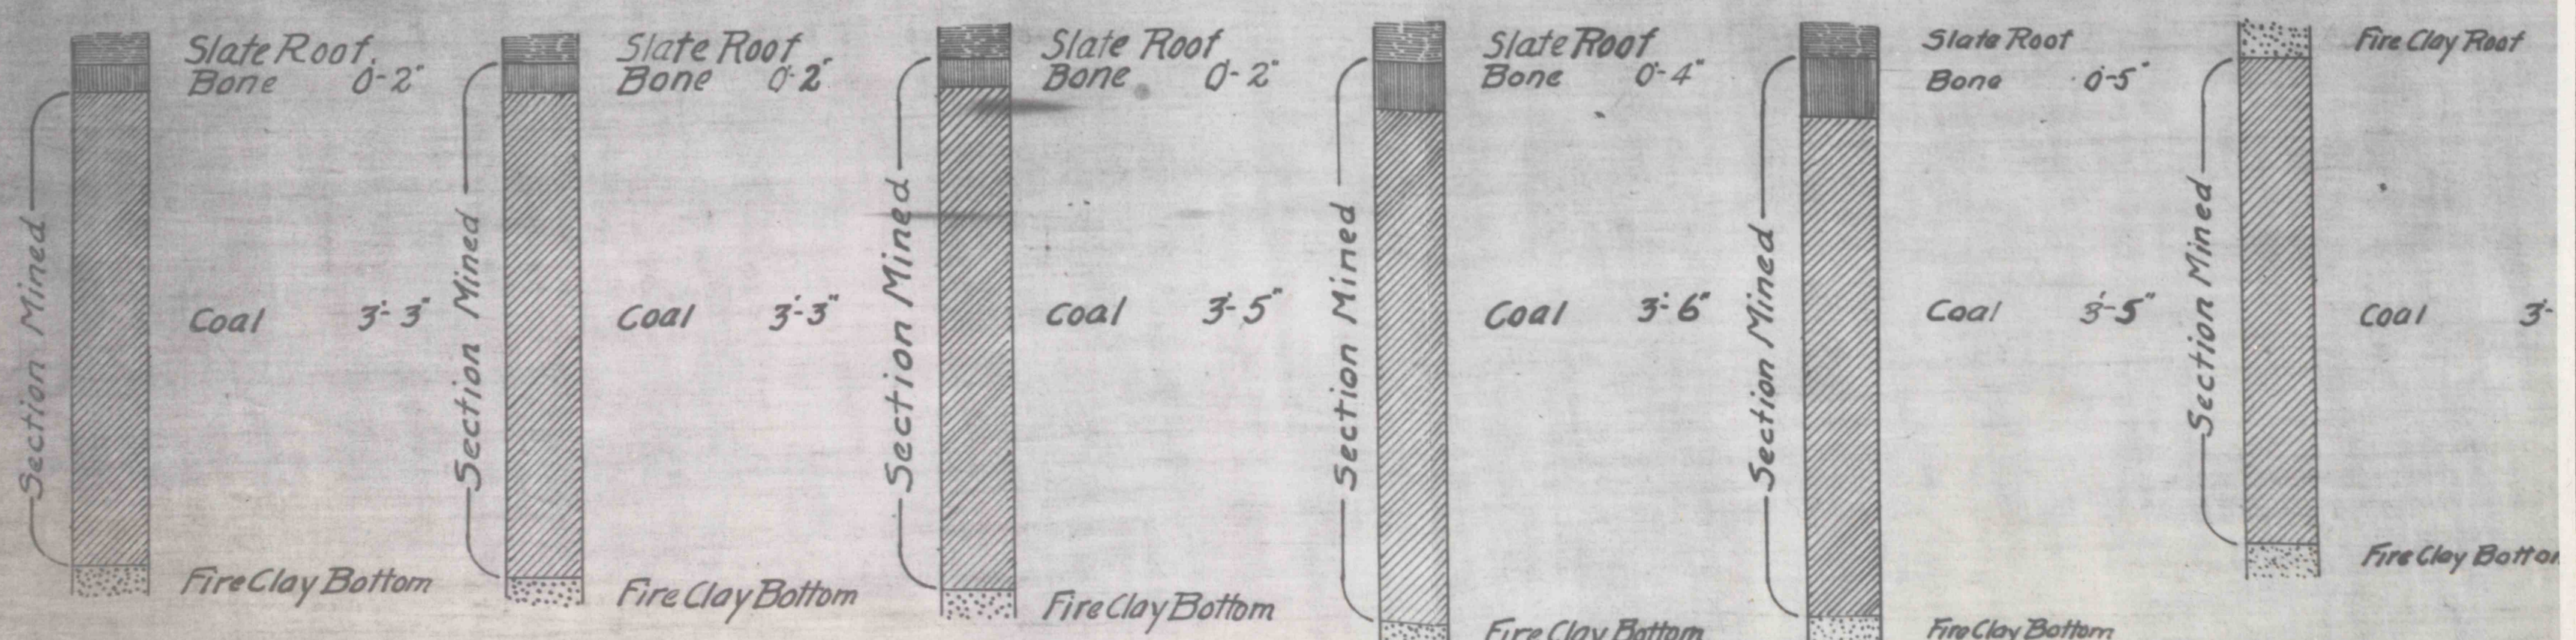

Section A Section B Section C Section D Section E Section F  
 Coal Sections of Lower Kittanning Coal on Lands owned by Empire Coal Mining Co.