


AL MINING COMPANY

COAL OWNED IN FEE (1537.07 ACRES WORKABLE)

is thrown out when mined.

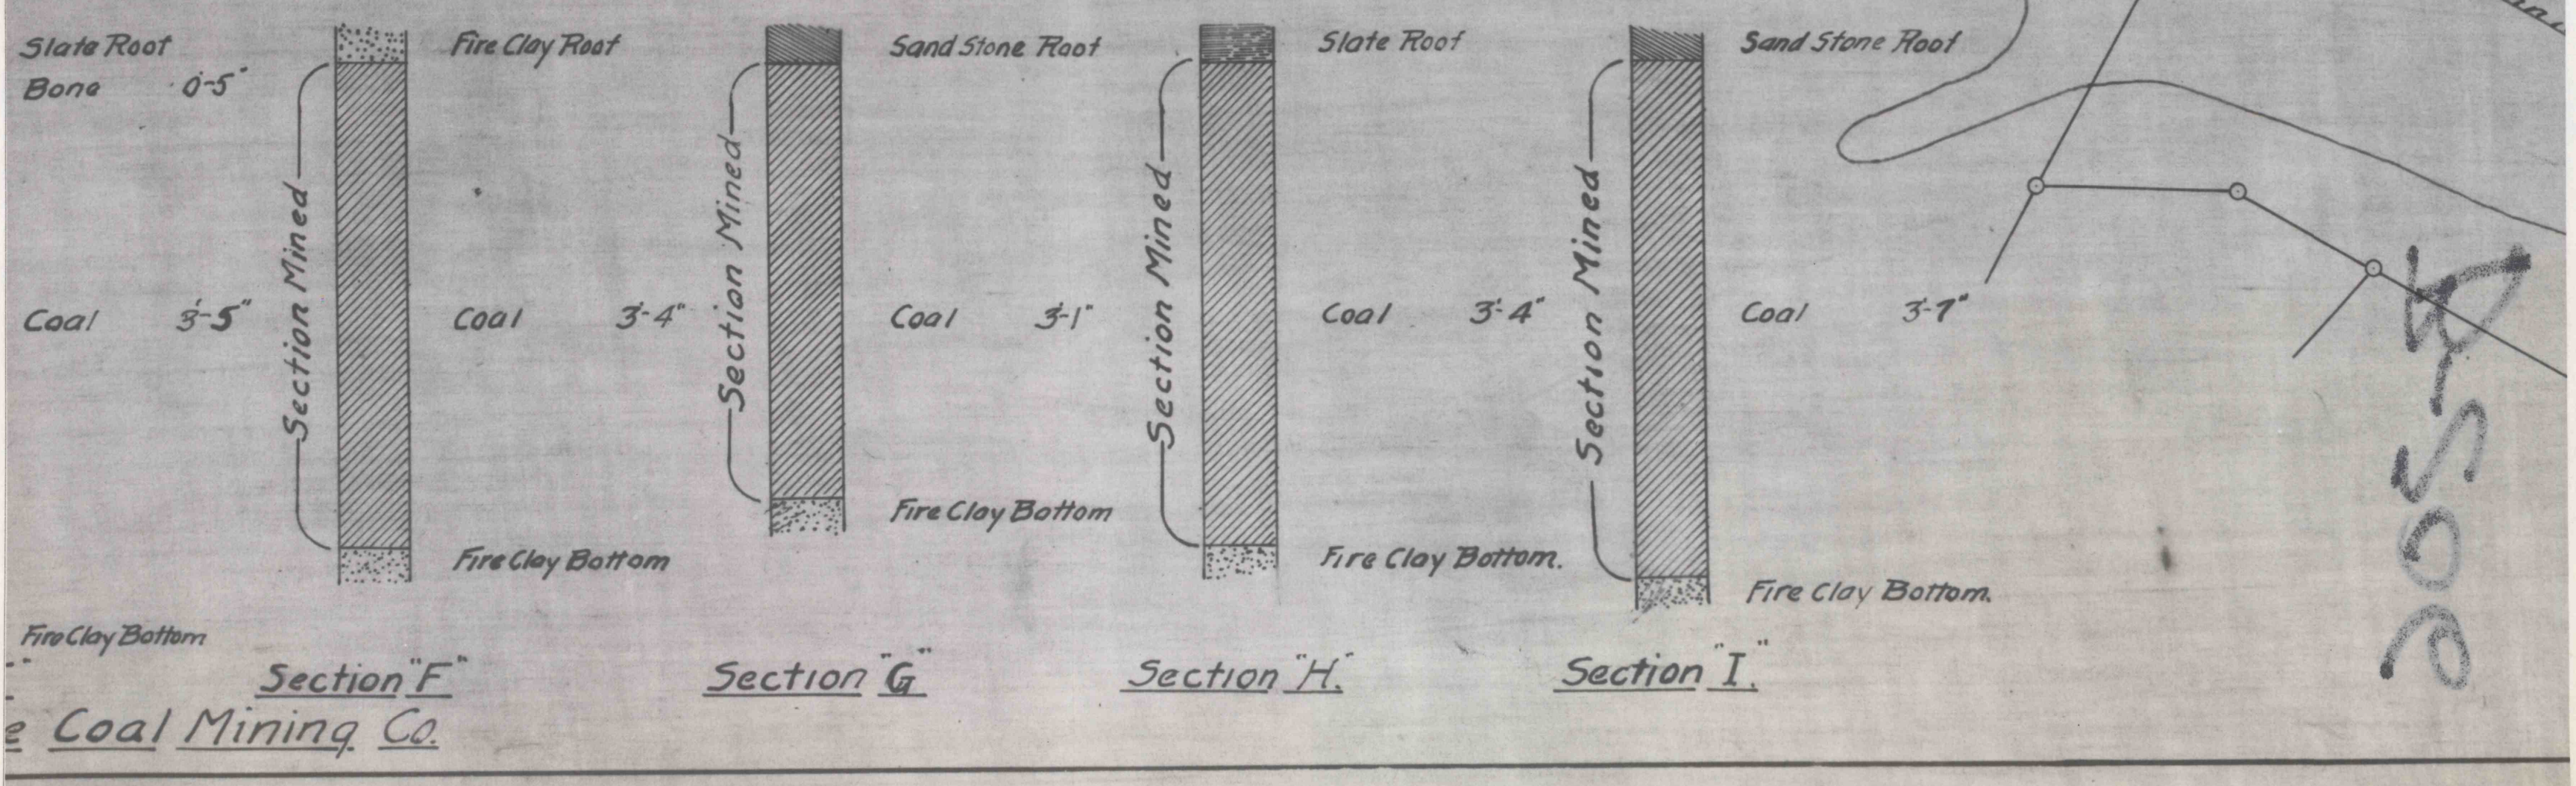

Section F  
Coal Mining Co.

Section G

Section H

Section I