


MASONTOWN QUADRANGLE

N. W. 4

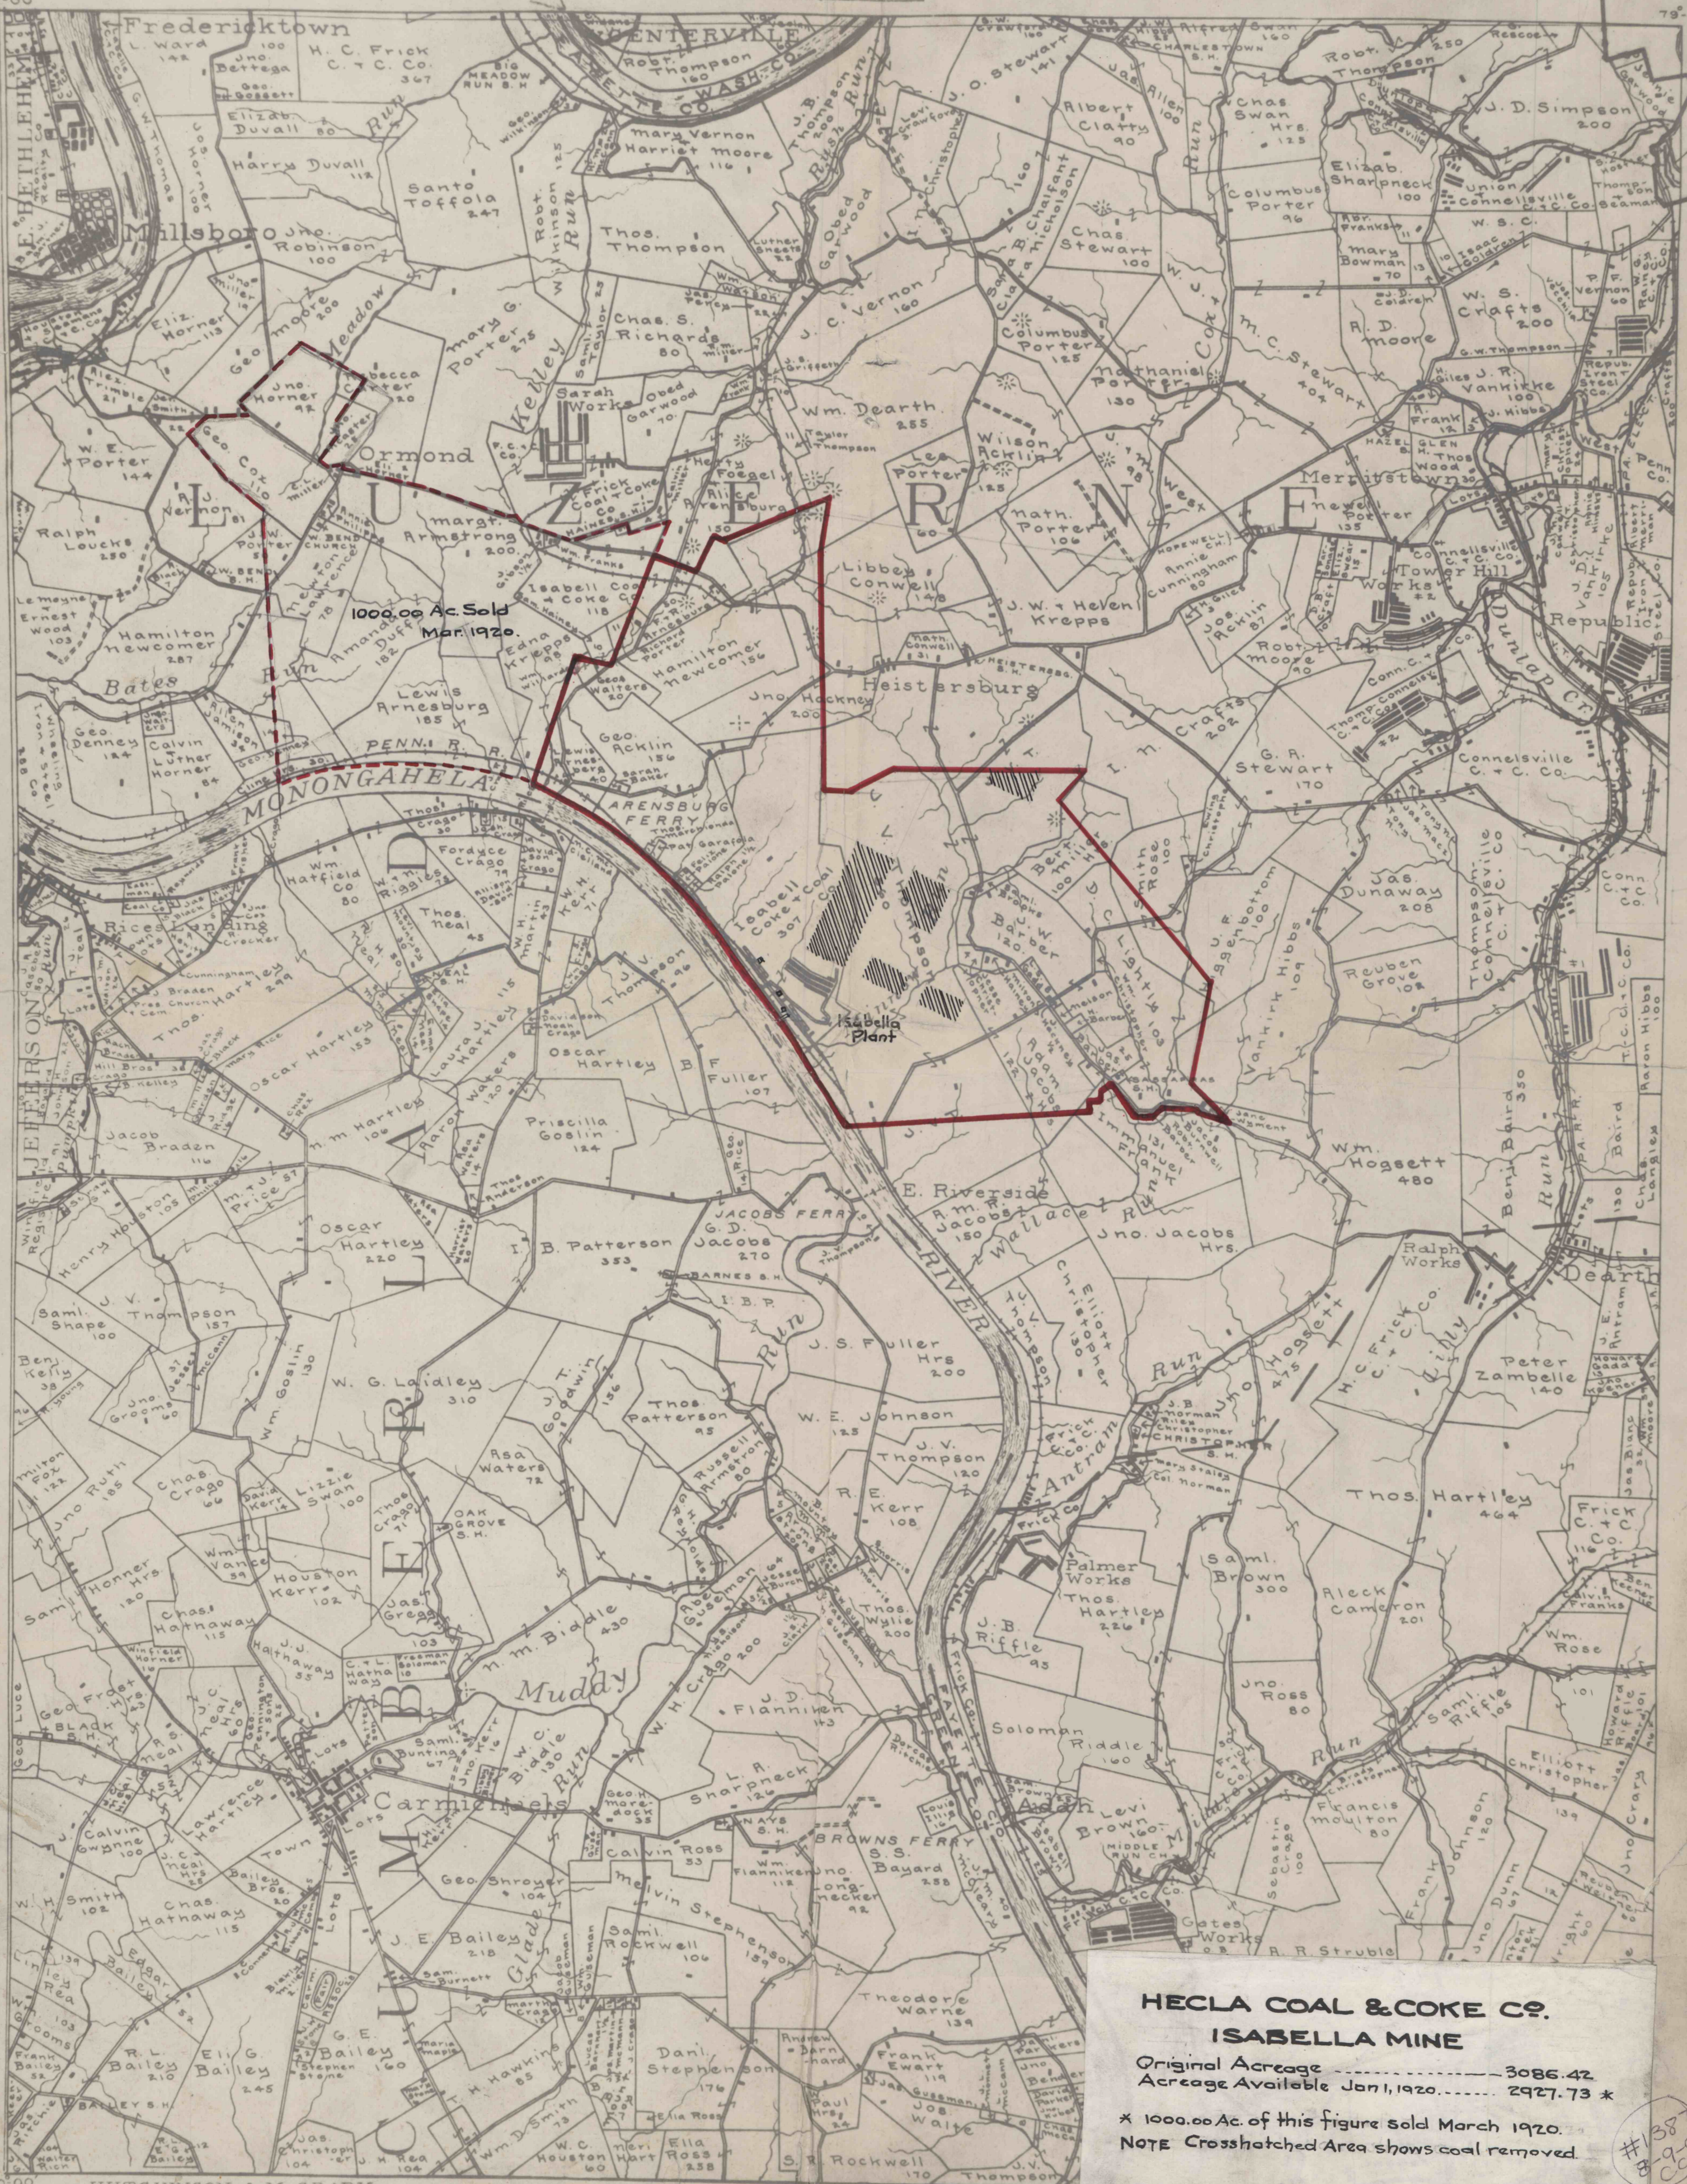

1000.00 Ac. Sold
Mar. 1920.

Isabella Plant

HECLA COAL & COKE CO.

ISABELLA MINE

Original Acreage ----- 3086.42
Acreage Available Jan 1, 1920. 2927.73 *

* 1000.00 Ac. of this figure sold March 1920.
NOTE Crosshatched Area shows coal removed.

#1387
B-9-09
CC