


PENNSYLVANIA BROWNSVILLE QUADRANGLE

S. W. 4

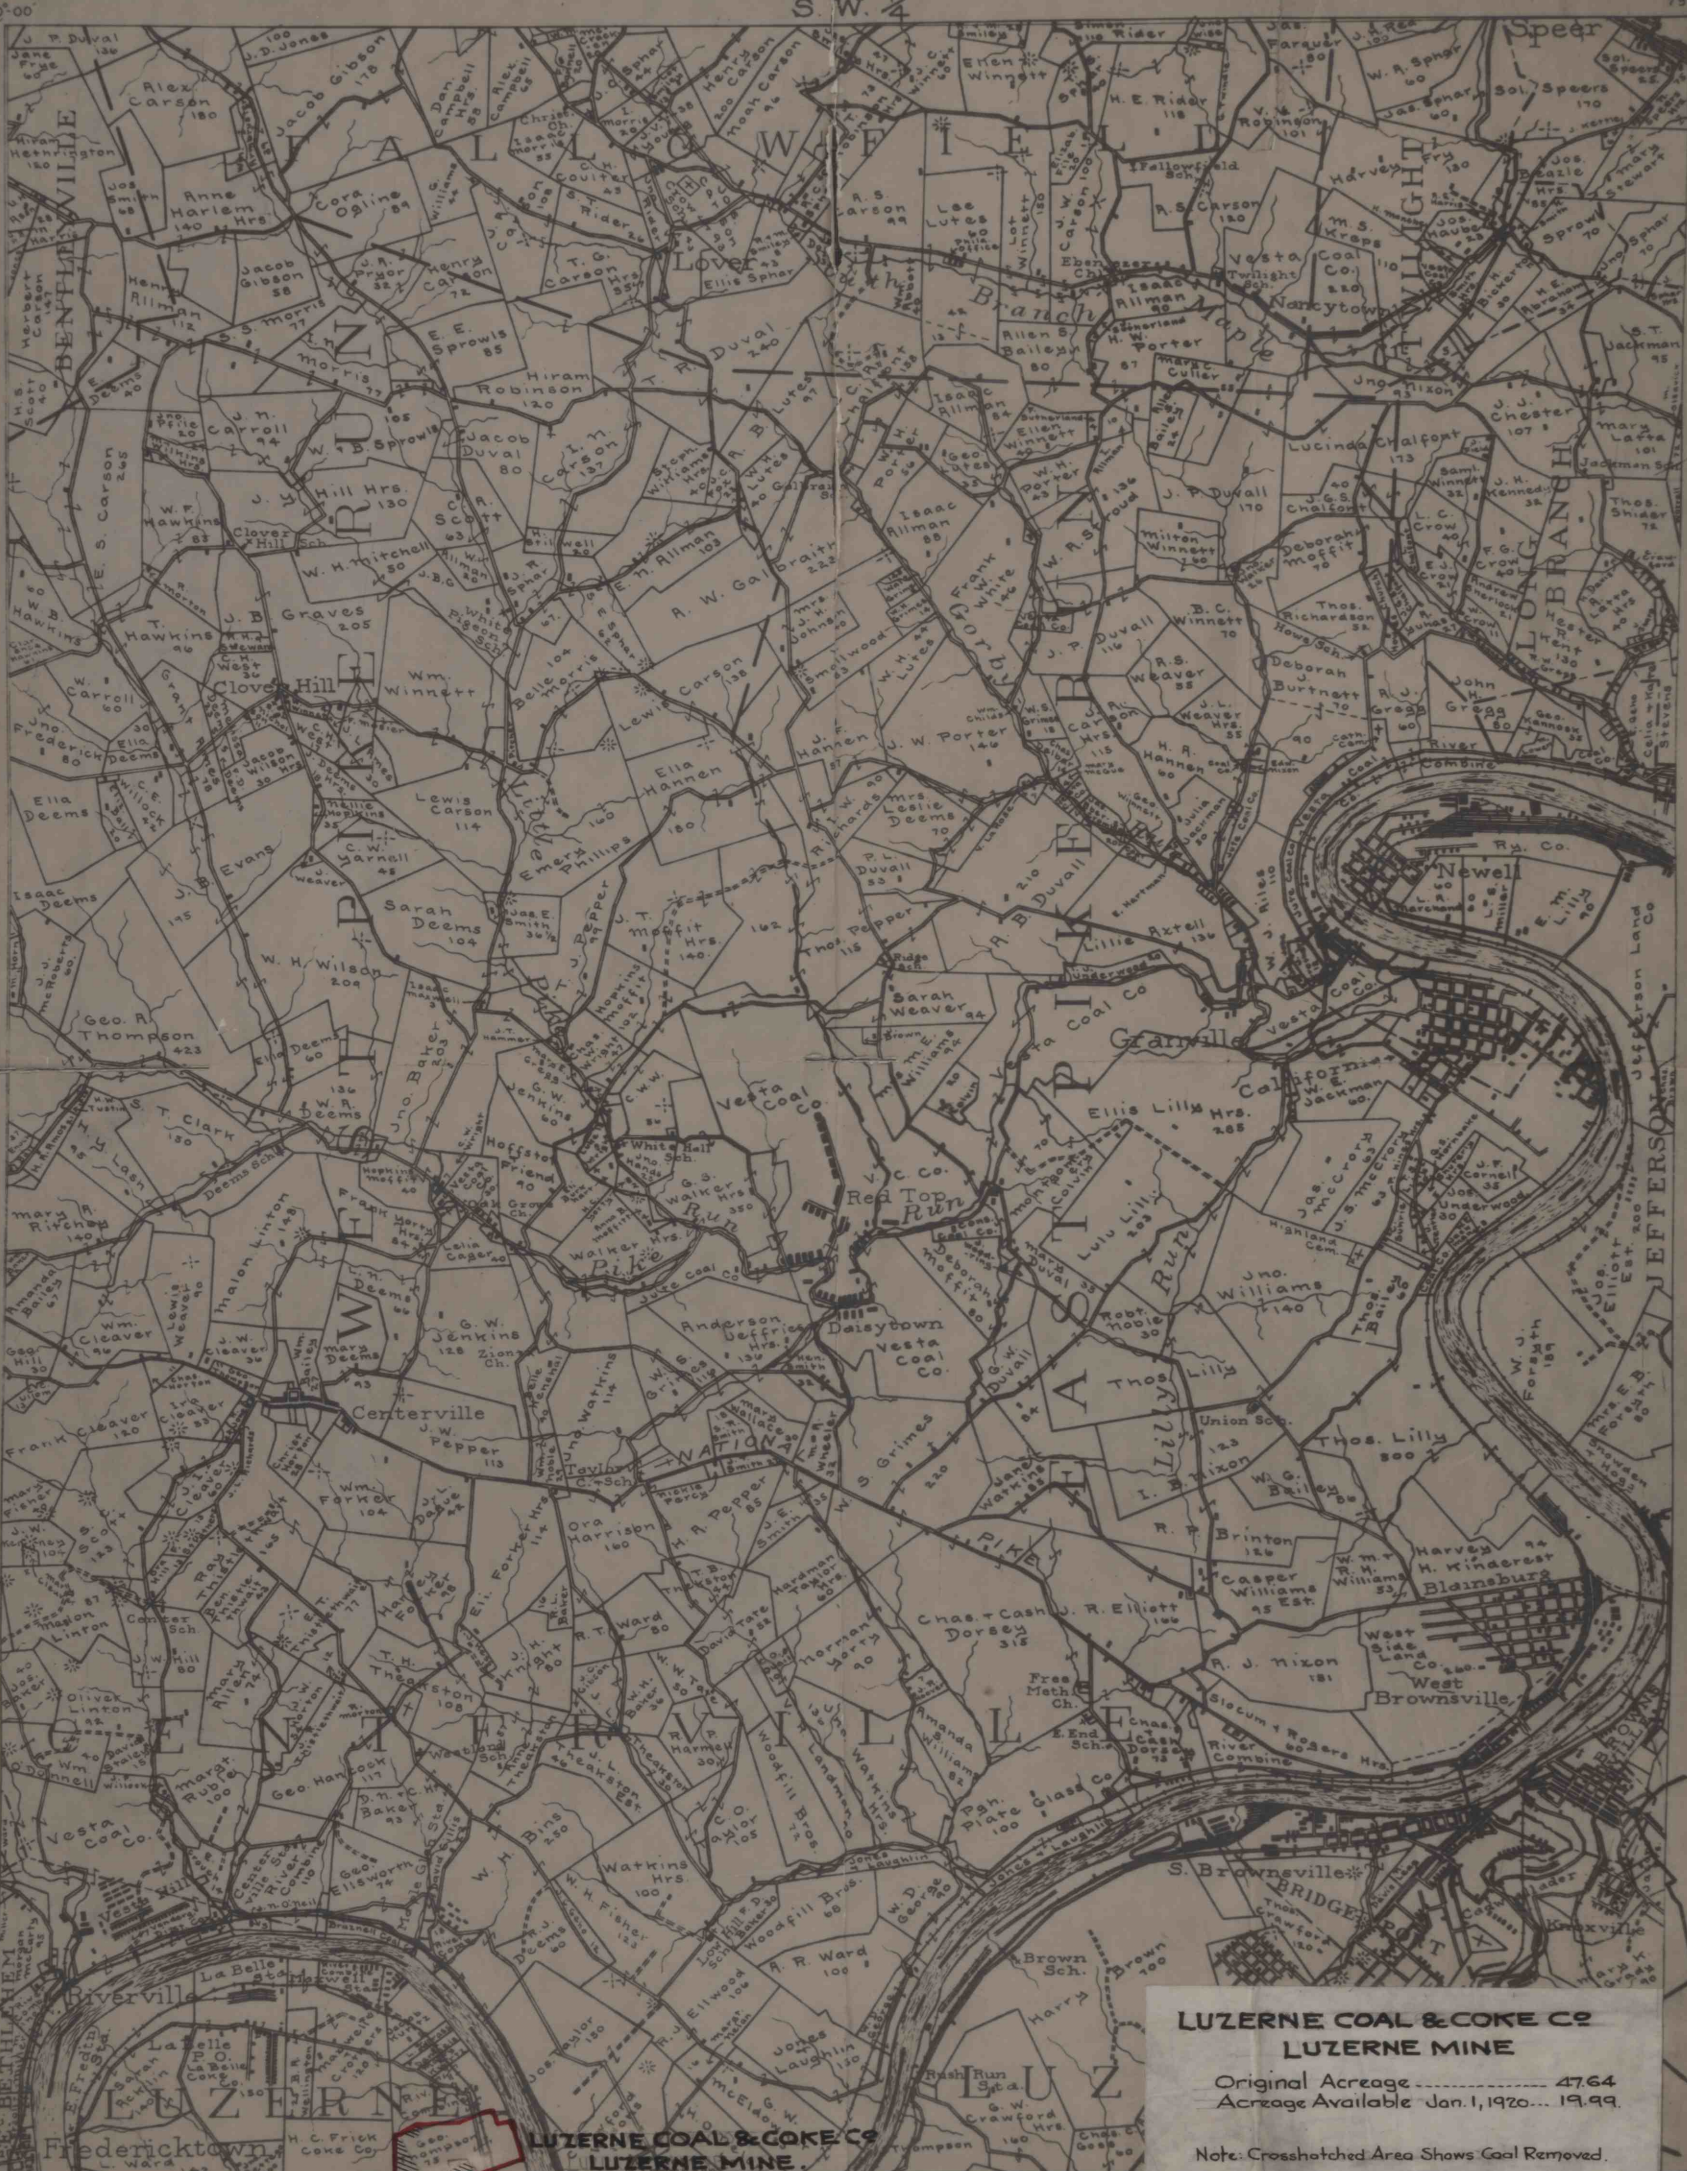

**LUZERNE COAL & COKE CO
LUZERNE MINE**

Original Acreage 47.64
Acreage Available Jan. 1, 1920... 19.99.

Note: Crosshatched Area Shows Coal Removed.