





*Ad. 6.1966*  
*BARCY MINE*  
*GEORGE SKOVAN JR.*  
*Box 215*  
*FAIRBANKS, PA 15435*  
*NO DISCHARGE*  
*F.B. GOODALL*  
*WINTON, PA*  
*IF A DISCHARGE IT WOULD*  
*BE TO AN UNNAMED CUN*  
*TRIBUTARY OF WALLACE RUN*

Mapped, edited, and published by the Geological Survey  
Under USGS, USC&GS, and USCE  
Topography by photogrammetric methods from aerial photographs  
taken 1962 and 1963. Field checked 1964  
Polyconic projection. 1927 North American datum  
10,000-foot grid based on Pennsylvania coordinate system, south zone  
1000-meter Universal Transverse Mercator grid ticks  
zone 17, shown in blue  
Fine red dashed lines indicate selected fence and field lines where  
generally visible on aerial photographs. This information is unchecked

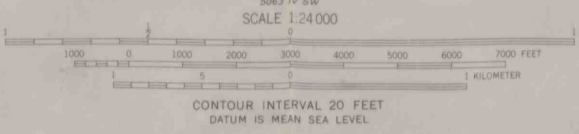

ROAD CLASSIFICATION

Heavy-duty	Light-duty
Medium-duty	Unimproved dirt
State Route	

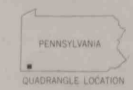

**PEN-OW-MAP COMPANY**  
PHONE 261-0845 511 MAGEE BLDG  
336 FORTY 1ST PHN 74 15291

**CARMICHAELS, PA.**  
NW/4 MASONTOWN 15 QUADRANGLE  
N3952.5-W7952.5/7.5  
1964  
AMS 5063 IV NW-SERIES V831

THIS MAP COMPLIES WITH NATIONAL MAP ACCURACY STANDARDS  
FOR SALE BY U.S. GEOLOGICAL SURVEY, WASHINGTON, D. C. 20242  
A FOLDER DESCRIBING TOPOGRAPHIC MAPS AND SYMBOLS IS AVAILABLE ON REQUEST