


CAMBRIA STEEL CO.
 363.06325A

ENGRAVED APR. 1902 BY U.S.G.S.
 H.M. Wilson, Geographer in charge.
 Triangulation by Sledge Tatum.
 Topography by A.M. Walker.
 Surveyed in 1900 in cooperation with the State of Pennsylvania.

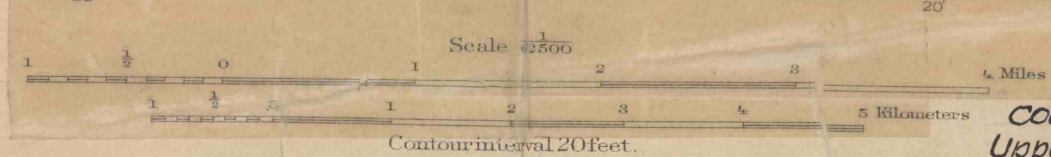

Edition of June 1902, reprinted Oct. 1907

APPROXIMATE MEAN DECLINATION 1902

Contour interval 20 feet.
 Datum is mean sea level.

CAMBRIA STEEL COMPANY.

Coal Mined out...
 Upper Freeport, E or Kelly Seam. Colored.

EVERETT
 363.063 Acres
 #439
 1-21-09