




REC'D MINES - PENN.
FEB 28 1968
BUREAU OF MINE
SUSPENSE - PENN.

Walter E. Bloch
Graff Engineering Co.
Blairsville, Pa.
Feb. 20, 1968

Tandom Coal Company
Black Beauty No. 1 Mine
322 N. 2nd Street
Apollo, Pa.

H.M. Wilson, Geographer in charge.
Triangulation by A.H. Thompson.
Topography by Frank Sutton, E.B. Clark and J.H. Wheat.

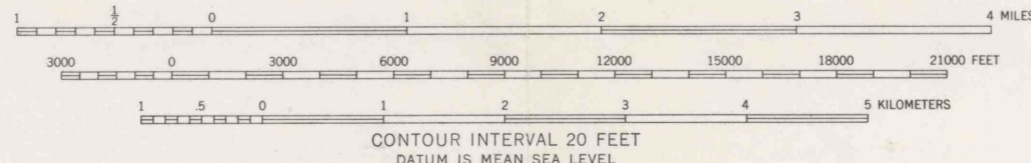

INTERIOR - GEOLOGICAL SURVEY, WASHINGTON, D. C. - 1962
MR 3382
Polyconic projection. 1927 North American datum

ELDERS RIDGE, PA.

N4030-W7915/15

1902