




July 2, 1964  
BORTZ MINE  
BORTZ COAL CO.  
63 N. BRADEN AVE  
UNIONTOWN, PA.  
WATERSHED TO  
JACOBS CREEK  
F.B. GOONBLER  
UNIONTOWN, PA.

H.M. Wilson, Geographer in charge.  
Control by S.S. Gannett, Sledge datum, and A.C. Roberts  
Topography by Frank Sutton, F.D. Cummins, and H.C. Trank Coke Co.  
Surveyed in 1899 in cooperation with the State of Pennsylvania.  
Culture in Fayette County part revised in 1930-1931 by  
J.H. Wilke and C.S. Wells.

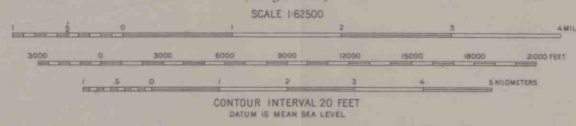

INTERIOR - GEOLOGICAL SURVEY WASHINGTON, D. C. 20541  
Polyconic projection, 1827 North American datum.

MASONTOWN, PA.  
N3948-W7946/16